

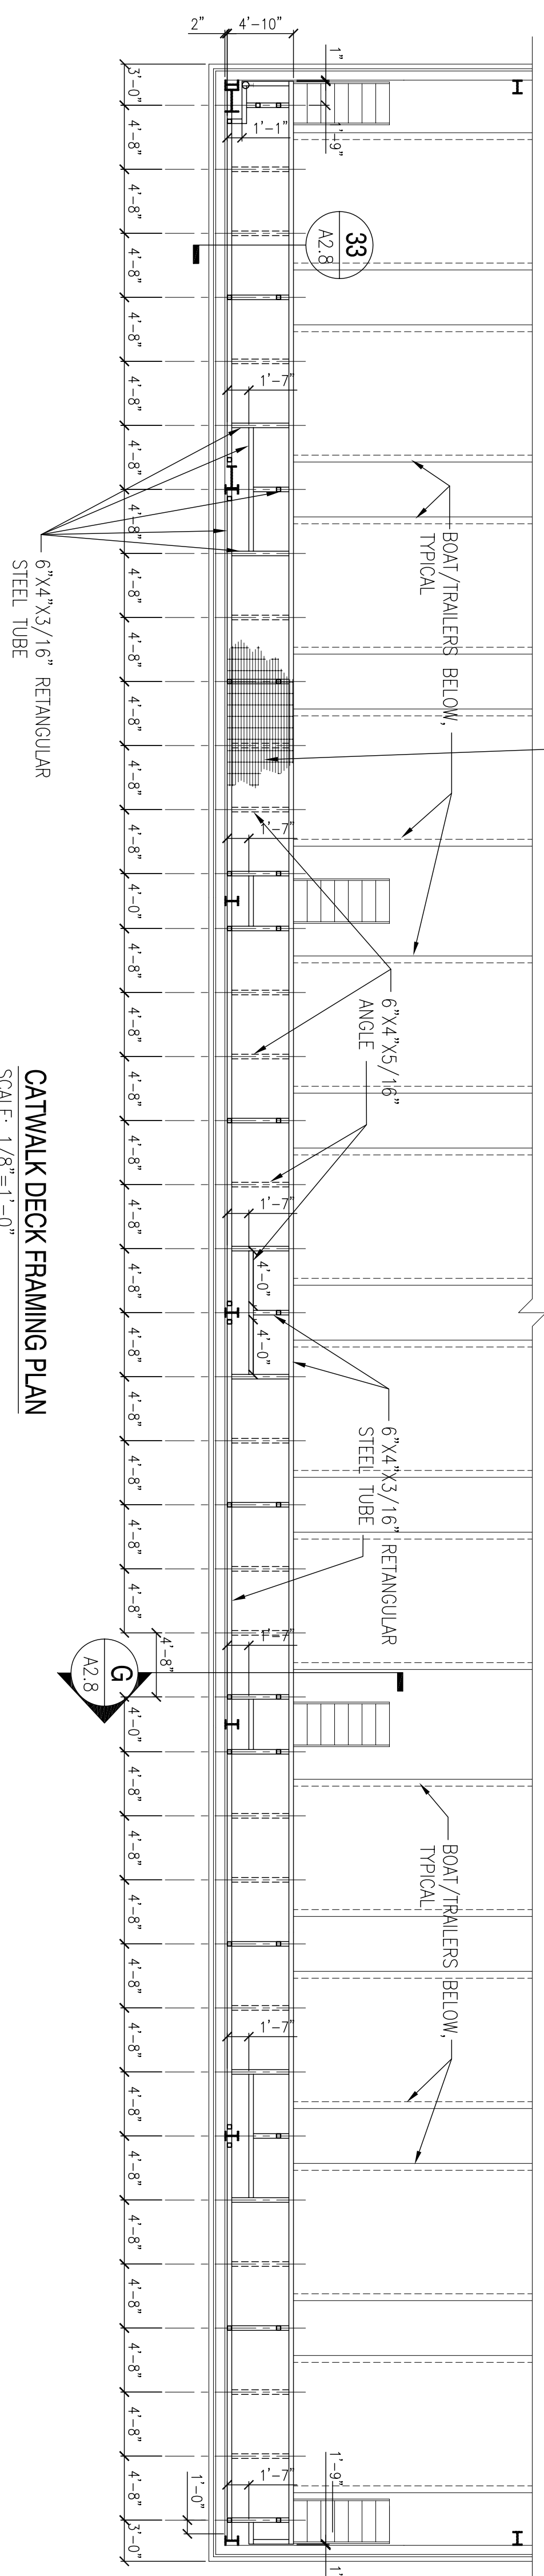


FLOOR GRATING SHALL BE LIGHT DUTY WELDED  
STL. "SERRATED" BAR GRATING  
MAXIMUM SPAN SHALL BE 6 FOOT

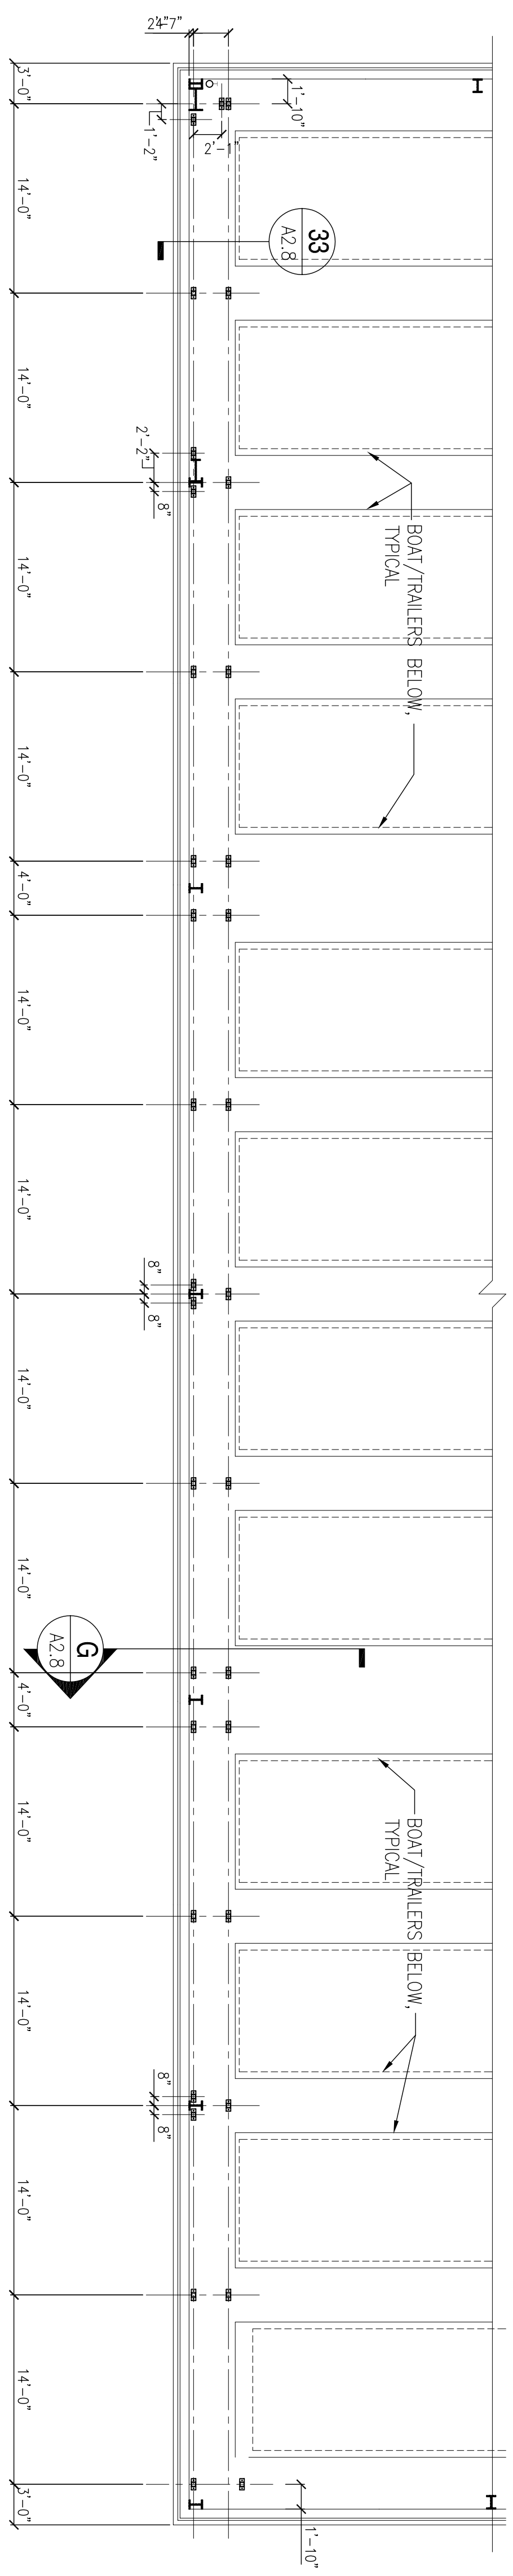

CATWALK DECK FRAMING PLAN  
SCALE: 1/8"=1'-0"

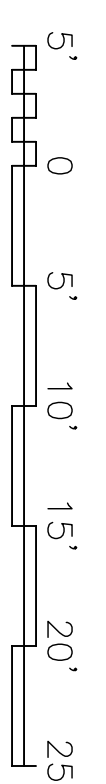

CATWALK COLUMN LAYOUT  
SCALE: 1/8"=1'-0"

RECORD DRAWING  
LETTER DATED -  
5-27-10



			DESIGNED BY: R. WILTSE DRAWN BY: J. LOOUE REVIEWED BY: R. WILTSE IN CHARGE: T. ARBIB CHECKED: E. ENGLISH, P. DAMMON DATE: SEPTEMBER 4, 2009	DEPARTMENT OF THE NAVY NAVAL FACILITIES ENGINEERING COMMAND SOUTHEAST NAVAL AIR STATION JACKSONVILLE JOHN C. STENNIS SPACE CENTER MISSISSIPPI <b>SOF RIVERINE AND COMBATANT CRAFT OPERATIONS FACILITY - PRE-FINAL</b> <b>BOAT STORAGE BLDG. 2442 CATWALK FRAMING PLAN</b>	AS-BUILT 4-27-10 RW
SCALE: AS SHOWN DRAWING NO.: P-210 STA. PROJ. NO.: S10247 WORK ORDER NO.: N62467-05-0-0096 CONSTR. CENTER NO.: 15026723 NAVFAC DRAWING NO.: 76 OF 132	CODE ID: NO. N4412 SIZE: 0	SHEET: S22	DRAWING REVISION: 01 JAN 2009		