



5x5 LEVEL LANDING DETAIL
 1" = 1'-0"
 A1.2
 7

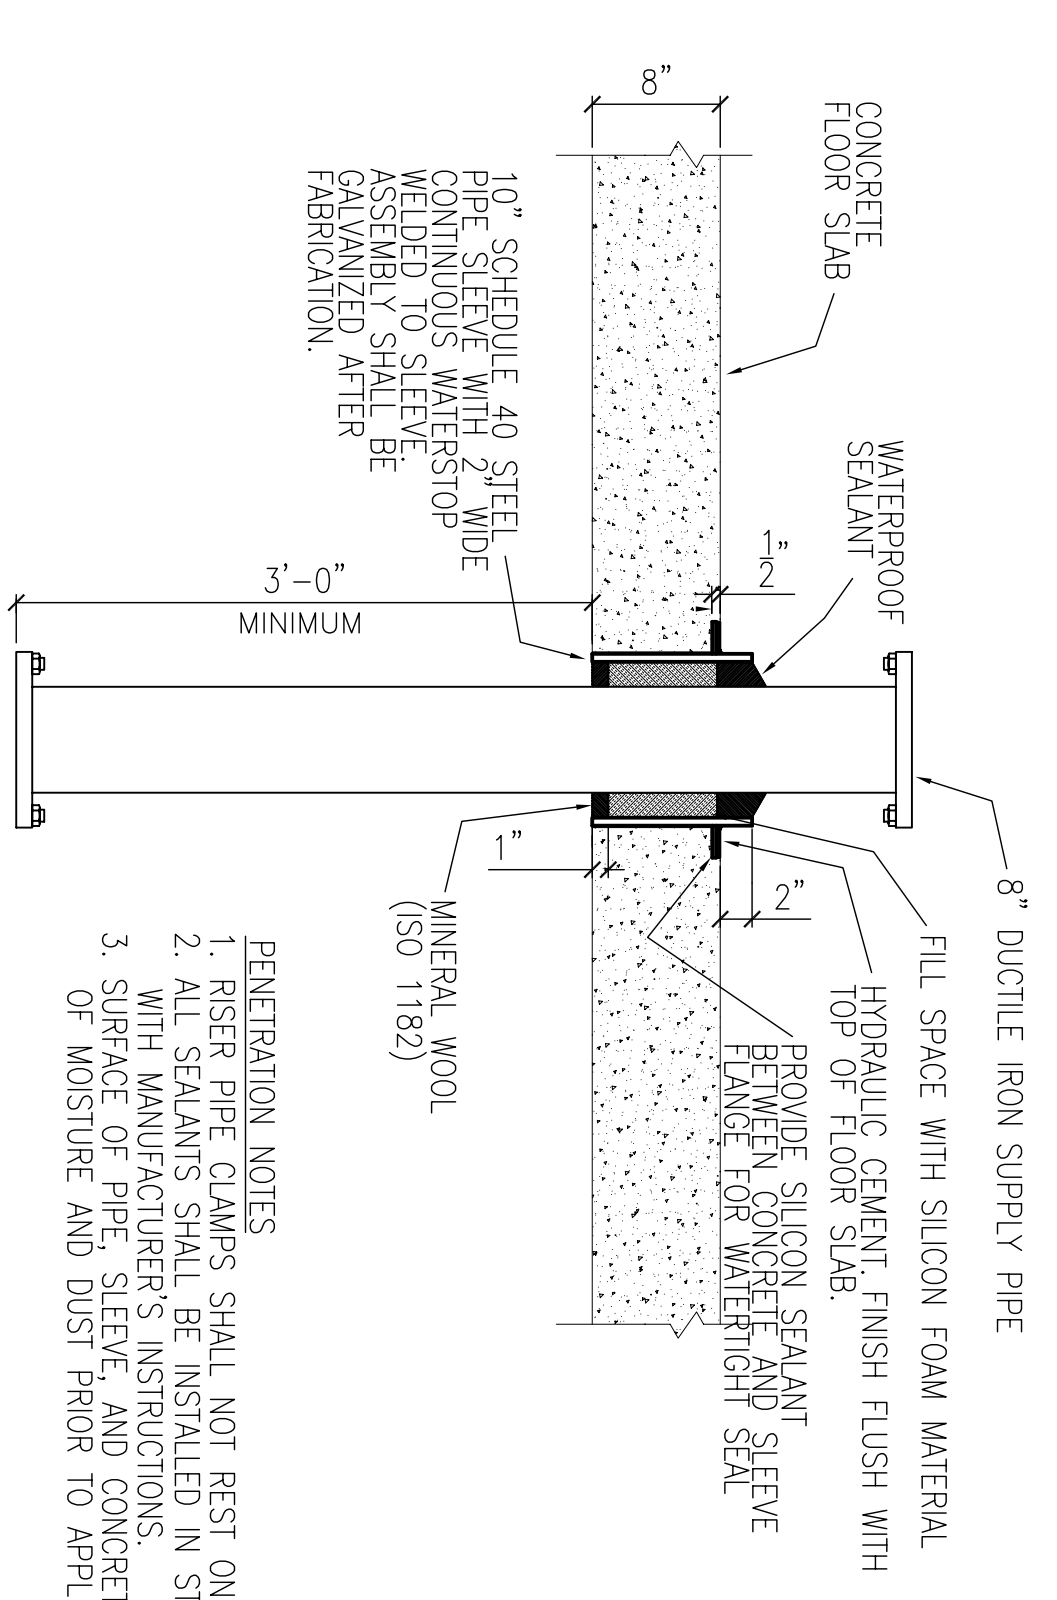

**SPRINKLER RISER
 6" FLOOR PENETRATION DETAIL**
 1" = 1'-0"
 C6.1
 8


- PENETRATION NOTES**
1. RISER PIPE CLAMPS SHALL NOT REST ON TOP OF SLEEVE.
 2. ALL SEALANTS SHALL BE INSTALLED IN STRICT ACCORDANCE WITH MANUFACTURER'S INSTRUCTIONS.
 3. SURFACE OF PIPE, SLEEVE, AND CONCRETE SHALL BE FREE OF MOISTURE AND DUST PRIOR TO APPLICATION OF SEALANT.

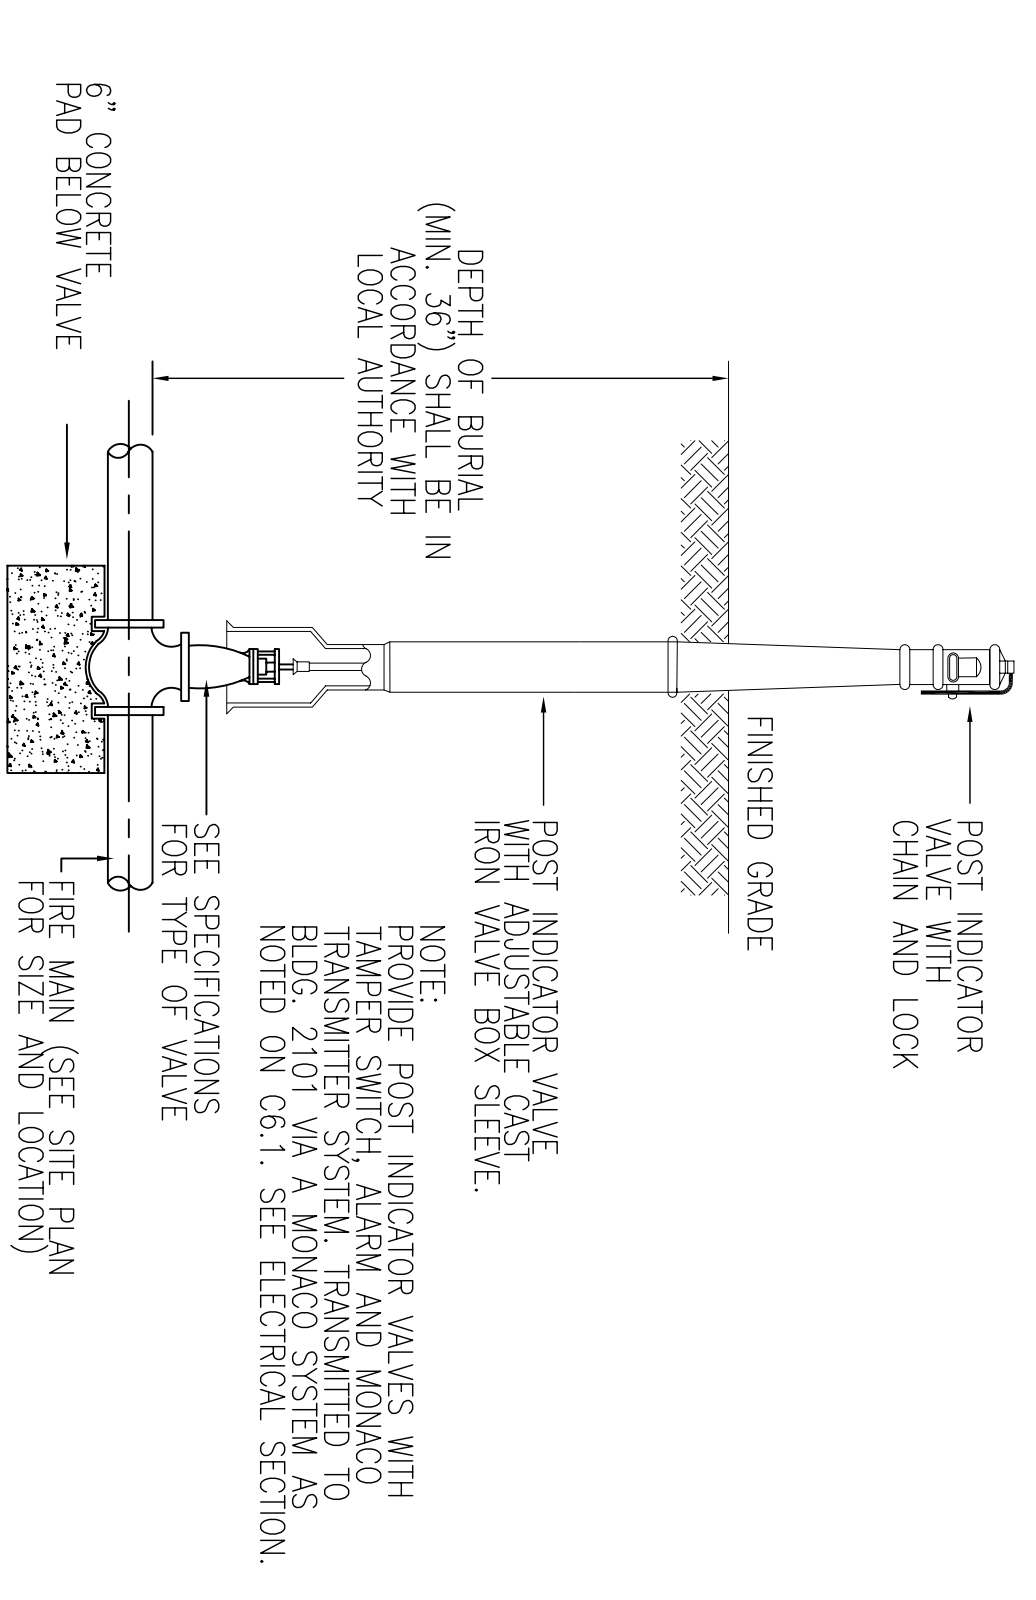


POST INDICATOR VALVE W/ VALVE BOX DETAIL
 1" = 1'-0"
 C6.1
 9

6, 5/8" x 8' GROUND RODS
 LOCATED ONE FOOT IN EACH
 CORNER OF FOUNDATION

#4 BARS, 12" O.C. EACH WAY
 SUPPORTED ON GALVANIZED CHAIRS

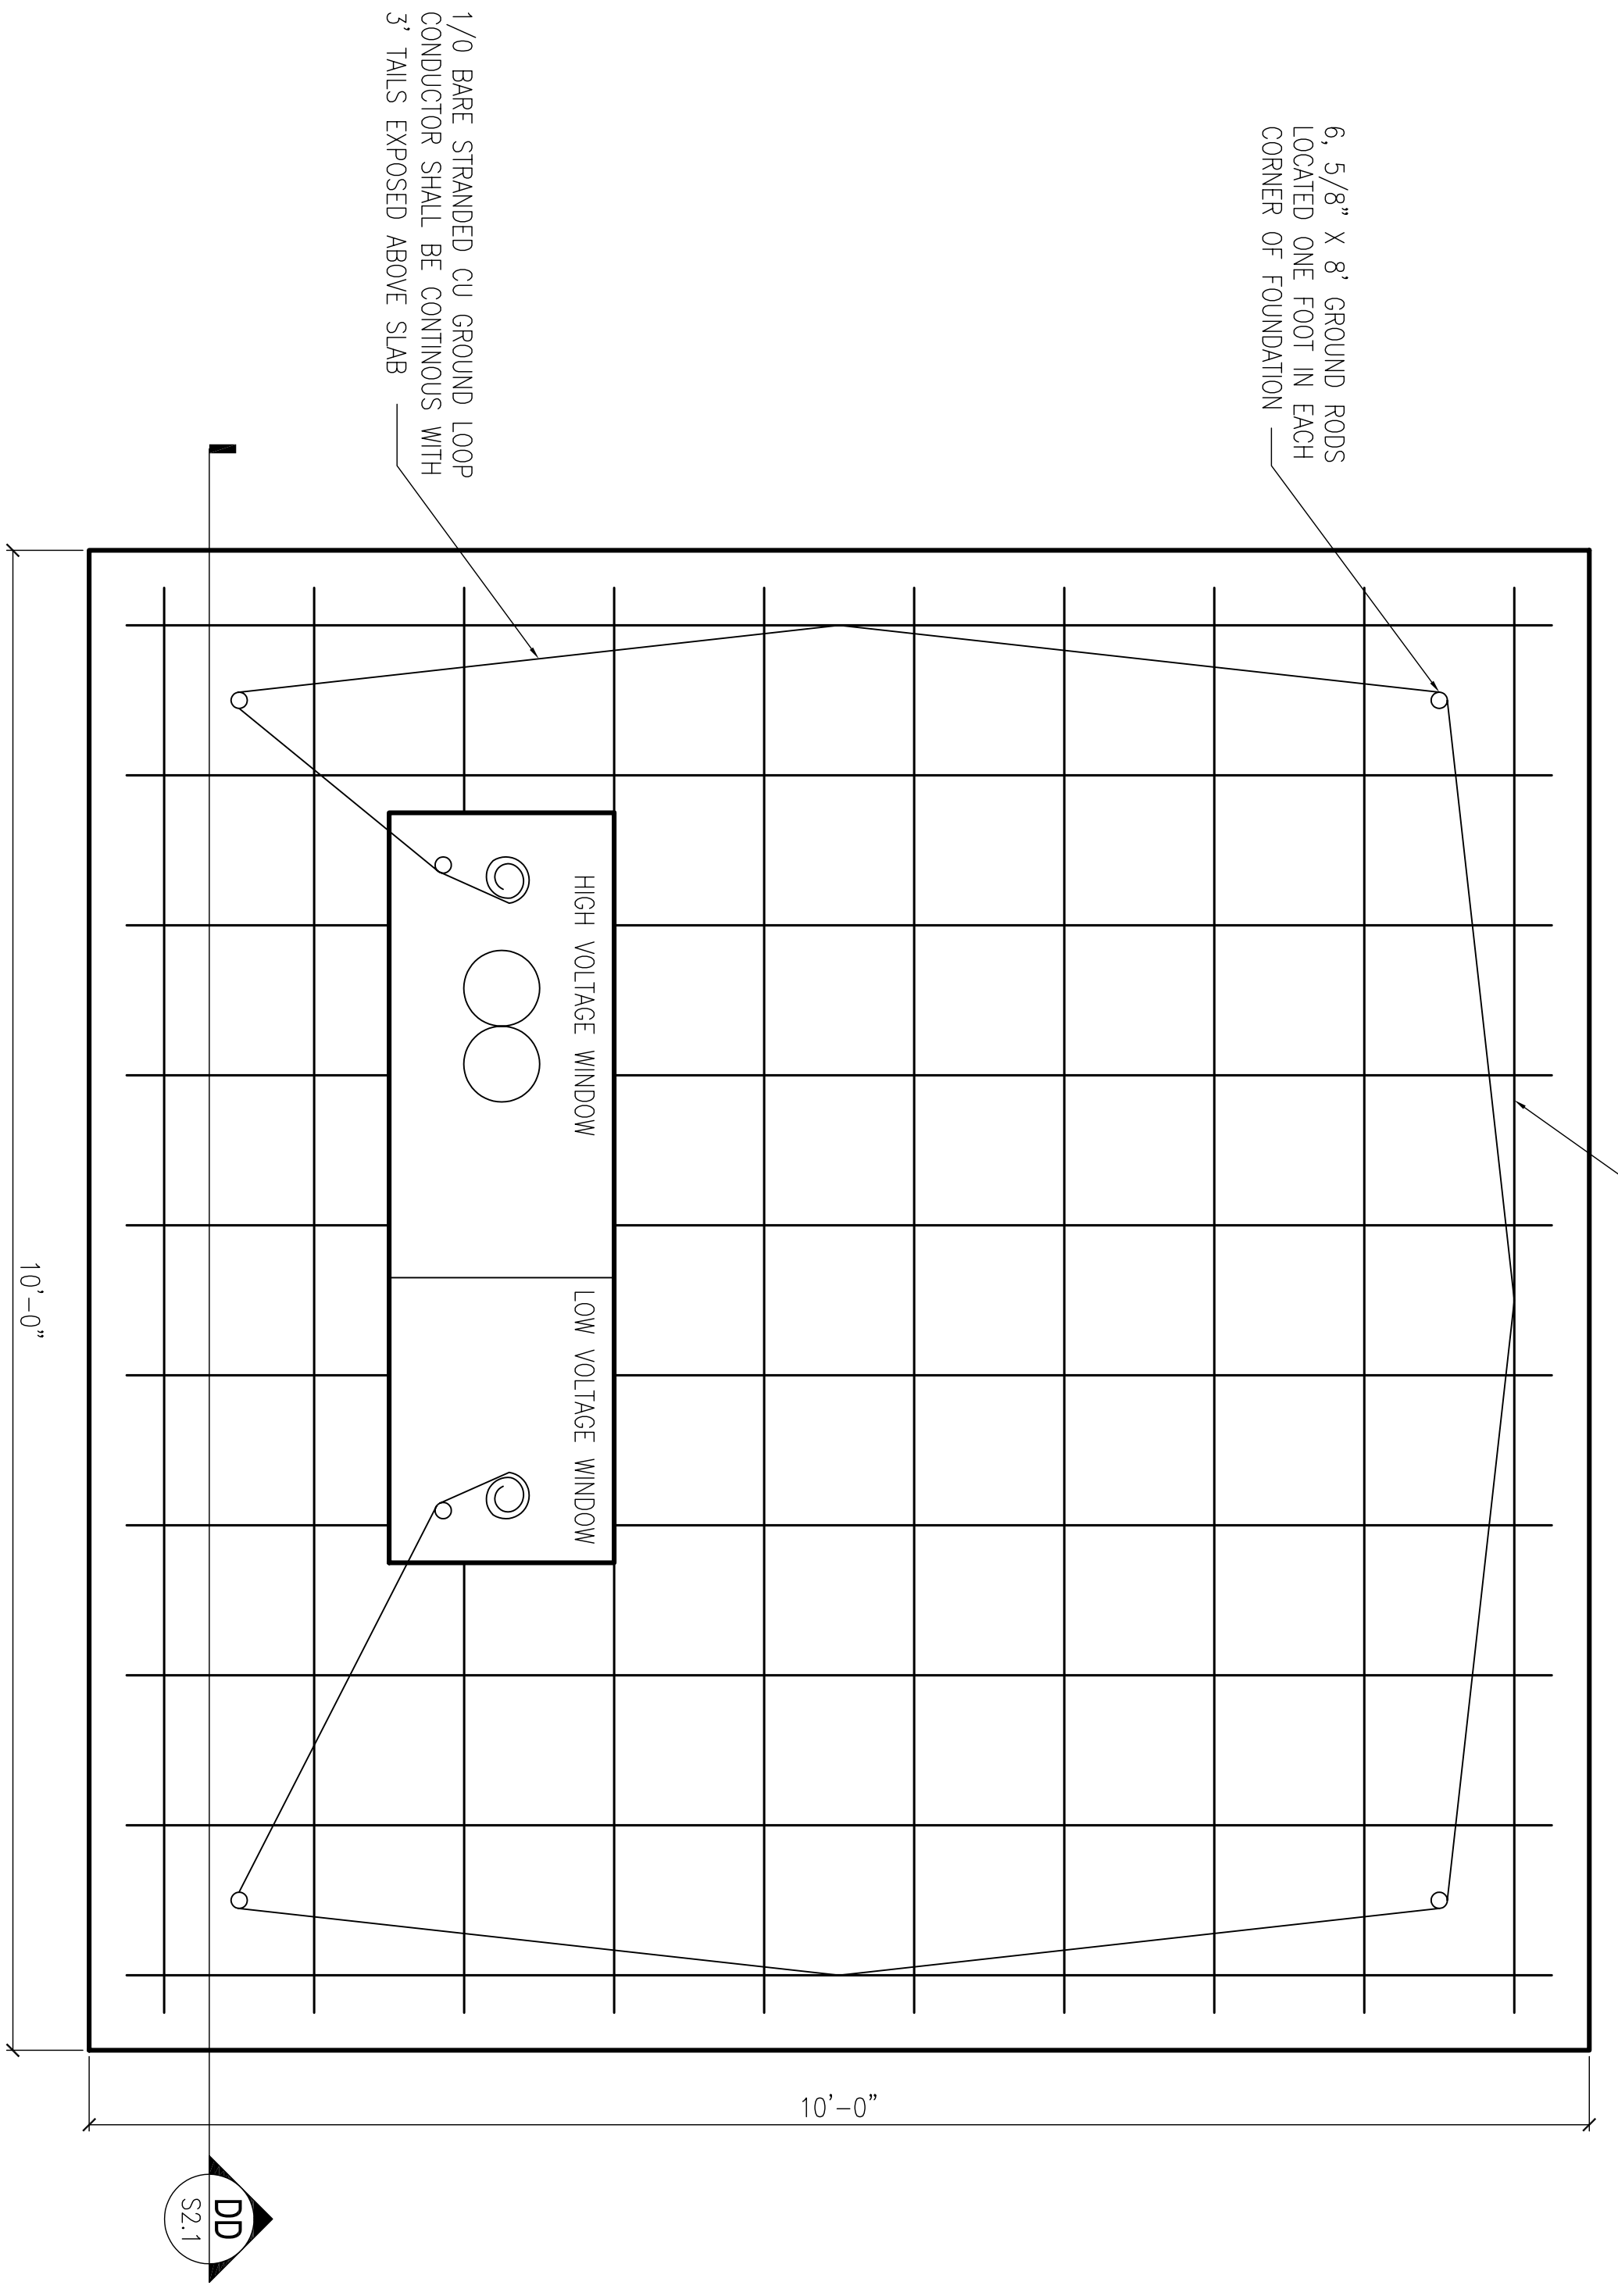

10x10 TRANSFORMER FOUNDATION
 1" = 1'-0"
 C1.1
 10

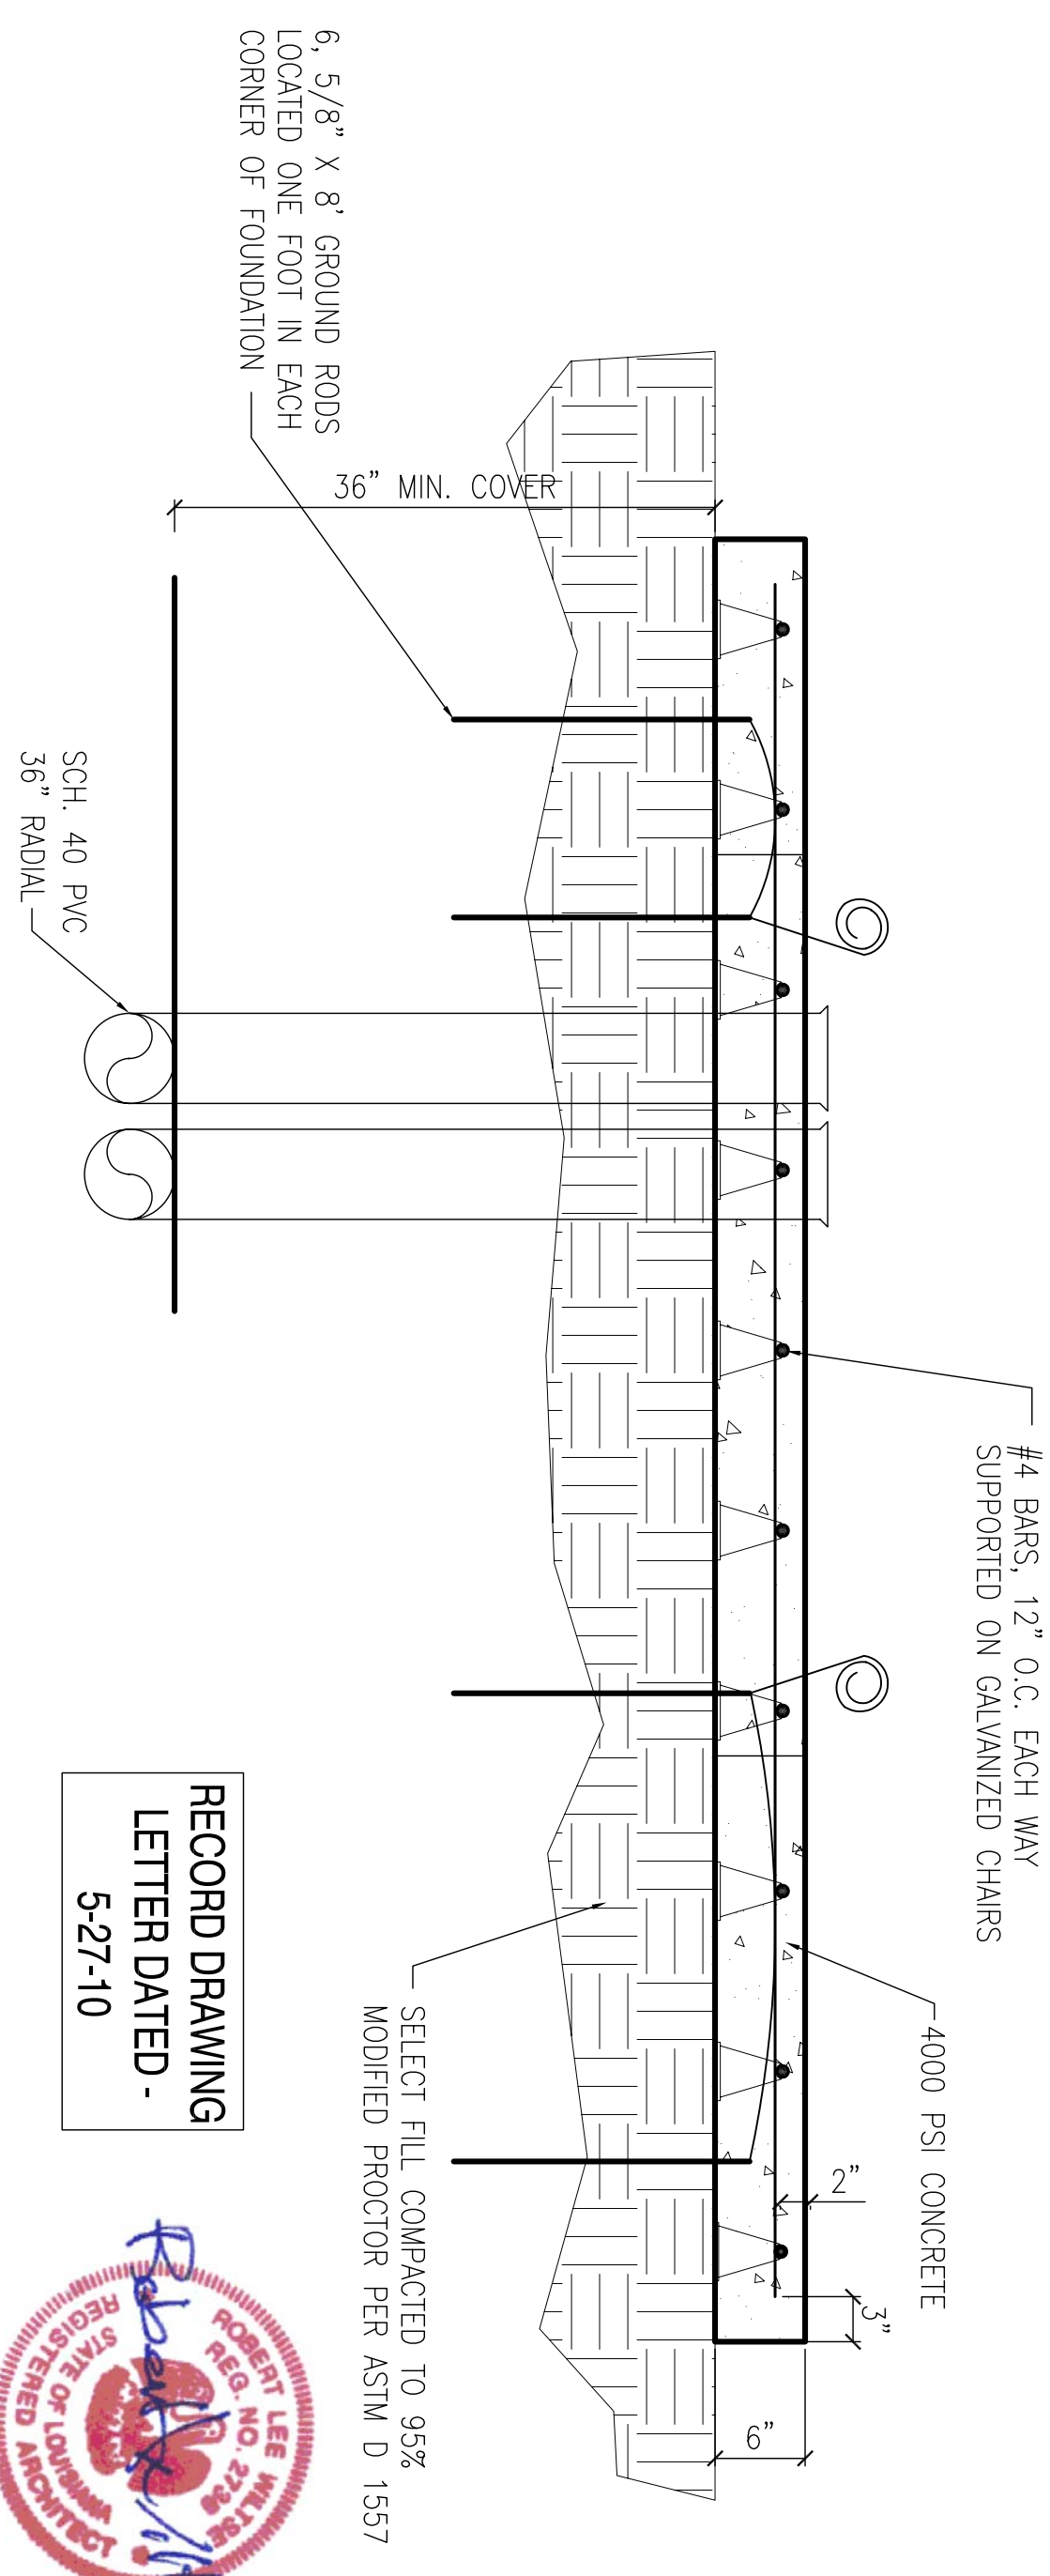

TRANSFORMER SECTION
 1" = 1'-0"
 S4.1
 DD

**RECORD DRAWING
 LETTER DATED -
 5-27-10**



REVDATE:

1 2 3 4 5

SYM	DESCRIPTION	DATE	APPR
	AS-BUILT	4-27-10	RW
	REVISED FOR FINAL	12-7-09	RW
	REVISED AS PER URS COMMENTS 9 OCTOBER 2009	11-6-09	RW

NAVFAC 	DAMMON ENGINEERING, INC. CIVIL ENGINEER 1000 PINEWOOD DRIVE DAWSON, LA 70604 (985) 649-4332 (985) 649-4332 5/2009
-------------------	-----------------------------------------------------------------------------------------------------------------------------------------------

DES: C. DAMMON DRW: C. DAMMON CHECKED BY: R. WILSON PLOT/IN: T. JARRIS CHIEF ENGINEER: P. DAMMON	DEPARTMENT OF THE NAVY NAVAL FACILITIES ENGINEERING COMMAND NAVAL AIR STATION JACKSONVILLE MISSISSIPPI JOHN C. STENNIS SPACE CENTER SOF RIVERINE AND COMBATANT CRAFT OPERATIONS FACILITY - PRE-FINAL STRUCTURAL DETAILS
-------------------------------------------------------------------------------------------------------------	---------------------------------------------------------------------------------------------------------------------------------------------------------------------------------------------------------------------------------------------------------------

CODE ID: NO. N4412 SIZE: D SCALE: AS SHOWN DRAWING NO.: ##### STA. PROJ. NO.: P-210 WORK ORDER NO.: 510247 CONSTR. CONTR. NO.: N62467-05-0-0096 NAVFAC DRAWING NO.: 15026728 SHEET: 81 OF 132	S4.1
----------------------------------------------------------------------------------------------------------------------------------------------------------------------------------------------------------------------	-------------