


OPERATIONS BUILDING SECOND FLOOR HVAC PLAN
SCALE: 3/32"=1'-0"



DAMIEN W. SERAUSKAS, P.E.
PROFESSIONAL ENGINEERING SERVICES
15 CYPRESS POINT LANE NEW ORLEANS, LA 70131
VOICE: (504)866-2600 FAX: (504)2188480

SYM	DESCRIPTION	DATE	APPR
1	AS-BUILT CONDITIONS SHOWN	06/10/2010	DWS
		06/10/2010	DWS

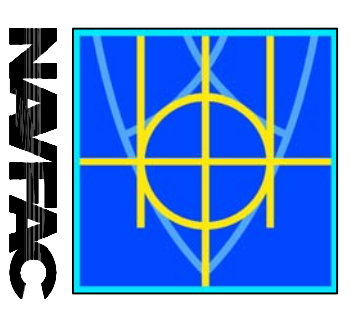

DAMMON
ENGINEERING, INC.
REGISTERED PROFESSIONAL ENGINEER
1095 FLORIDA AVENUE
SUITE 101
SLIDELL, LA 70458
(985) 649-3832

REVIEWED BY: R. WILFIRE
P.N./D.W. T. ARTHUR
CHIEF ENGINEER/ARCH. R. DAMMON
5/24/10

DEPARTMENT OF THE NAVY
NAVAL FACILITIES ENGINEERING COMMAND
NAVAL FACILITIES ENGINEERING COMMAND SOUTHEAST
IPT GULF COAST
NAVAL AIR STATION JACKSONVILLE
MISSISSIPPI
JOHN C. STENNIS SPACE CENTER
**SOF RIVERINE AND COMBATANT
CRAFT OPERATIONS FACILITY - PRE-FINAL**
OPERATIONS BLDG 2ND FLOOR HVAC PLAN

CODE ID: NO. N4412 SIZE: 0
SCALE: AS SHOWN
DRAWING NO. #####
STA. PROJ. NO. P-2710
WORK ORDER NO. 510247
CONSTR. CONTR. NO. N62467-05-D-0096
NAVFAC DRAWING NO. 15026733
SHEET 66 OF 132
M1.2