

ROUTE NEW 1-1/4" CW PIPING BELOW  
 SLOPE AND TURN UP INTO EXISTING  
 SLOPE AND TURN UP INTO EXISTING  
 WHERE SHOWN. COORDINATE SLOPE  
 REQUIREMENTS AND SLAB / BEAM  
 PENETRATIONS WITH STRUCTURAL  
 ENGINEER.


1-1/4" CW MAIN  
 BUILDING VALVE.  
 REDUCE TO 1" CW

**BOAT STORAGE BUILDING PLUMBING PLAN**  
 SCALE: 3/8"=1'-0"



**DAMIEN W. SERAUSKAS, P.E.**  
 PROFESSIONAL ENGINEERING SERVICES  
 15 CYPRESS POINT LANE NEW ORLEANS, LA 70131  
 VOICE: (504)866-2600 FAX: (504)218-9480

SYM	DESCRIPTION	DATE	APPR
1	RECORD DRAWING	06/10/2010	DWS
	AS-BUILT CONDITIONS SHOWN	06/10/2010	DWS

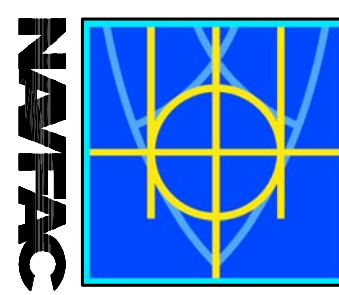

**DAMMON**  
 ENGINEERING, INC.  
 1500 PINEVIEW DRIVE  
 SUITE 100  
 SLIDERS LA 70565  
 (980) 649-3832

APPROVED BY: R. WINTSE  
 PUN/COM: I. ARTHUR  
 CHIEF ENG/ARCH: P. DAMON

DEPARTMENT OF THE NAVY  
 NAVAL FACILITIES ENGINEERING COMMAND  
 NAVAL FACILITIES ENGINEERING COMMAND SOUTHEAST  
 NAVAL AIR STATION JACKSONVILLE  
 JOHN C. STENNIS SPACE CENTER MISSISSIPPI  
**SOF RIVERINE AND COMBATANT  
 CRAFT OPERATIONS FACILITY - PRE-FINAL**  
**BOAT STORAGE BUILDING PLUMBING PLAN**

PROJECT NO. 14412 | SHEET 0  
 SCALE: AS SHOWN  
 DRAWING NO. 11111111  
 TITLE: BOAT STORAGE BUILDING PLUMBING PLAN  
 WORK ORDER NO. 110247  
 CONSTRUCTION NO. 102407-05-0-0096  
 NAVFAC DRAWING NO. 13026744  
 SHEET 97 OF 132  
**P2.1**