

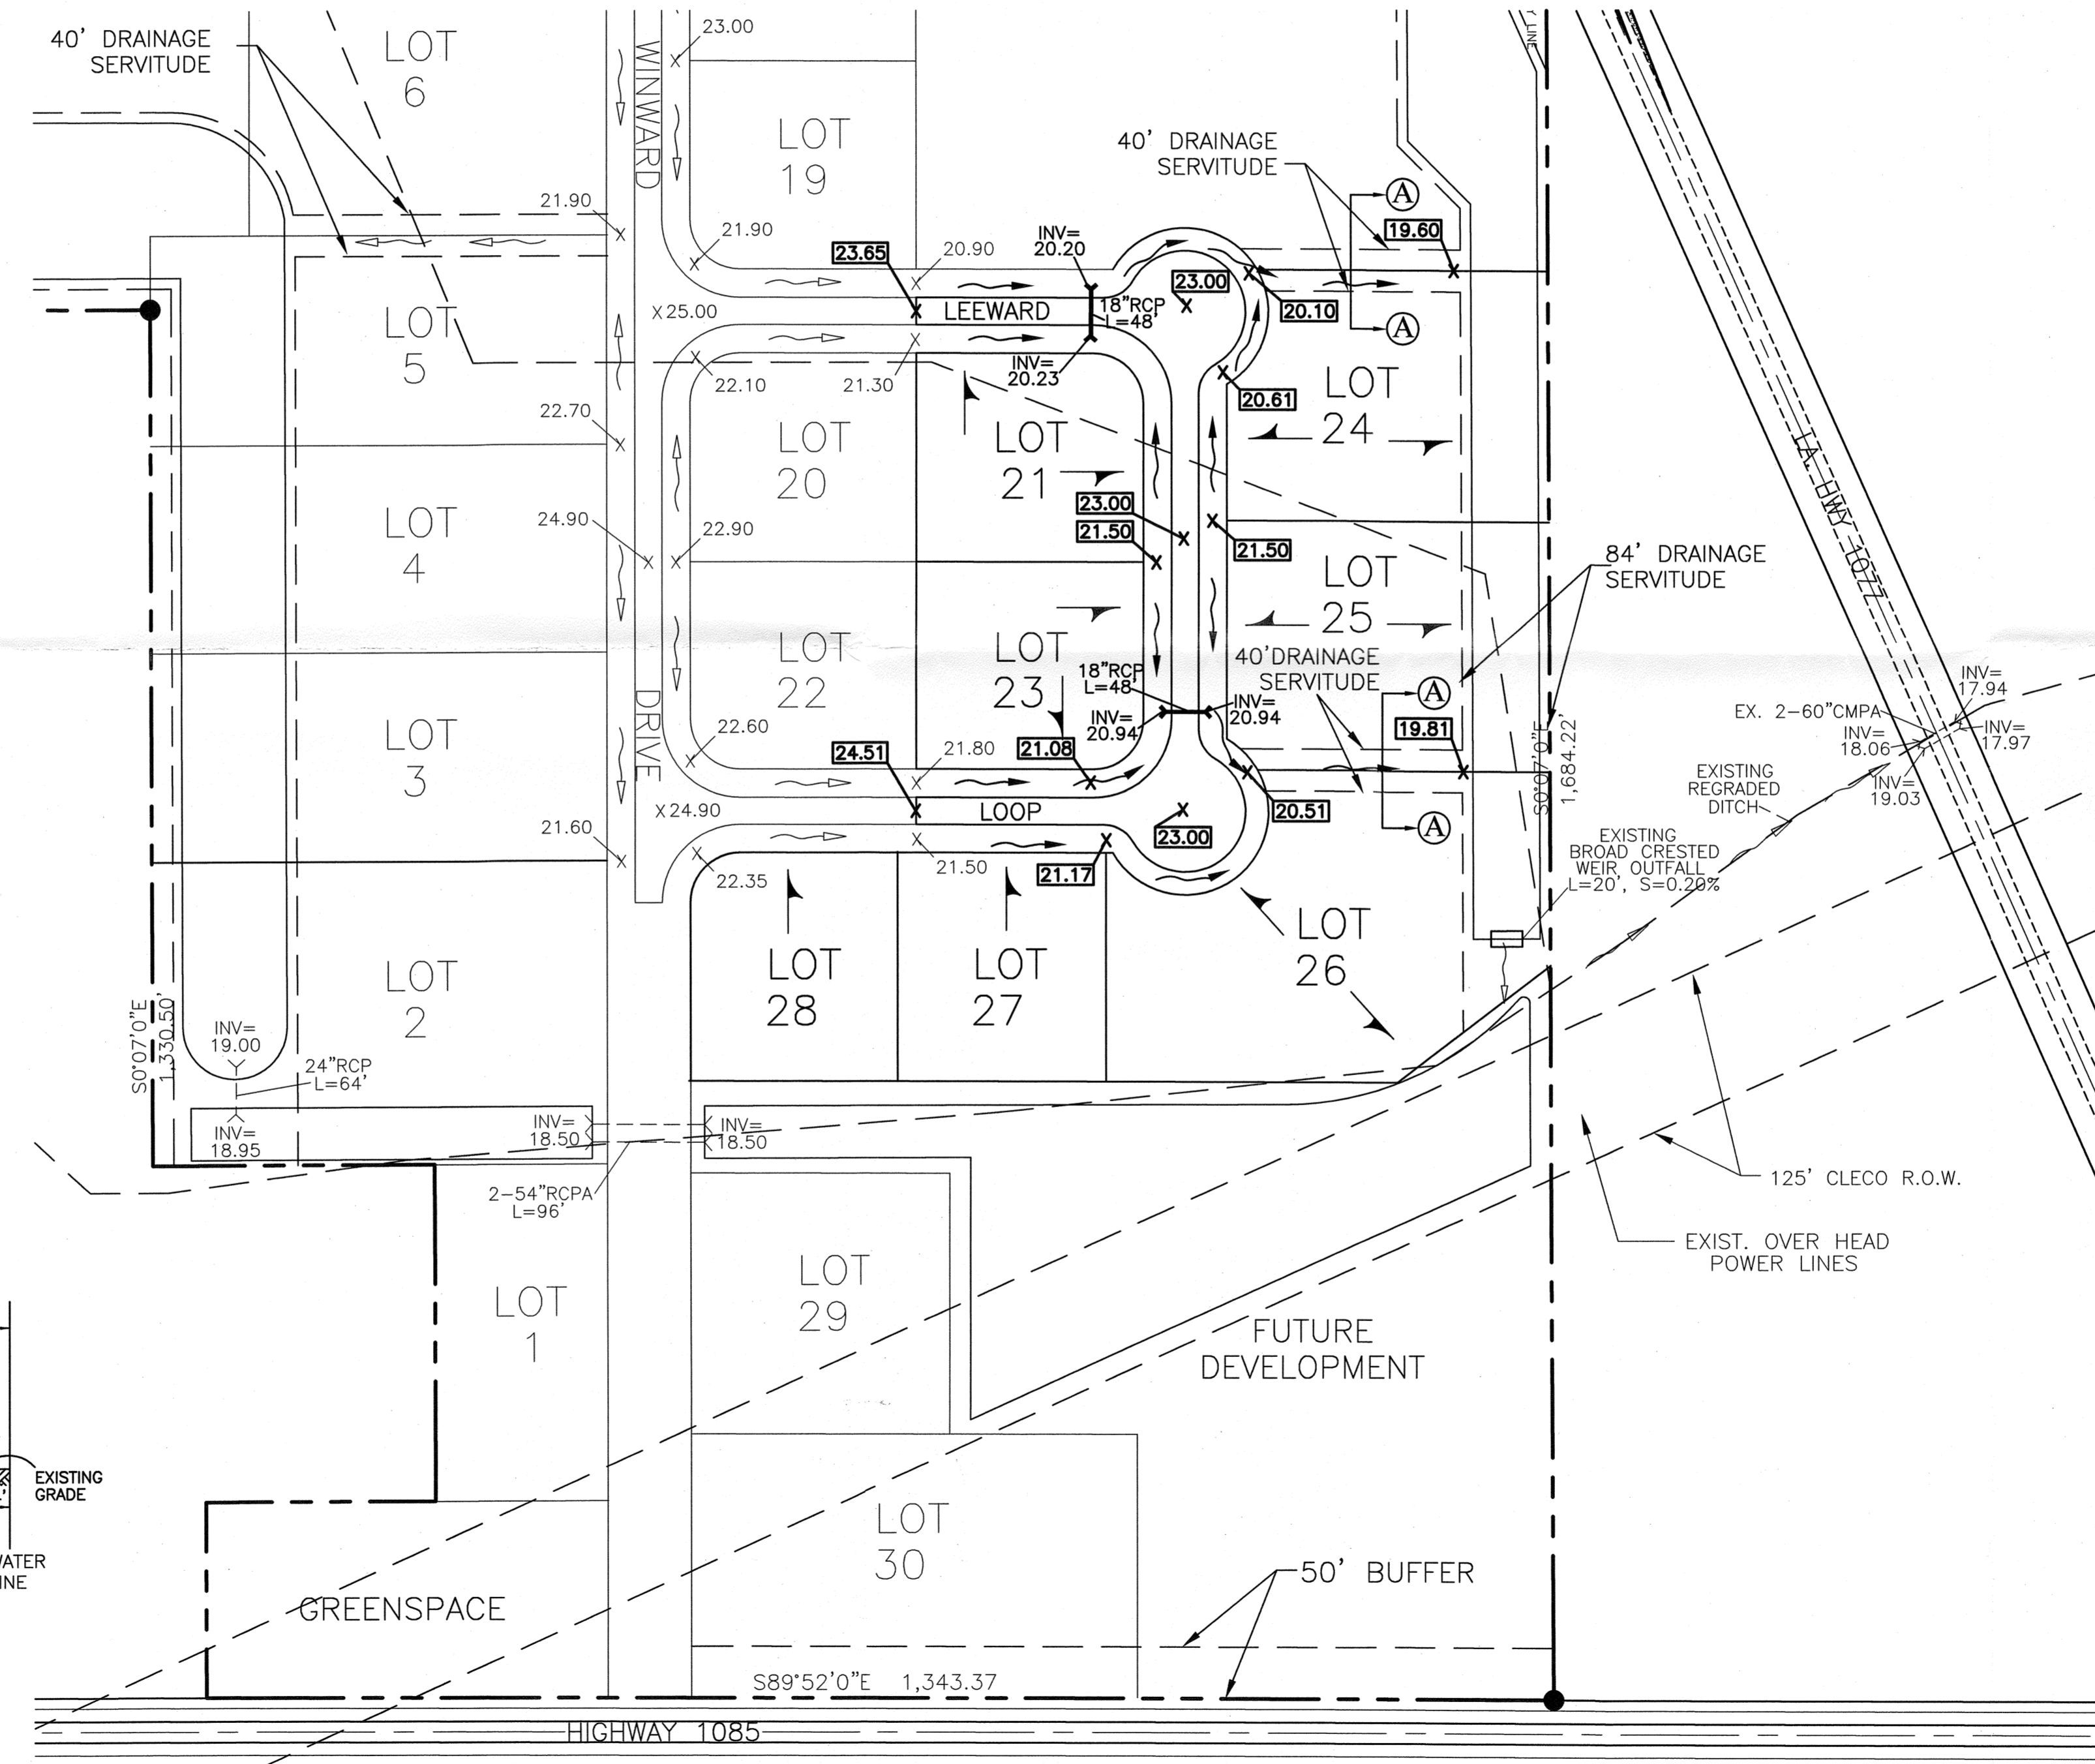
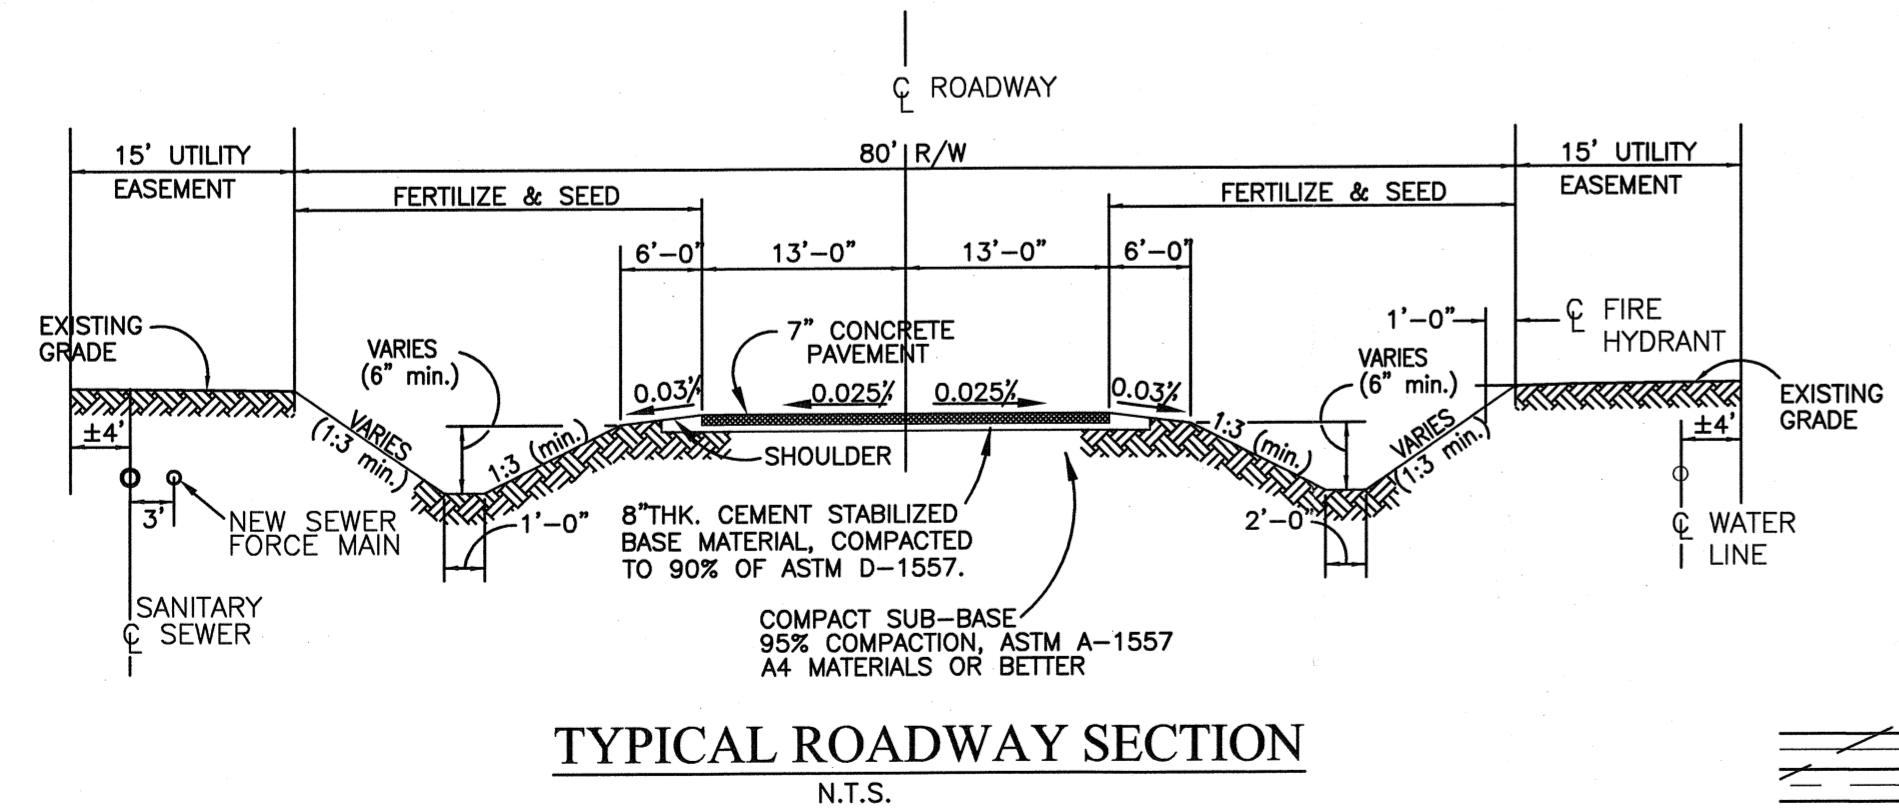


NOTE:
ACCESS TO LOT #28 IS LIMITED TO LEEWARD LOOP UNTIL WINWARD DRIVE ROADWAY IS CONSTRUCTED FOR FULL LENGTH OF LOT #28.

LOT#	RCP/PVC CULVERT	BCCMP CULVERT
21	24"	30"
23	24"	30"
24	15"	18"
25	15"	18"
26	18"	24"
27	18"	24"
28	15"	18"

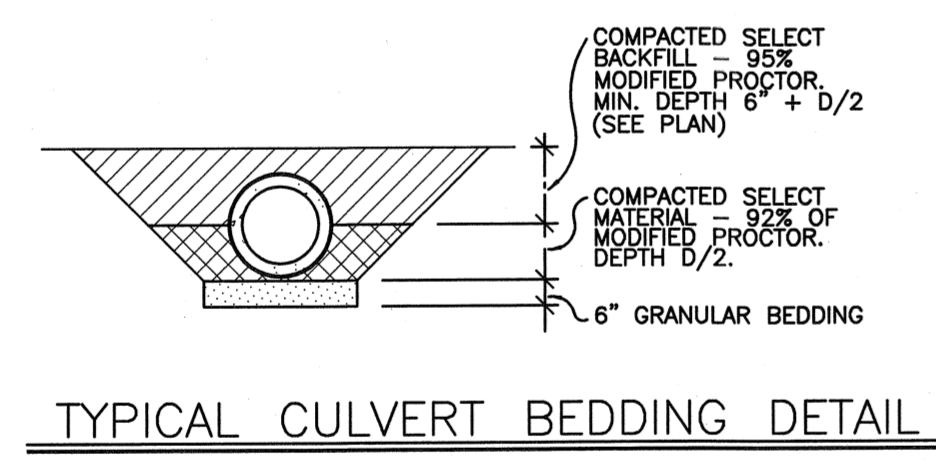

Engineering review copy
Final Plan

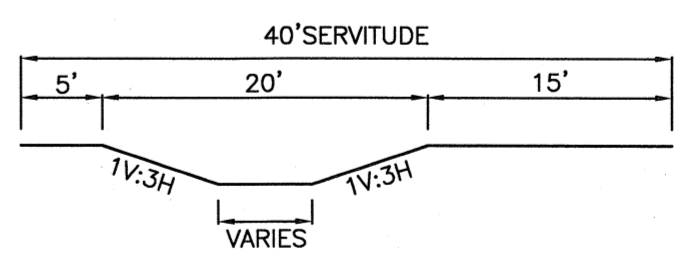

LEGEND

X24.50	PHASE 1 AS-BUILT ELEVATION
---	PHASE 1 AS-BUILT CULVERT
---	PHASE 1 AS-BUILT DITCH FLOW
21.10	AS-BUILT ELEVATION
---	AS-BUILT DITCH FLOW
---	LOT FLOW

CEI COOPER ENGINEERING, Inc.
 Civil Engineering * Planning * Environmental
 P.O. Box 1870 Covington, Louisiana 70434 (985) 898-0182

AS-BUILT PLANS FOR
NORTHPOINTE, PHASE 2
 SECTION 3, TOWNSHIP 7 SOUTH, RANGE 10 EAST
 ST. TAMMANY, LOUISIANA

THESE DRAWINGS ARE THE SOLE PROPERTY OF COOPER ENGINEERING, INC. AND ARE ISSUED AS INSTRUMENTS OF SERVICE. THESE DRAWINGS SHALL NOT BE COPIED, REPRODUCED OR USED IN ANY MANNER THAN WAS ORIGINALLY INTENDED WITHOUT WRITTEN CONSENT OF COOPER ENGINEERING, INC.

C:\BOURGEOIS\06-125\AS-BUILT\C-1 DRAINAGE PLAN\ 2-18-08
 COPYRIGHT 2008, COOPER ENGINEERING, INC.

AS-BUILT DRAINAGE PLAN
SCALE: 1" = 120'