


REVISION HISTORY		REVISION HISTORY	REVISION HISTORY	REVISION HISTORY	REVISION HISTORY
REV	DESCRIPTION	DRAWN BY	CHECKED BY	APPROVED	DATE
1	FIRST ISSUE	W.W.	S.B.	S.B.	17.01.13
2	DRAWING & QUANTITIES UPDATED	R.A.	S.B.	S.B.	06.02.13

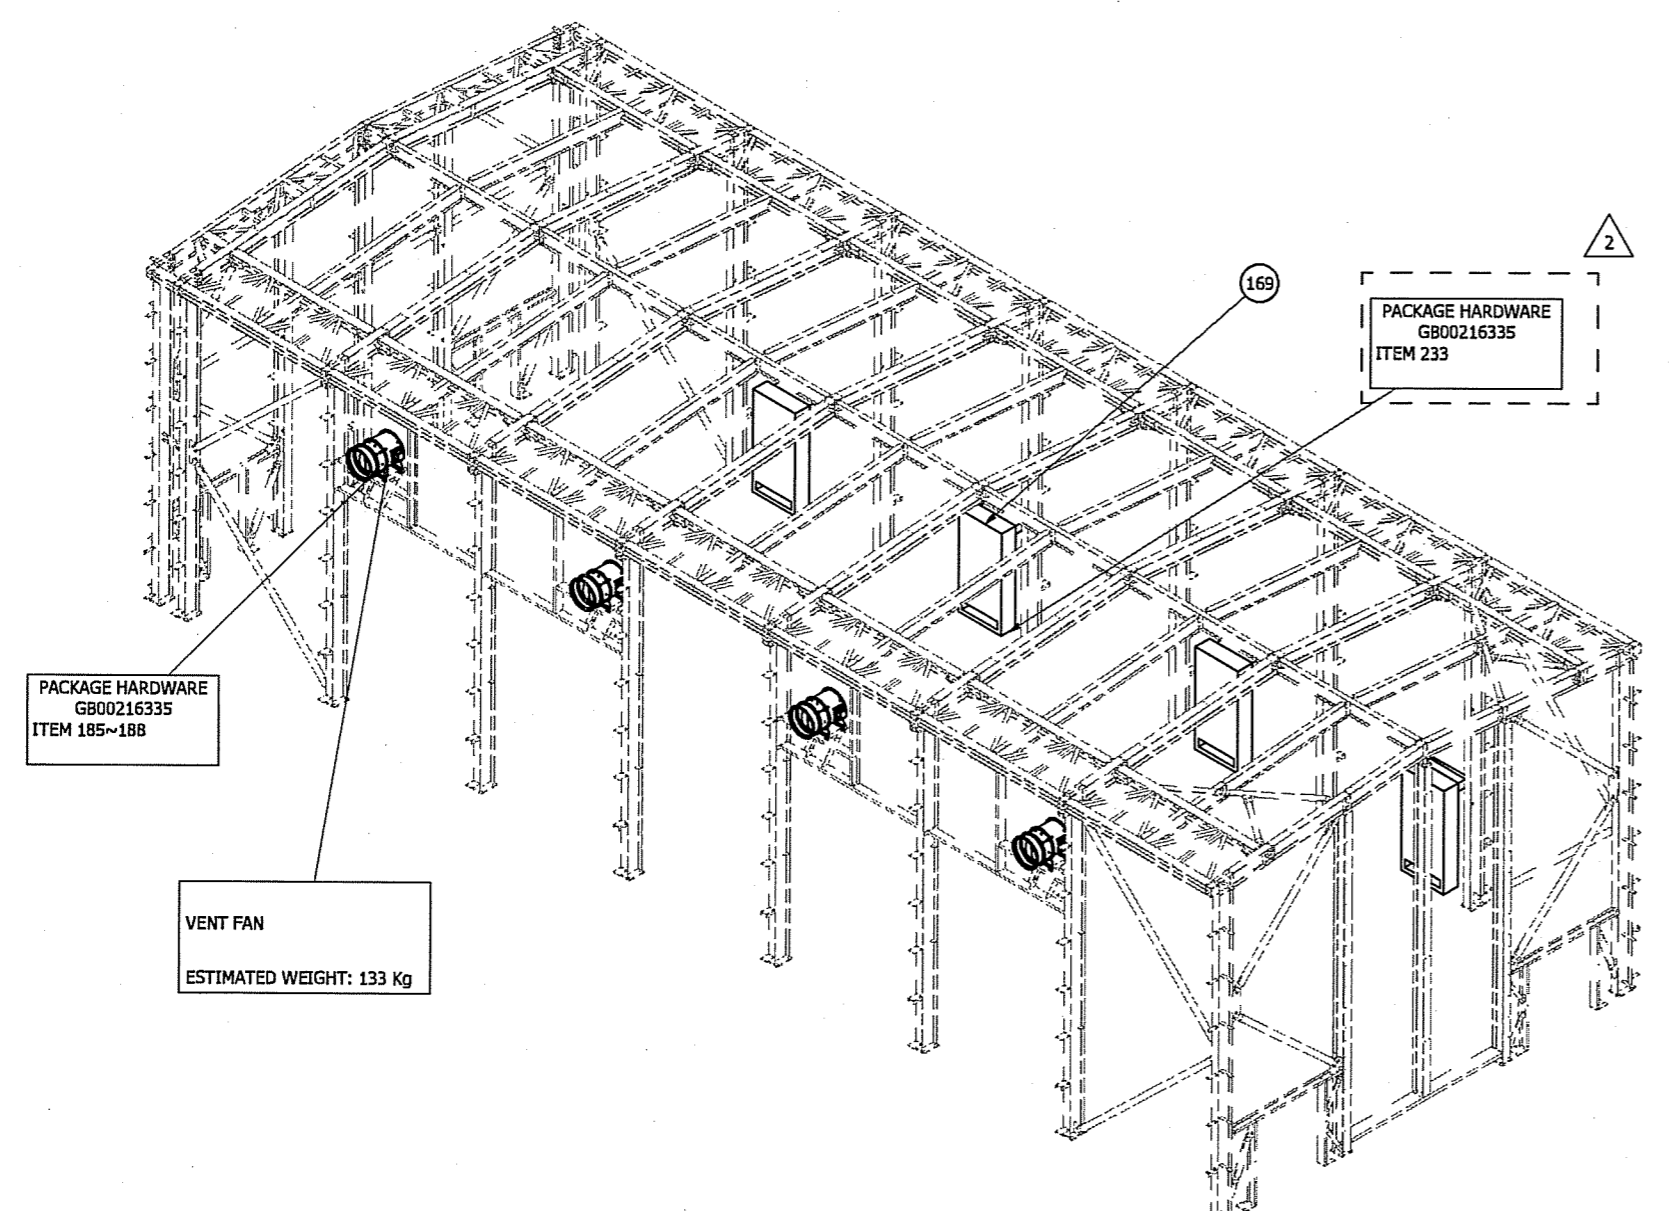


PACKAGE HARDWARE
GB00216335
ITEM 185~188

VENT FAN
ESTIMATED WEIGHT: 133 Kg

169
PACKAGE HARDWARE
GB00216335
ITEM 233

STAGE 4
THIS VIEW SHOWS THE INSTALLATION OF THE
VENT FANS & INLET SILENCER ASSEMBLY

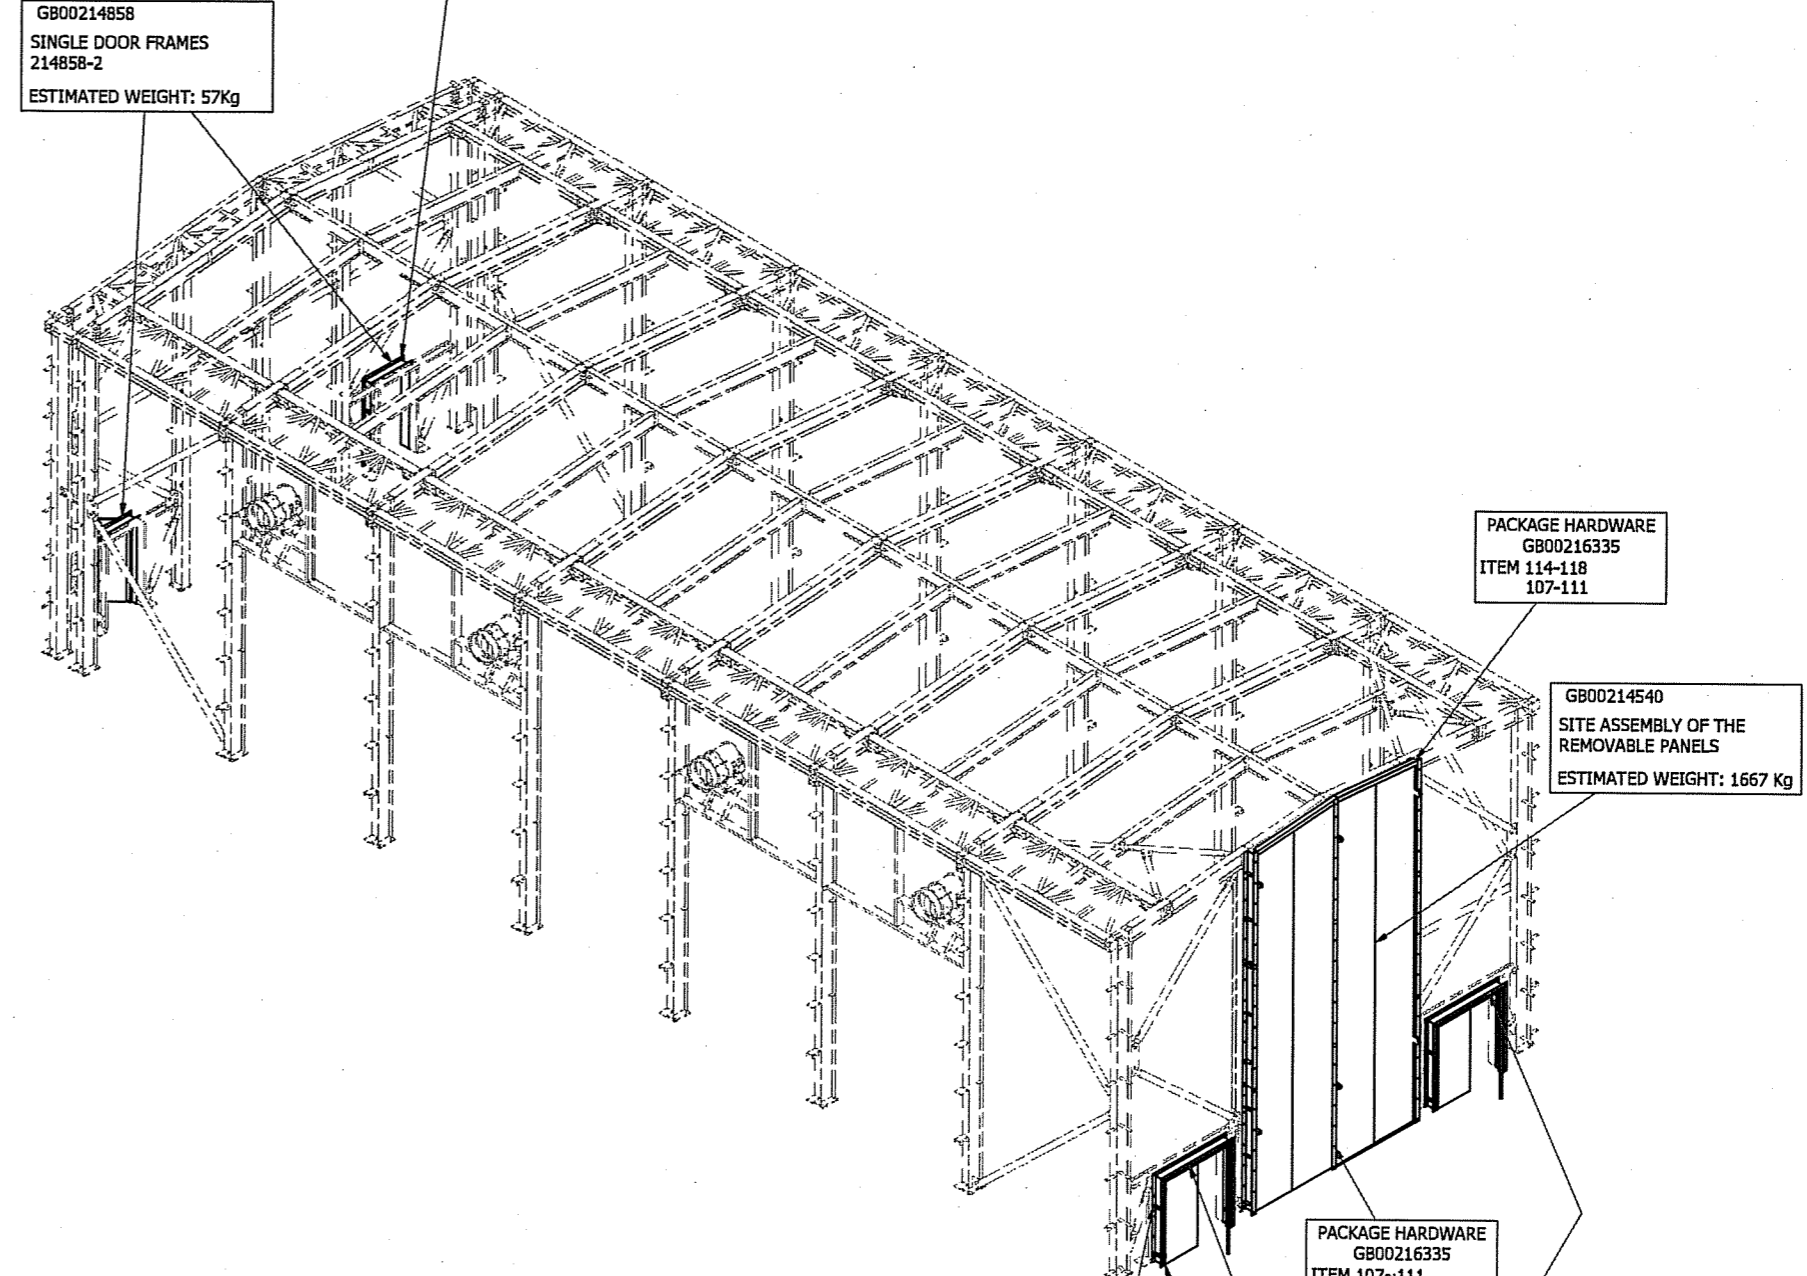

GB00214858
SINGLE DOOR FRAMES
214858-2
ESTIMATED WEIGHT: 57Kg

PACKAGE HARDWARE
GB00216335
ITEM 129~134

PACKAGE HARDWARE
GB00216335
ITEM 114-118
107-111

GB00214540
SITE ASSEMBLY OF THE
REMOVABLE PANELS
ESTIMATED WEIGHT: 1667 Kg

PACKAGE HARDWARE
GB00216335
ITEM 107~111

GB00214858
DOUBLE DOOR FRAMES
214858-1
ESTIMATED WEIGHT: 67 Kg

HARDWARE TO FIT DOORS
SUPPLIED BY OTHERS

PACKAGE HARDWARE
GB00216335
ITEM 121~126

STAGE 5
THIS VIEW SHOWS THE INSTALLATION OF THE REMOVABLE FRAMES
THE OUTER DOOR FRAMES & DOORS

		Project: Ninemile Unit 6	
SSW #: 143209-P610-01-00286 Issue: A		Job No.: 143209	
Client #:			
Vendor #: GB00217621 - SHEET 4 OF 9		SORVD Number: NPV	
Equipment/Tag No.:		Review Status:	
<input checked="" type="checkbox"/> For Information		<input type="checkbox"/> Accepted as Noted (Do Not Resubmit)	
<input type="checkbox"/> Accepted		<input type="checkbox"/> Accepted As Certified	
<input type="checkbox"/> Accepted as Noted (Resubmit)		<input type="checkbox"/> Revise & Resubmit	
Released For: <input type="checkbox"/> Design <input type="checkbox"/> Material Procurement <input checked="" type="checkbox"/> Fabrication <input type="checkbox"/> Construction			
Eng Review Due Date: 3/22/2013 4:00:00 AM			
Signed By: <i>Ken Beatty</i>		Beatty, Ken	
Date: 01/21/13			
THE ACCEPTANCE OF THIS DATA DOES NOT RELIEVE THE (SUB)CONTRACTOR OR SUPPLIER FROM THE OBLIGATION IMPOSED BY THE PURCHASE ORDER (PO) OR (SUB) CONTRACT			

Dammon Engineering, Inc.
554 Old Spanish Trail
Slidell, LA 70458

NOTICE: THIS DRAWING IS THE PROPERTY OF AAF LTD AND IS LOANED SUBJECT TO THE CONDITION THAT IT SHALL NOT BE COPIED, LOANED OR SUBMITTED TO OUTSIDE PARTIES FOR EXAMINATION WITHOUT WRITTEN CONSENT

FIRST ANGLE PROJECTION

TOLERANCES
UNLESS OTHERWISE STATED PART AND FABRICATION TOLERANCES TO BE IN ACCORDANCE WITH AAF-LTD'S STANDARD ENGR000

WEIGHTS STATED ON THIS DRAWING ARE FOR AAF-LTD GUIDANCE AND DO NOT FORM THE BASIS OF A CONTRACT BETWEEN AAF-LTD, AND THE SUB-CONTRACTOR

AAFLTD
Power & Industrial

CLIENT: TOSHIBA
PROJECT: NINE MILE USA

DRAWING SIZE - A1 DRAWING REV - 2

FIRST ORDER NUMBER MX12027

DRAWING NUMBER
GB00217621

SCALE 1:100

DRAWN BY W.W.	DATE 03/12/2012
CHECKED BY R.A.	DATE 17/01/2013
APPROVED BY S.B.	DATE 21/01/2013