


CDR 13 GOLDEN 03-04: VAS BULLING 1 DRAINAGE & PAVING PLANS 5-1-06

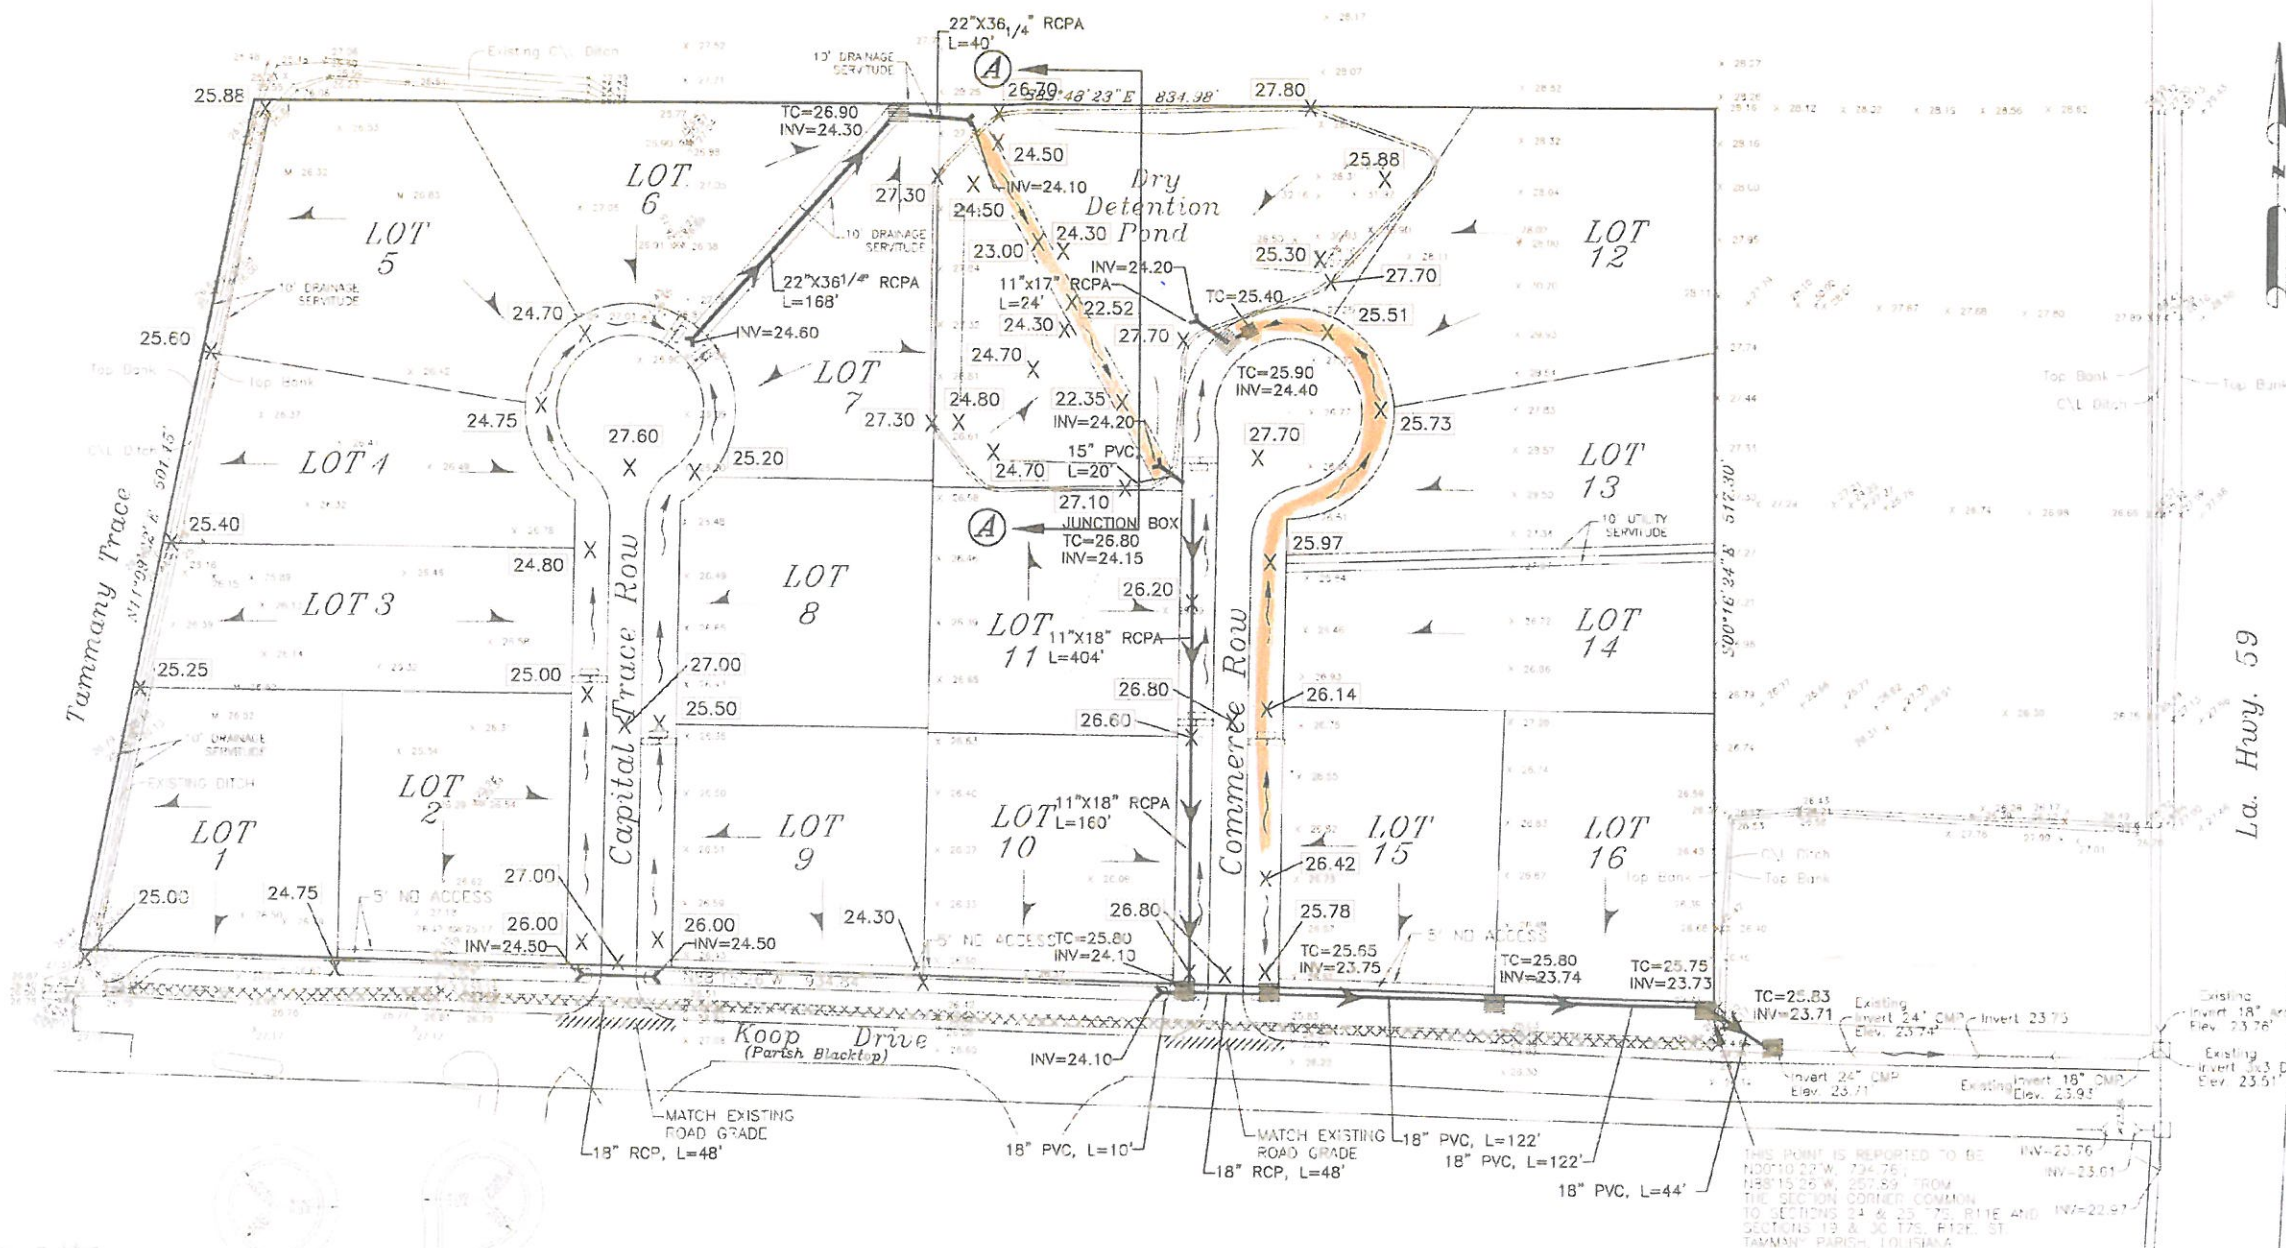

LEGEND:

- 24.78 EXISTING ELEVATIONS
- 24.78 EXISTING CULVERTS
- X 00.00 AS-BUILT ELEVATIONS
- NEW STRAW BALES
- LOT FLOW
- AS-BUILT DITCH FLOW
- AS-BUILT DRAIN INLETS & SUB SURFACE DRAINAGE
- AS-BUILT CULVERTS
- AS-BUILT SUB-SURFACE FLOW
- AS-BUILT JUNCTION BOX
- NEW RELOCATED DITCH
- BACKFILLED EXISTING DITCH


DRIVEWAY CULVERT SIZES

- LOT 1 - 18" RCP OR EQUIVALENT
- LOT 2 - 18" RCP OR EQUIVALENT
- LOT 3 - 18" RCP OR EQUIVALENT
- LOT 4 - 18" RCP OR EQUIVALENT
- LOT 5 - 18" RCP OR EQUIVALENT
- LOT 6 - 18" RCP OR EQUIVALENT
- LOT 7 - 18" RCP OR EQUIVALENT
- LOT 8 - 18" RCP OR EQUIVALENT
- LOT 9 - 18" RCP OR EQUIVALENT
- LOT 10 - 18" RCP OR EQUIVALENT
- LOT 11 - 18" RCP OR EQUIVALENT
- LOT 12 - 18" RCP OR EQUIVALENT
- LOT 13 - 18" RCP OR EQUIVALENT
- LOT 14 - 18" RCP OR EQUIVALENT
- LOT 15 - 18" RCP OR EQUIVALENT
- LOT 16 - 18" RCP OR EQUIVALENT



NOTE: ALL AREAL FLOOD ZONE C MINIMUM FLOOR TO GATEIN SUBJECT TO PARISH FLOODING PERMIT REGULATIONS.

NOTE: MINOR ELEVATIONS ARE SHOWN FOR THROUGHOUT ELEVATIONS TO GIVE ON THIS PLAN.

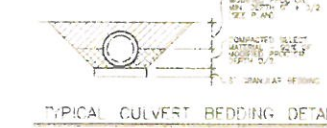

DRAINAGE & PAVING PLAN

SCALE: 1" = 50'

CEI COOPER ENGINEERING, INC.
 Civil Engineering * Planning * Environmental
 P.O. Box 1870 Covington, Louisiana 70434 (985) 845-8155

AS-BUILT PLANS FOR
KOOP OFFICE PARK
 SECTION 24, TOWNSHIP 7 SOUTH, RANGE 11 EAST
 ST. TAMMANY, LOUISIANA

AS-BUILT DRAINAGE & PAVING PLAN
 03-04-06
 Dwn: JCB/DCG
 Cbk: JCB/DCG
 Date: 11.11.04
 Rev: 12.13.04
C-1
 Sheet 9/

THESE DRAWINGS ARE THE SOLE PROPERTY OF COOPER ENGINEERING, INC. AND ARE ISSUED AS INSTRUMENTS OF SERVICE. THESE DRAWINGS SHALL NOT BE COPIED, REPRODUCED OR USED IN ANY MANNER THAN WAS ORIGINALLY INTENDED WITHOUT WRITTEN CONSENT OF COOPER ENGINEERING, INC.

Final Plan