

**REVISIONS**  
 1. NOT USED  
 2. 02-10-2010  
 CLIENT COMMENTS

**PARC PLACE**  
PROVIDENT REALTY ADVISORS, INC.  
CHALMETTE, LOUISIANA


**SCALE**  
1/8" = 1'-0"

**DATE**  
30 APR 2009

**TITLE**  
CONSTRUCTION

**SHEET**  
3C OF 5

REVISION: INCLUDES NEW CLUBHOUSE FOOTPRINT AND RELATED WALKGRADING LAYOUT, ADDITION OF MONUMENT SIGNAGE, SUBSTITUTION OF ORNAMENTAL STEEL FOR PERIMETER CHAIN LINK FENCING, SPECIFICATION OF POOL DECK COLOR AND SPECIFICATION OF CLUBHOUSE PORCH TREATMENT.

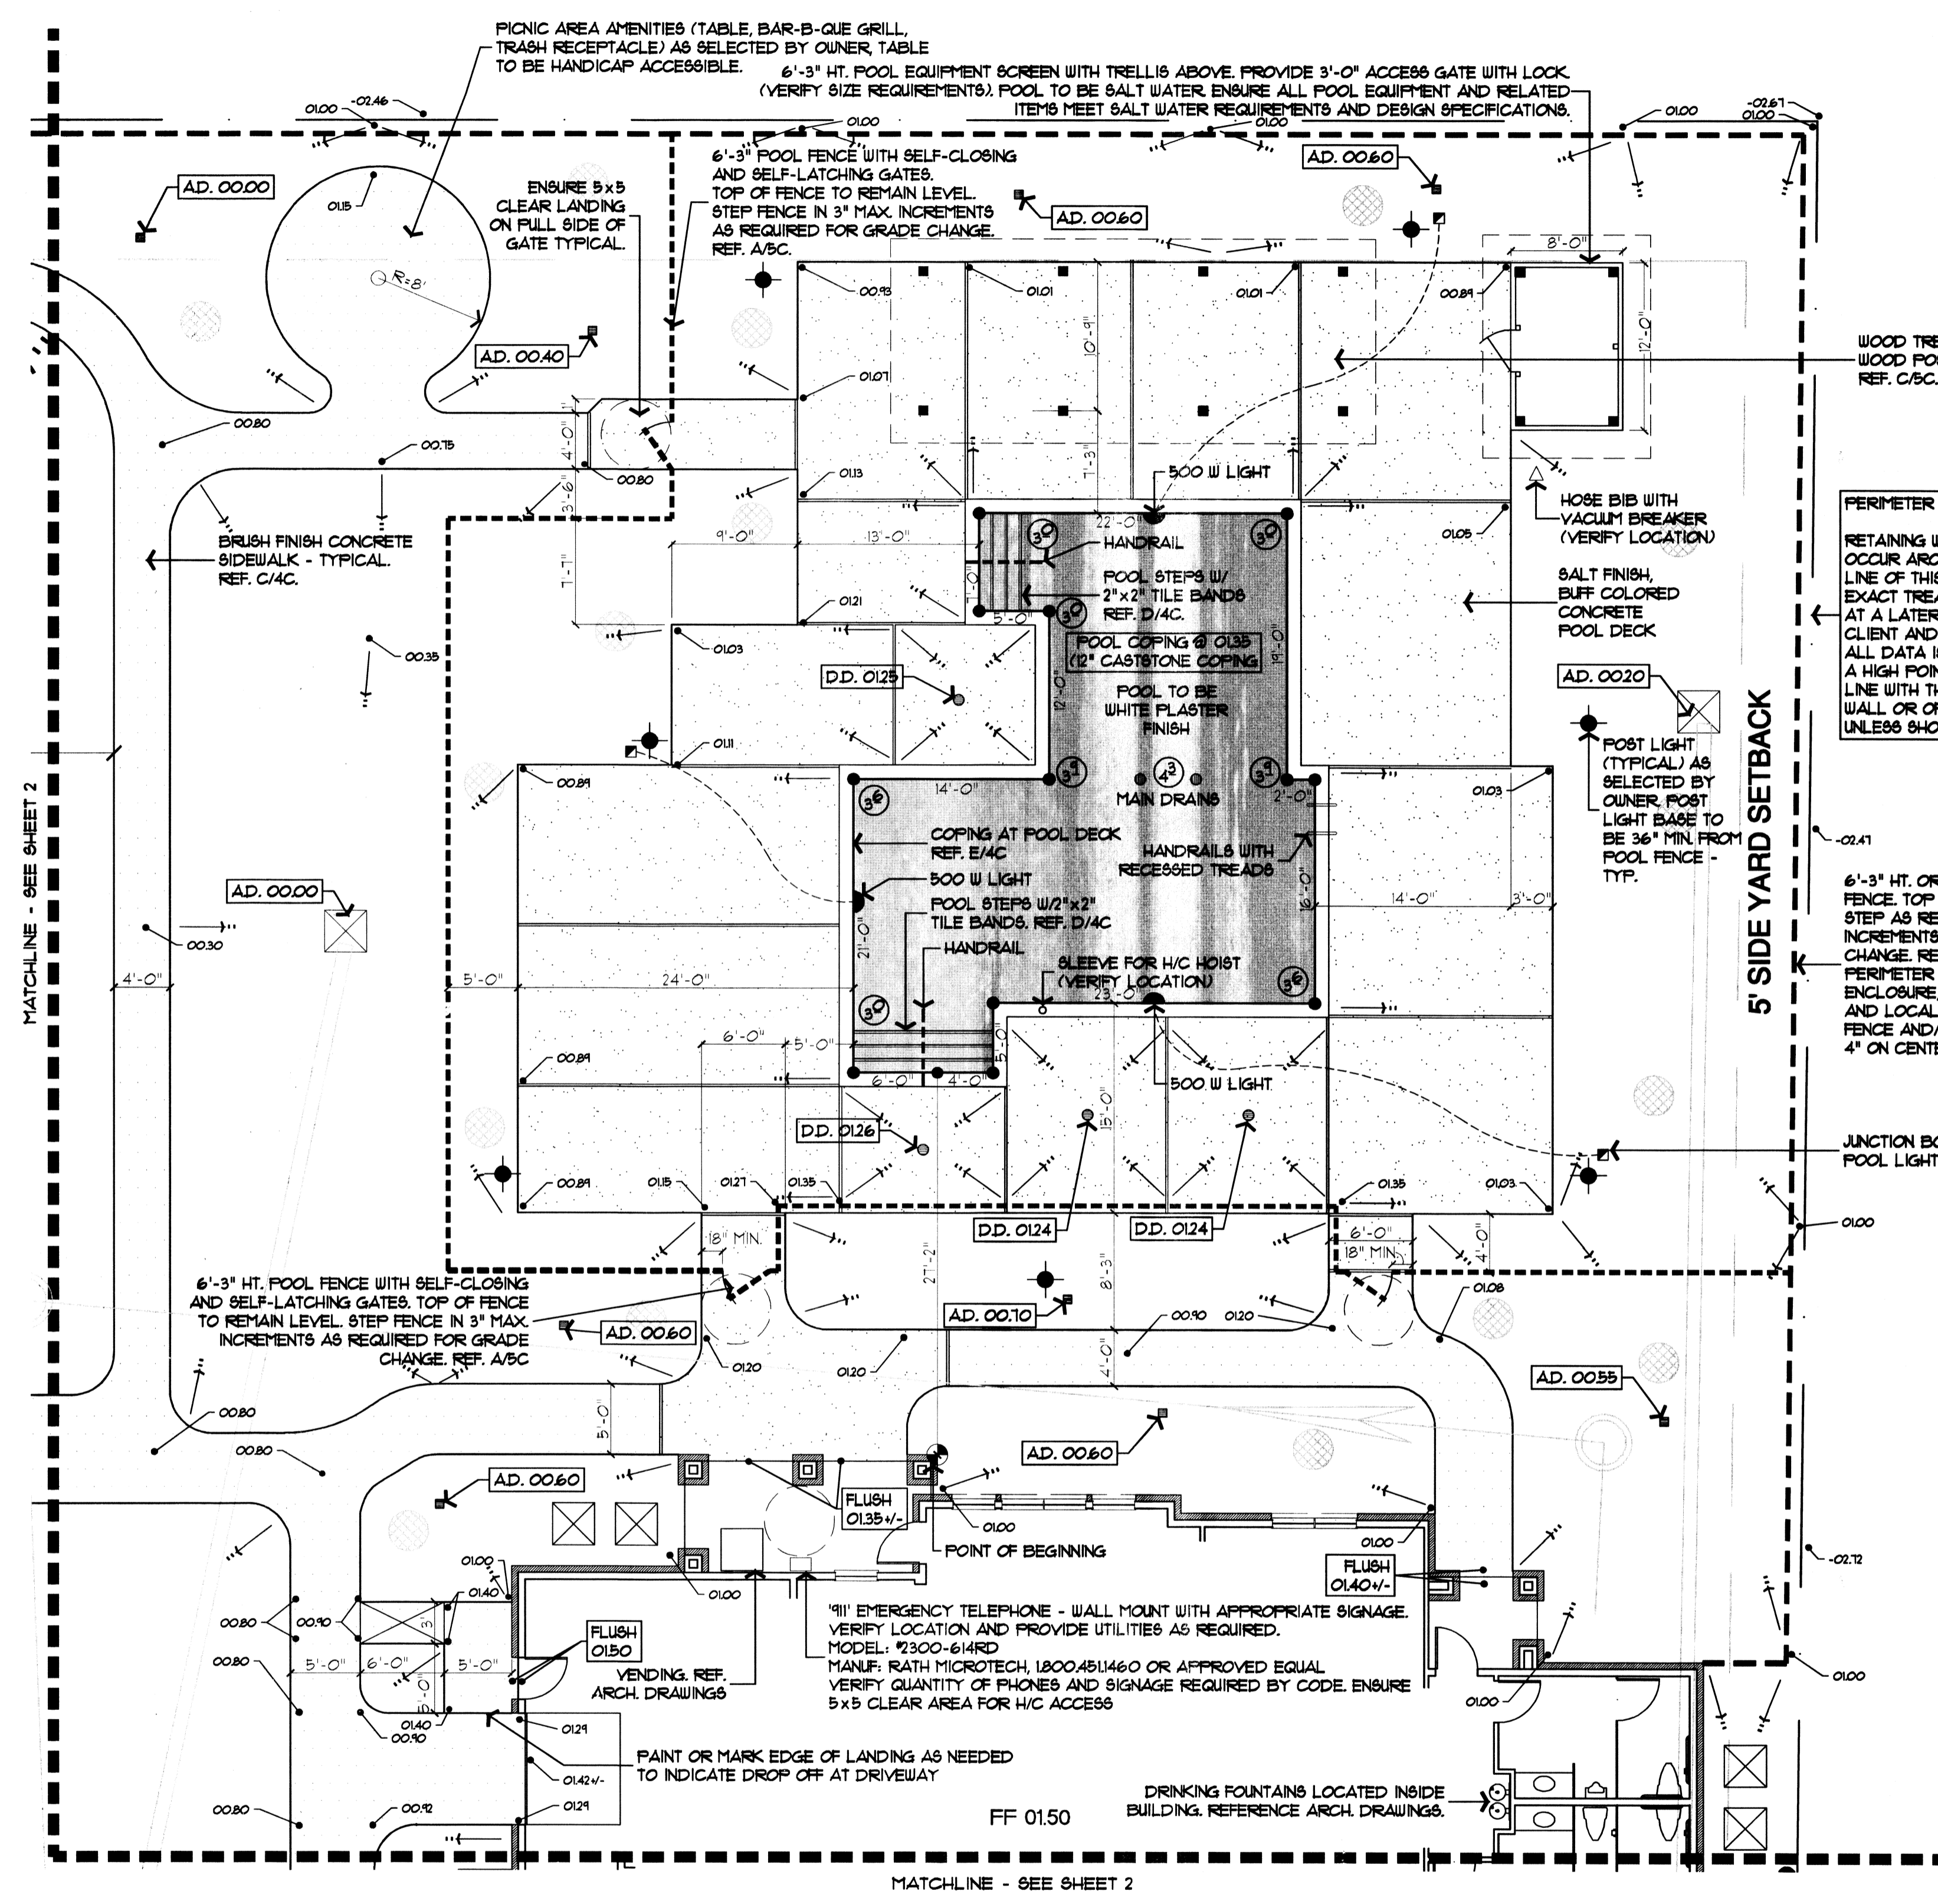

**POOL CONSTRUCTION LEGEND**

TOP OF CURB GRADE	TC XXXX
PROPOSED GRADE	XXXX
TOP OF WALL GRADE	TU XXXX
AREA DRAIN ELEVATION	AD. XXXX
AREA DRAIN (PER CIVIL ENGINEER)	[Symbol]
AREA DRAIN (ADDITIONAL LOCATION BY L. ARCH)	[Symbol]
DECK DRAIN ELEVATION	DD. XXXX
DECK DRAIN (LOCATION BY L. ARCH)	[Symbol]
PROPOSED CONTOUR	[Symbol]
DIRECTION OF DRAINAGE	[Symbol]
STONE WALL	[Symbol]
SLOPED WALL	[Symbol]
BRUSH FINISH CONCRETE	[Symbol]
SPECIAL PAVING (REFERENCE PLAN)	[Symbol]
WOOD FENCE	[Symbol]
ORNAMENTAL FENCE	[Symbol]
POOL FENCE	[Symbol]
HANDRAIL / RAILING	[Symbol]
POST LIGHT	[Symbol]
BOLLARD LIGHT	[Symbol]
TREE UPLIGHT	[Symbol]
POOL LIGHT	[Symbol]
SCONE LIGHT	[Symbol]
FIBER OPTIC LIGHT	[Symbol]
DRAIN LINE	[Symbol]
JUNCTION BOX	[Symbol]
PROPOSED TREE BALL	[Symbol]
POOL DEPTH (FEET AND INCHES)	[Symbol]
POOL DIMENSIONS	[Symbol]
AIR CONDITIONER	[Symbol]
TRANSFORMER	[Symbol]
ELECTRICAL METERS	[Symbol]
BARRIER-FREE RAMP AND CURB OPENING	[Symbol]
BARRIER-FREE RAMP	[Symbol]
ACCESSIBLE ROUTE 1/20 MAX. SLOPE	[Symbol]
CURB OPENING	[Symbol]
IRRIGATION SLEEVE	[Symbol]

- NOTE:**
- REFER TO SHEET 1C FOR CONSTRUCTION AND ACCESSIBILITY NOTES.
  - REFER TO SHEET 4C FOR POOL SPECIFICATIONS, NOTES AND DETAILS.
  - ALL POOLS AND POOL FACILITIES TO MEET ALL STATE OF LOUISIANA CODES AND STANDARDS AS ADOPTED IN THE LOUISIANA ADMINISTRATIVE CODE TITLE 51, PUBLIC HEALTH SANITARY CODE, PART XXIV, SWIMMING POOLS AND NATURAL OR SEMI-ARTIFICIAL SWIMMING OR BATHING PLACES.
  - CONNECT DECK/AREA DRAINS TO STORM SEWER. REFERENCE CIVIL ENGINEER'S PLANS FOR LOCATION OF STORM SEWER DRAINS AND DRAIN LINE TO BE SIZED BY CIVIL ENGINEER.
  - A HOSE BIB AND VACUUM BREAKER SHALL BE PROVIDED FOR WASHING DOWN THE ENTIRE POOL DECK AREA.
  - SHOWER AND OUTDOOR DRINKING FOUNTAIN REQUIREMENTS FOR POOL FACILITIES TO BE CONFIRMED BY THE LOCAL HEALTH DEPARTMENT OR OTHER AUTHORIZED AGENCY.
  - POOL TO BE SALT WATER. ENSURE ALL POOL EQUIPMENT AND RELATED ITEMS MEET SALT WATER REQUIREMENTS AND DESIGN SPECIFICATIONS.

- NOTES**
- HANDICAP ACCESSIBLE GATE WITH KEY, CARD, OR COMBINATION LOCK ONLY.
  - \* INSTALL ON BOTH SIDES OF GATE WHEN GATE SHIELD IS NOT INSTALLED
  - \* INSTALL ON OUTSIDE OF POOL FENCE WITH LATCH ON POOL SIDE ONLY WHEN GATE SHIELD IS INSTALLED.
  - \* REFER TO DETAIL A/B/C.

