

# AS-BUILT SEWER SYSTEM RENOVATION BRIDGE CITY CENTER FOR YOUTH

PROJECT NO.: 08-403-11-01 PART-01  
 & 08-403-04B-01 PART-20  
 & 01-107-06B-11 PART U7


SITE CODE 1-26-004  
 3225 RIVER ROAD  
 BRIDGE CITY, LA 70094



STATE OF LOUISIANA  
 JOHN BEL EDWARDS  
 GOVERNOR

DIVISION OF ADMINISTRATION  
 JAY DARDENNE  
 COMMISSIONER OF ADMINISTRATION

OFFICE OF FACILITY PLANNING AND CONTROL  
 MARK MOSES  
 DIRECTOR

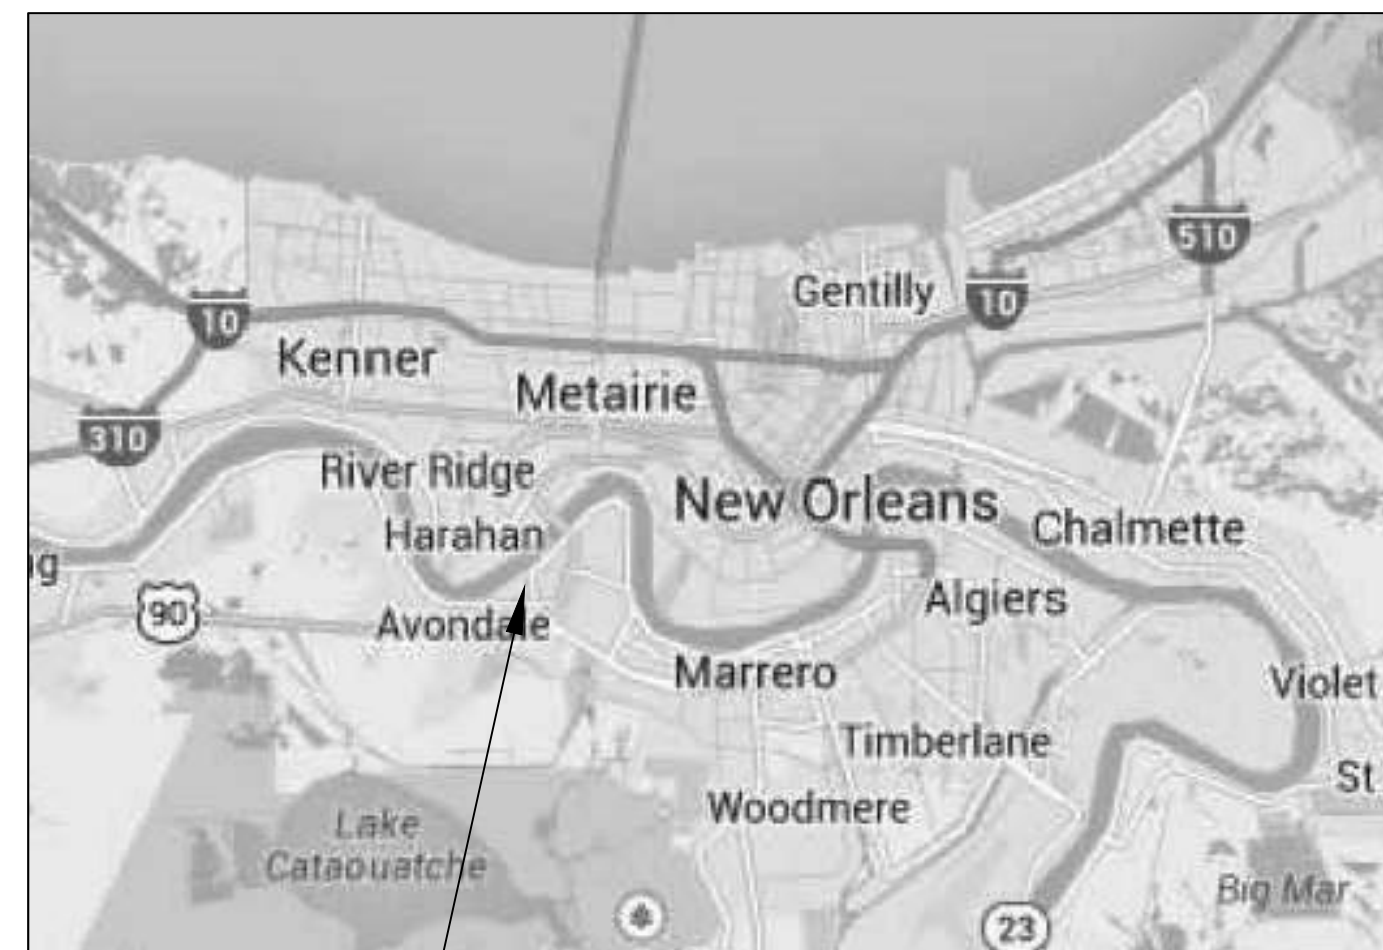

AREA OF WORK  
 VICINITY MAP  
 N.T.S.

INDEX OF DRAWINGS		
SHT#	DWG#	DRAWING NAME
01	CS	COVERSHEET
02	C1	SITE PLAN
03	C1.1	PARTIAL SITE PLAN
04	C1.2	PARTIAL SITE PLAN
05	C1.3	PARTIAL SITE PLAN
06	C1.4	PARTIAL SITE PLAN
07	C1.5	PARTIAL SITE PLAN
08	C1.6	PARTIAL SITE PLAN
09	C1.7	PARTIAL SITE PLAN
10	C1.8	PARTIAL SITE PLAN
11	C2	SEWER DETAILS
12	C3	LIFT STATION DETAILS
13	E1	LIFT STATION ELECTRICAL PLAN
14	E2	LIFT STATION CONTROLS

**DAMMON**  
 ENGINEERING, INC.  
 554 Old Spanish Trail, Slidell, LA 70458  
 (985) 649-5832  
 www.dammonengineering.com  
 info@dammonengineering.com  
 Chief Engineer: Brian Metch, PE  
 554 Old Spanish Trail  
 Slidell, LA 70458

**AS-BUILT**

SEAL:

SEWER SYSTEM RENOVATION:  
 PROJECT NUMBERS: 08-403-11-01 PART 1 &  
 08-403-04B-01, PART 20 & 01-107-06B-11, Part U7  
 BRIDGE CITY CENTER FOR YOUTH  
 3225 RIVER ROAD  
 BRIDGE CITY, LA 70094  
 JOB No: 2156 DATE: 9/26/2019  
 DRAWN BY: DPFC CHECKED BY: BNM

SHEET TITLE:  
 COVER SHEET

DRAWING NUMBER:  
**CS**