


Base elevation assumed 0.0' (finished floor) unless noted.
 (+) elevation above FF / (-) below FF

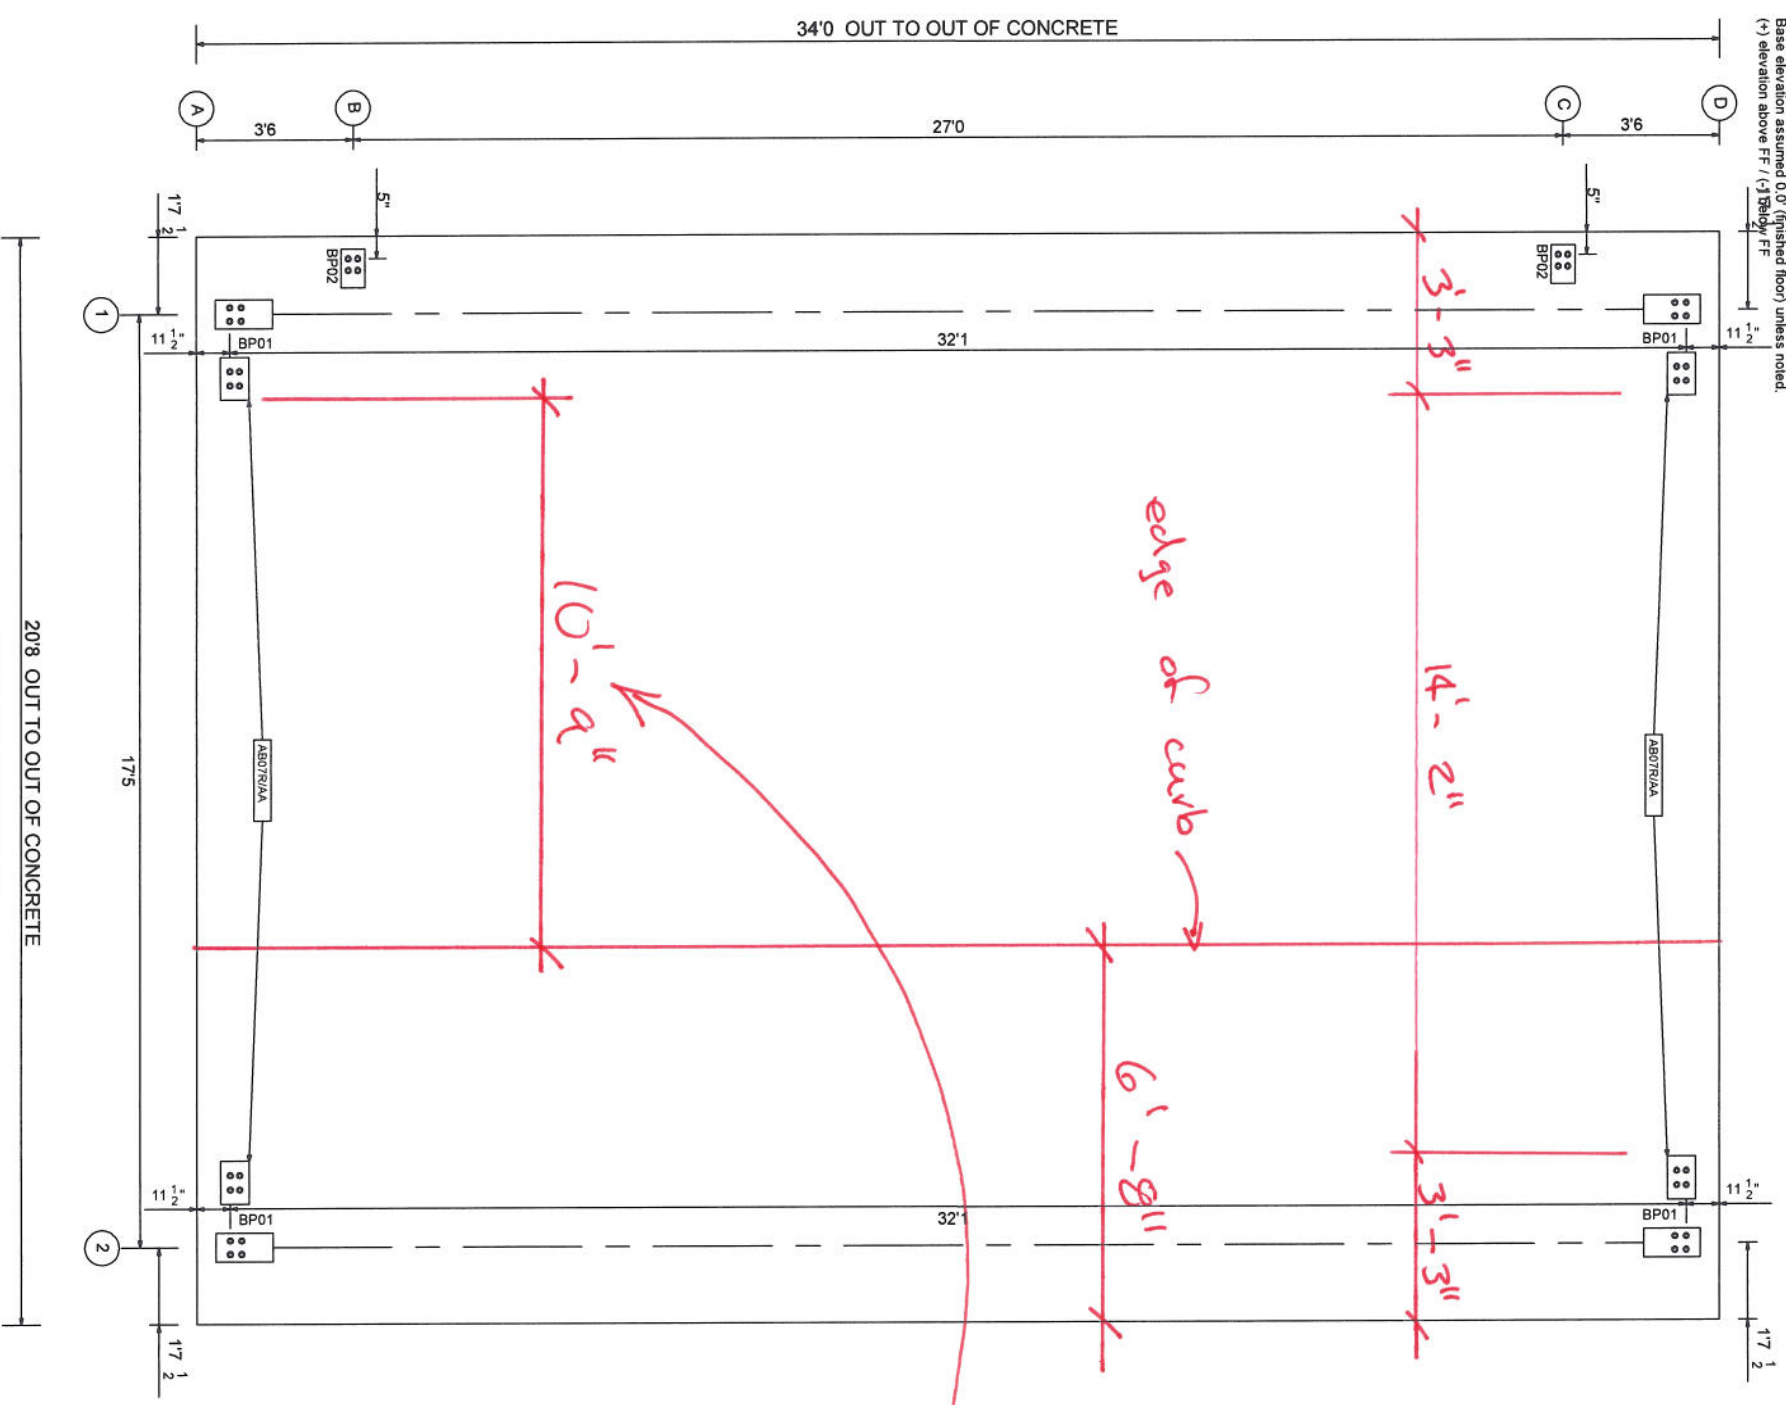

We need 12'-0" for vehicles here.

ANCHOR BOLT PLAN

208. OUT TO OUT OF CONCRETE

NO.	REVISIONS	MADE	CHKD	DATE	ENGR	DATE	DRAWING SUBMITTAL STATUS	SCALE:	NONE	DATE	EUPAULA	ALABAMA	
							<input type="checkbox"/> FOR CONSTRUCTION <input type="checkbox"/> FOR APPROVAL <input type="checkbox"/> FOR PERMIT ONLY <input type="checkbox"/> FOR PRELIMINARY				Child Dev. Council of Acadiana, Inc Opelousas, LA 70570	 AMERICAN BUILDINGS COMPANY	ALABAMA REV. NO.
							DRAWN BY: CHKD BY: DSGN APP BY: CAD BY:				E. L. Habeltz Builders, Inc. HAB903 Part 2		

AMERICAN BUILDINGS COMPANY RESERVES THE RIGHT TO REVISE DATA, DIMENSIONS AND INFORMATION PRESENTED IN THIS DRAWING BASED ON RECEIPT OF ORDER DOCUMENTATION, ORDER CLARIFICATION AND FINAL ENGINEERING. THIS DRAWING IS INTENDED FOR THE PURPOSES OF APPROXIMATE REPRESENTATION AND MAY NOT BE SUITABLE FOR CONSTRUCTION, APPROVAL DRAWINGS, PERMIT DRAWINGS, OTHER FINAL ENGINEERING DRAWINGS & DOCUMENTATION UNLESS APPROVED FOR SUCH PURPOSE BY AMERICAN BUILDINGS COMPANY.