


1 LANDSCAPE AND HARDSCAPE CONSTRUCTION  
AS-1.0 SCALE: 3/16" = 1'-0"

FILE: - XREFS: -

PLAN SYMBOL LEGEND	
	LADDER RAILS WITH ANCHORS AND ESCUTCHEON PLATES
	POOL ENTRY HANDRAILS
	EYEBALL WALL RETURN INLETS
	UNDERWATER POOL LIGHTS
	POOL SKIMMER RETURNS
	POOL MAIN DRAINS (GRATE AND SUMP ASSEMBLY)
	POOL DEPTH MARKERS AND NO DIVING SYMBOLS
	OVER FLOW INLET / WATER SUPPLY INLET

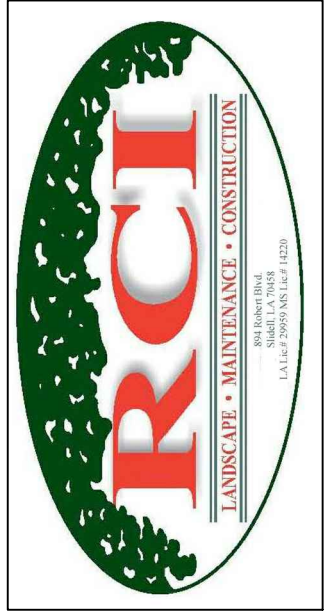

894 ROBERT BOULEVARD  
SLIDELL, LOUISIANA 70458  
PH. 985-643-2427  
FAX 985-643-2691  
RROTOLD@ROTOLOCONSULTANTS.COM

LAKWOOD MANOR APARTMENTS  
LAKE AVENUE  
METAIRIE, LA.

Copyright 2015 © Rotolo Consultants Inc.  
These drawings or parts thereof, may not  
be reproduced in any form, by any method,  
for any purpose, without prior written  
consent from Rotolo Consultants Inc.  
Contact: Rod Rotolo 985-643-2427  
Project No: 82-14080-LA

Revisions:		
No:	Date:	Description:


Date: 8/11/2015  
Drawn: TJH  
Checked: MR  
Sheet Title:

LANDSCAPE  
&  
HARDSCAPE  
AS-BUILTS

Drawing No.

AS-1.0

Sheet No.  
1 OF 4

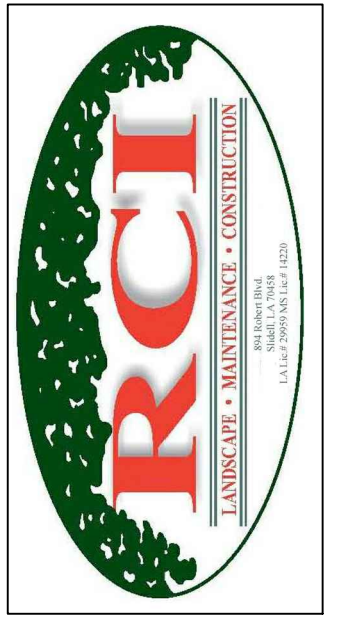

894 ROBERT BOULEVARD  
SLIDELL, LOUISIANA 70458  
PH. 985-643-2427  
FAX 985-643-2691  
RROTOLDO@ROTOLOCONSULTANTS.COM

# LAKWOOD MANOR APARTMENTS LAKE AVENUE METAIRIE, LA.

Copyright 2015 © Rotolo Consultants Inc.  
These drawings or parts thereof, may not  
be reproduced in any form, by any method,  
for any purpose, without prior written  
consent from Rotolo Consultants Inc.  
Contact: Rod Rotolo 985.643.2427  
Project No: 82-14080-LA

Revisions:		
No:	Date:	Description:


Date: 8/11/2015  
Drawn: TJH  
Checked: MR  
Sheet Title:

## IRRIGATION AS-BUILTS

Drawing No.

# AS-1.1

Sheet No.  
2 OF 4

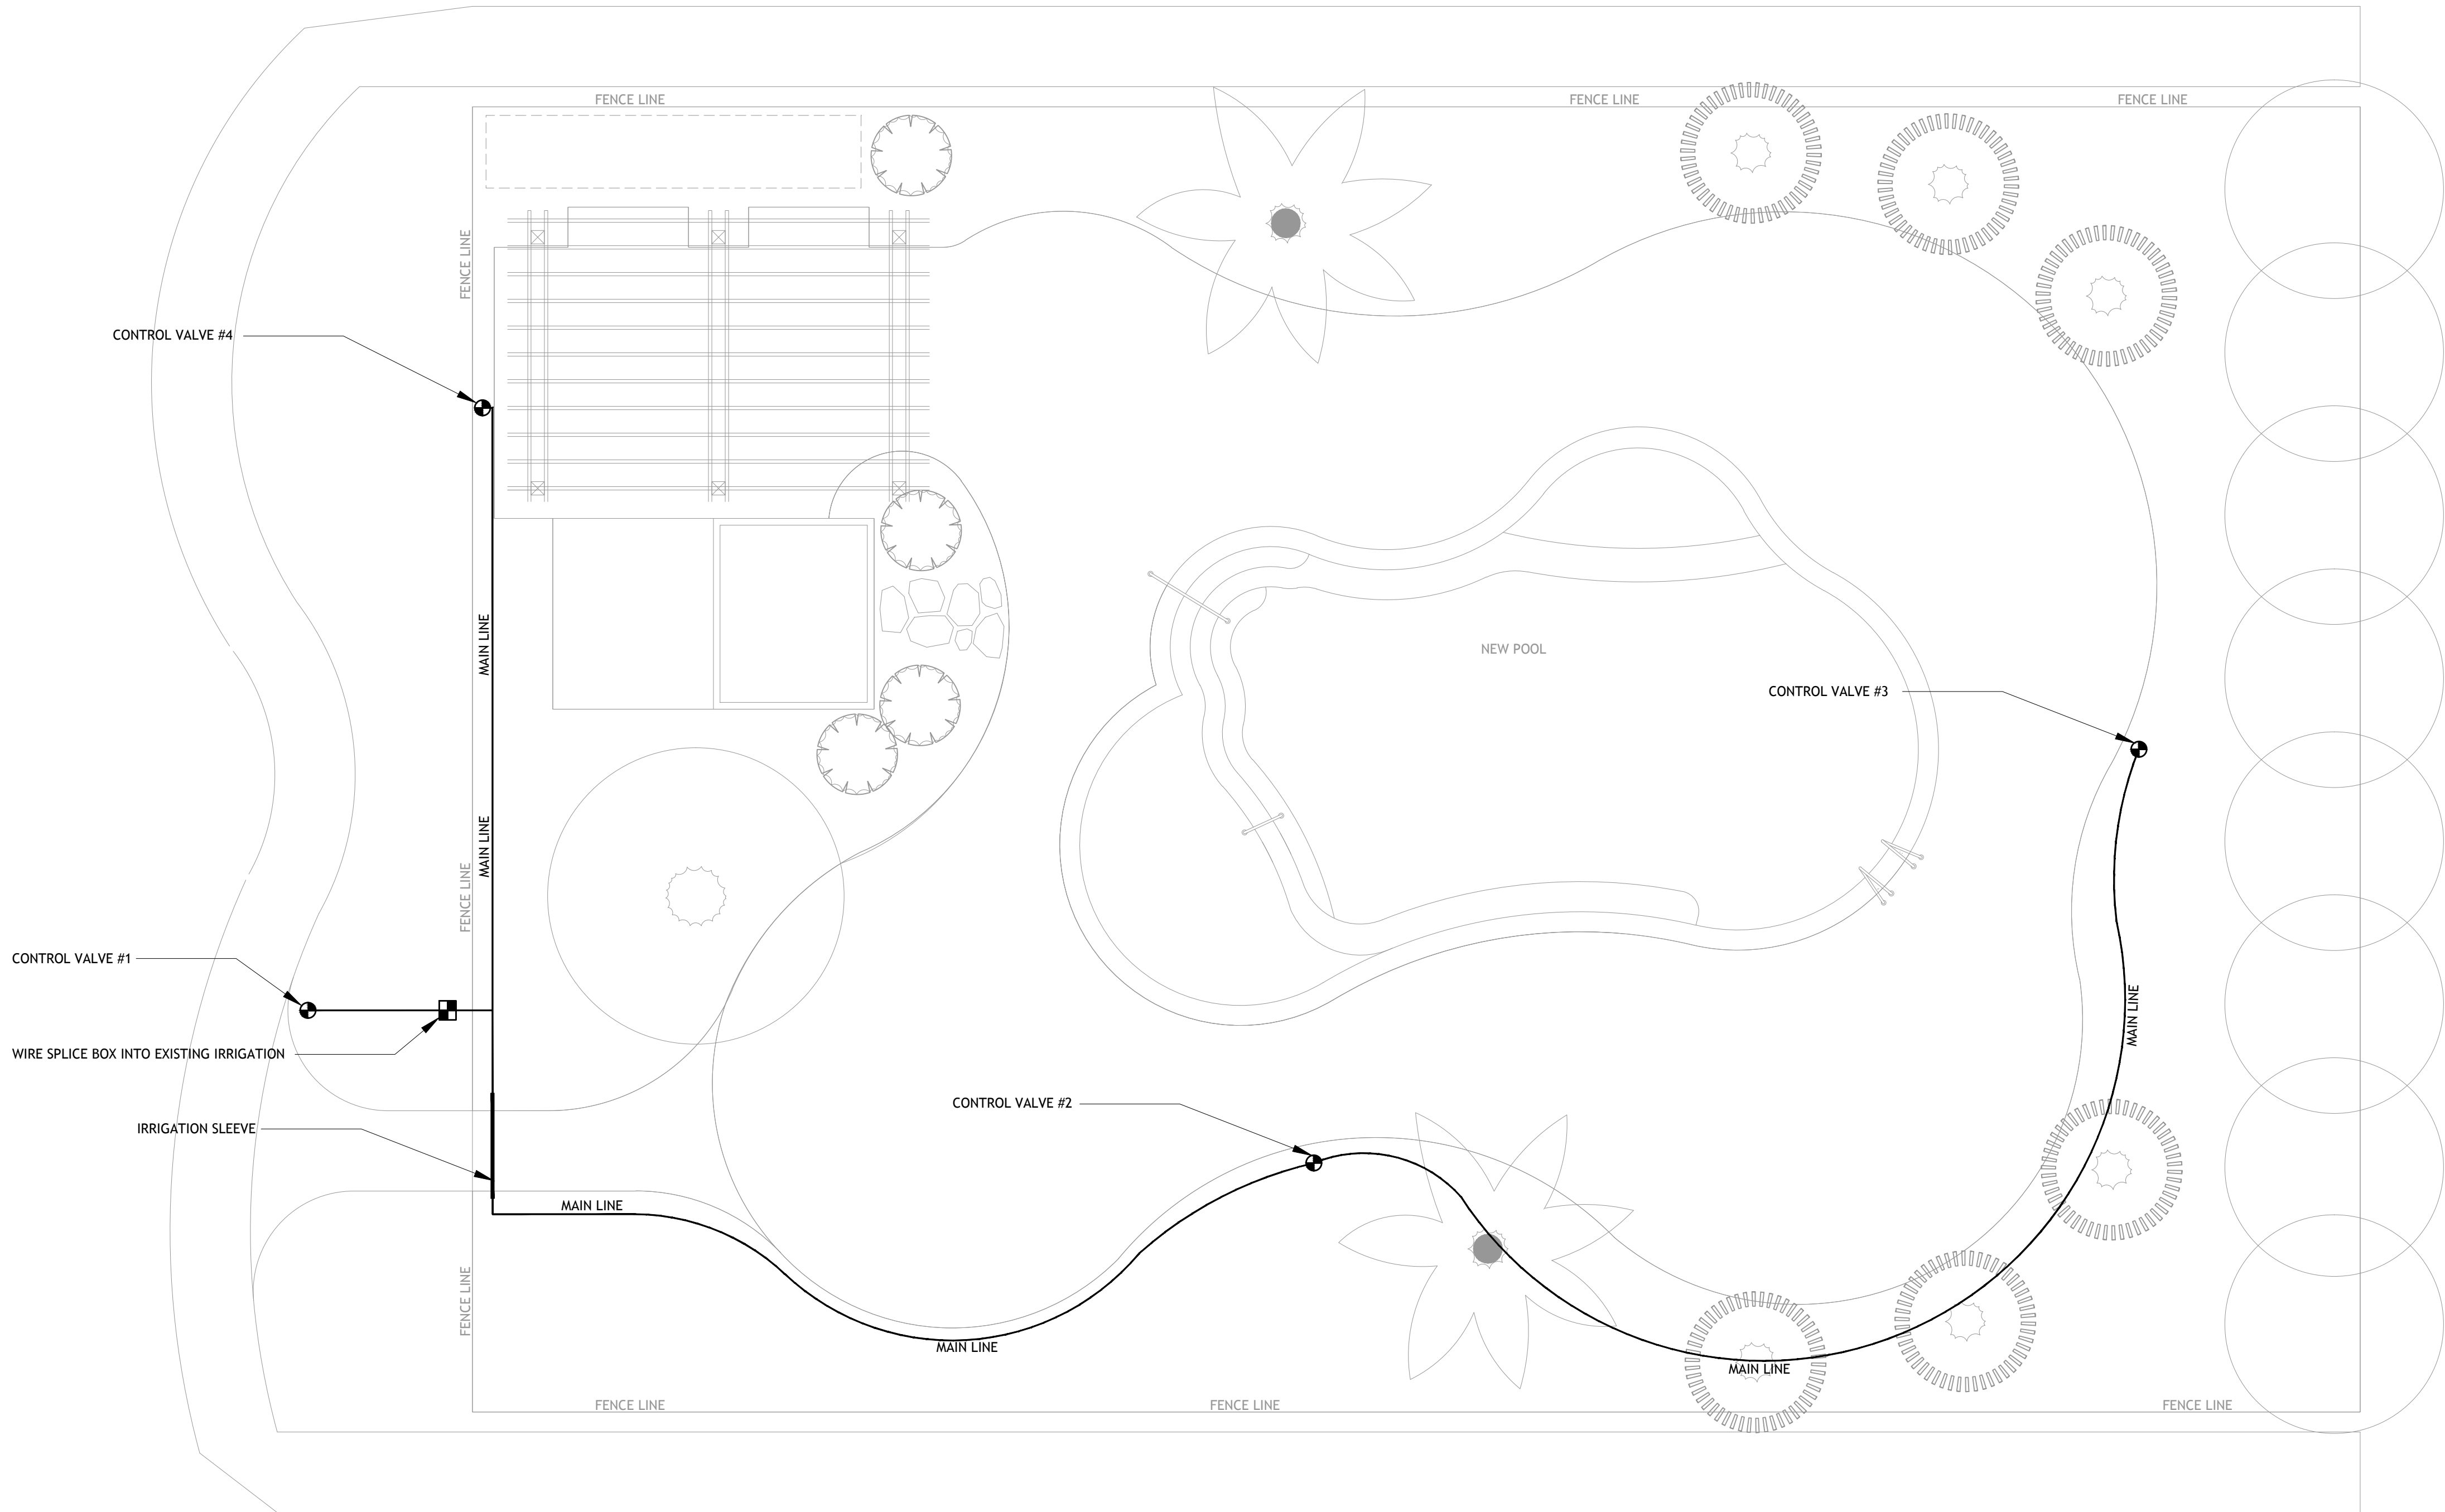


1  
AS-1.1  
SCALE: 3/16" = 1'-0"

FILE: -

XREFS: -



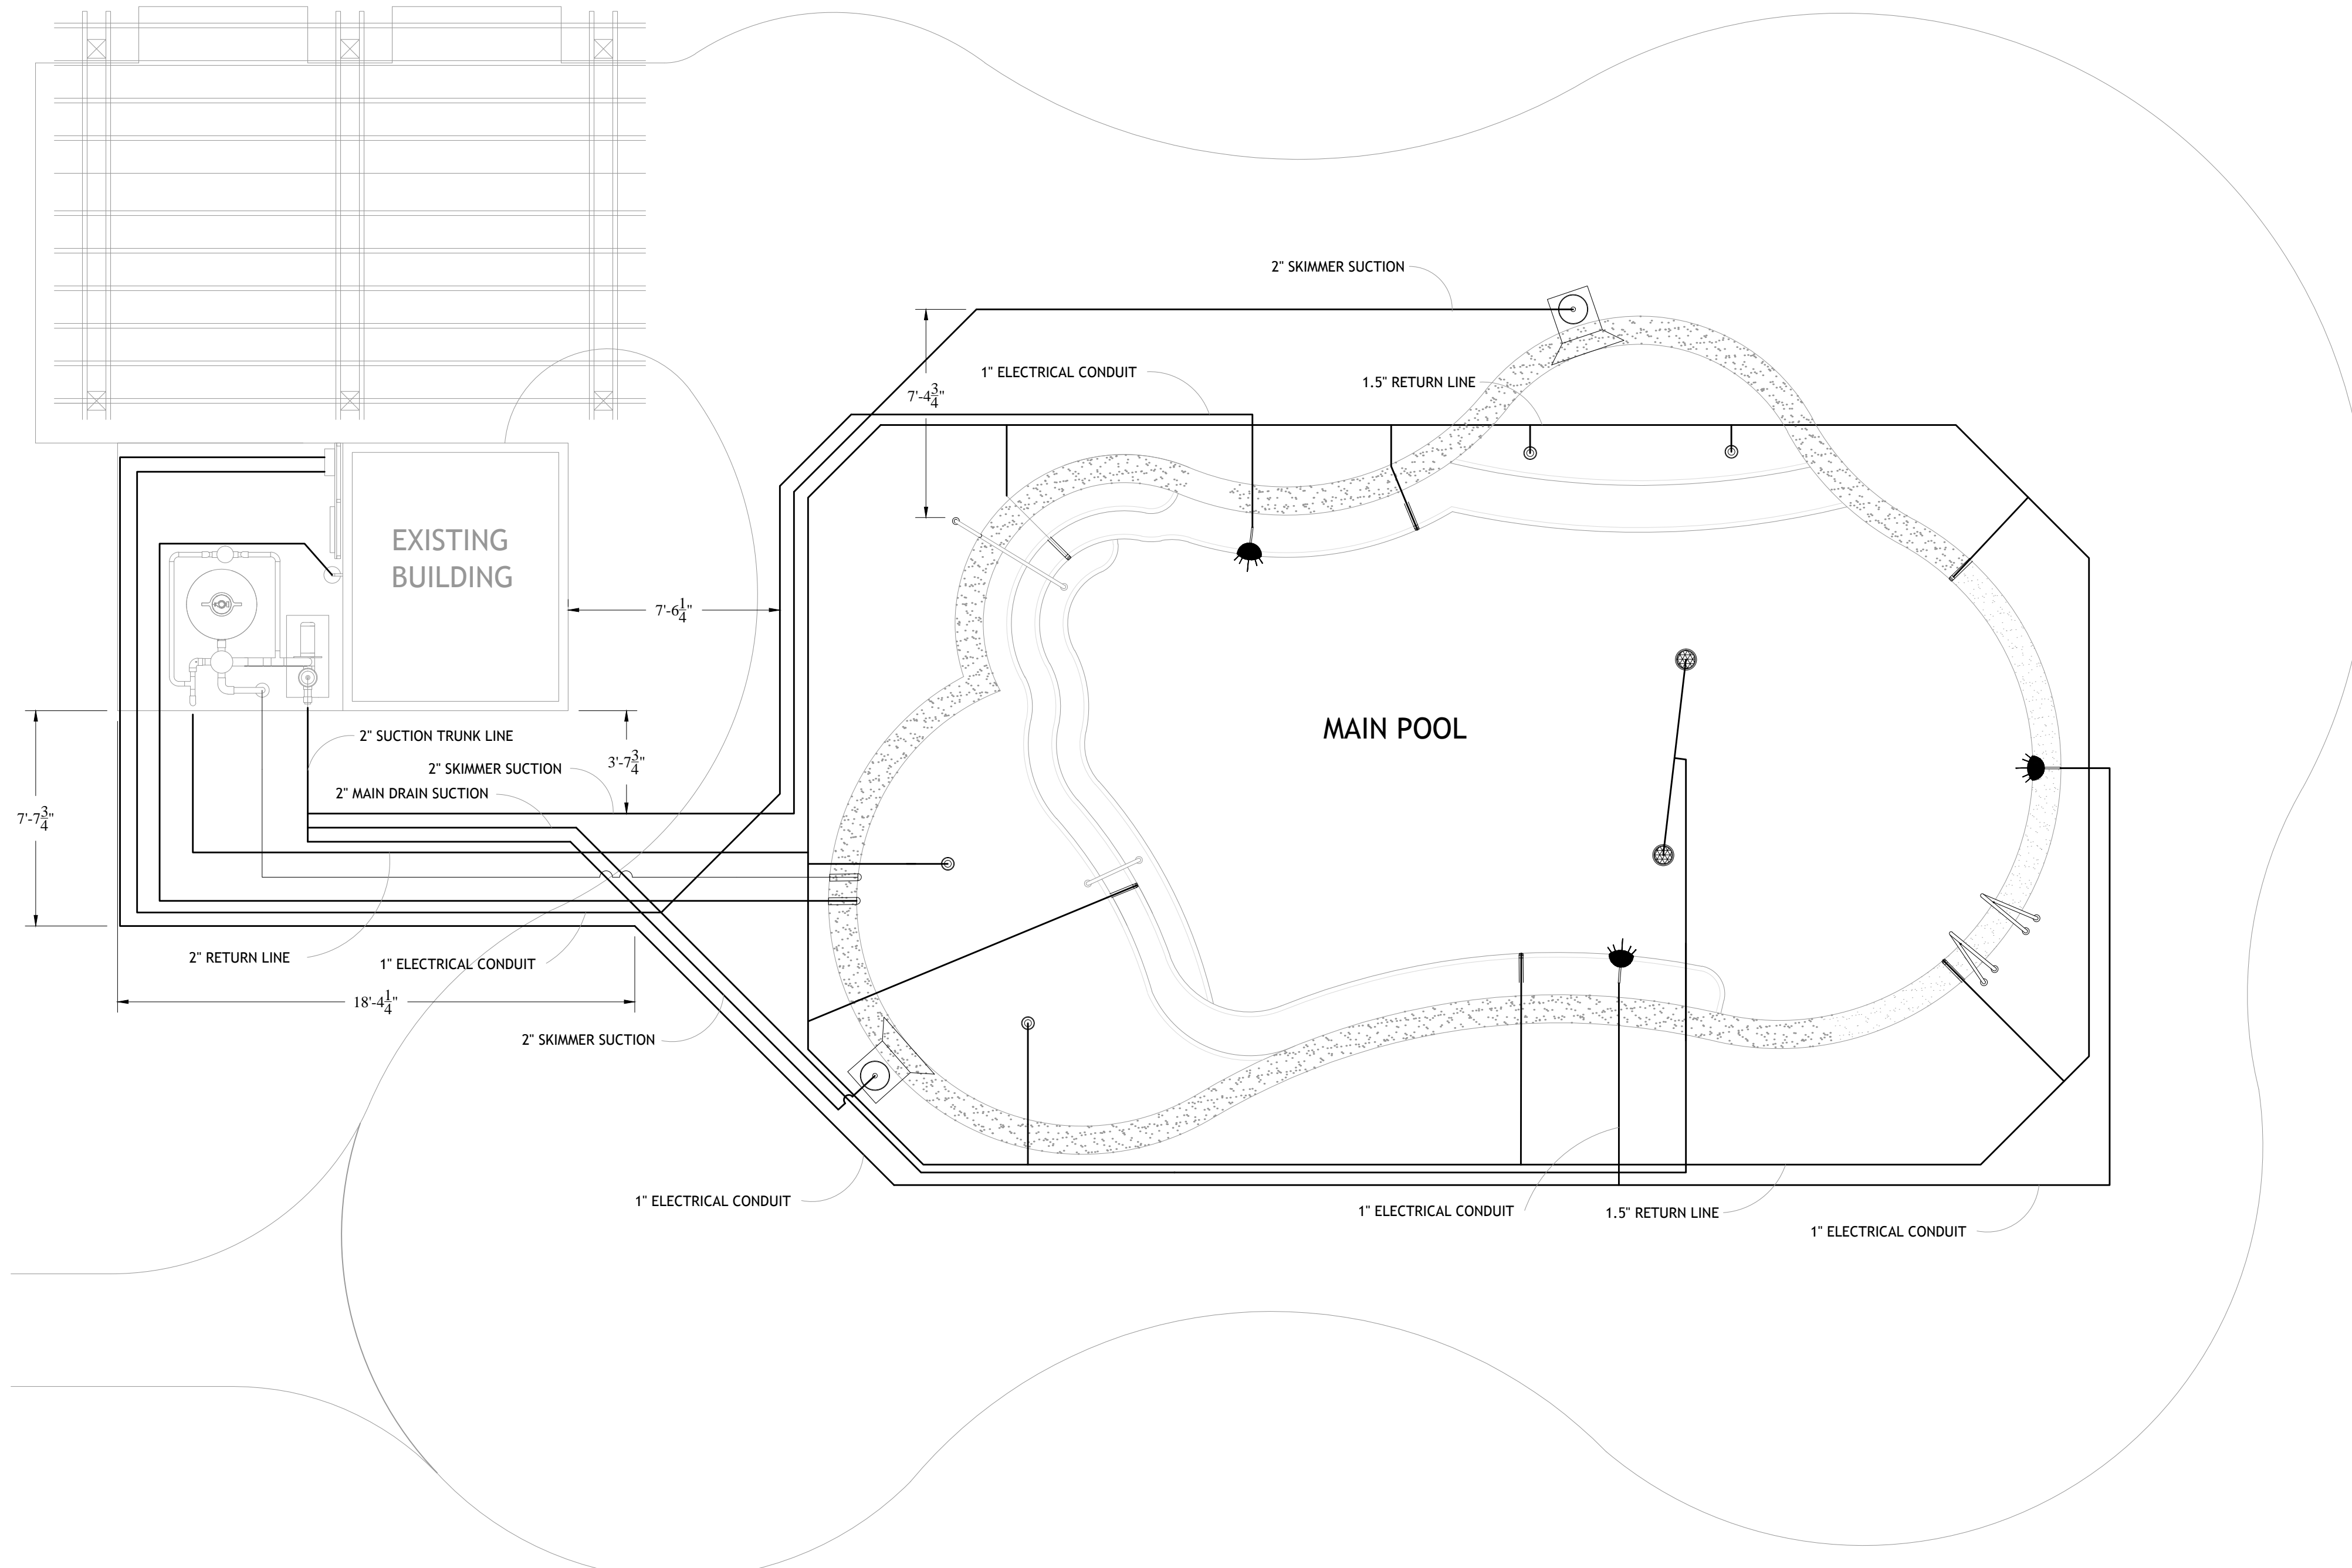

1 POOL PLUMBING AS-BUILTS  
AS-1.1 SCALE: 1/4" = 1'-0"

FILE: - XREFS: -

PLAN SYMBOL LEGEND

LADDER RAILS WITH ANCHORS AND ESCUTCHEON PLATES

POOL ENTRY HANDRAILS

EYEBALL WALL RETURN INLETS

UNDERWATER POOL LIGHTS

POOL SKIMMER RETURNS

POOL MAIN DRAINS (GRATE AND SUMP ASSEMBLY)

POOL DEPTH MARKERS AND NO DIVING SYMBOLS

OVER FLOW INLET / WATER SUPPLY INLET

894 ROBERT BOULEVARD  
SLIDELL, LOUISIANA 70458  
PH. 985-643-2427  
FAX 985-643-2691  
RROTOLD@ROTOLOCONSULTANTS.COM

LAKWOOD MANOR APARTMENTS  
LAKE AVENUE  
METAIRIE, LA.

Copyright 2015 © Rotolo Consultants Inc.  
These drawings or parts thereof, may not  
be reproduced in any form, by any method,  
for any purpose, without prior written  
consent from Rotolo Consultants Inc.  
Contact: Rod Rotolo 985.643.2427  
Project No: 82-14080-LA

Revisions:		
No:	Date:	Description:


Date: 8/11/2015  
Drawn: TJH  
Checked: MR  
Sheet Title:

POOL  
PLUMBING  
AS-BUILTS

Drawing No.


AS-1.2

Sheet No.  
3 of 4

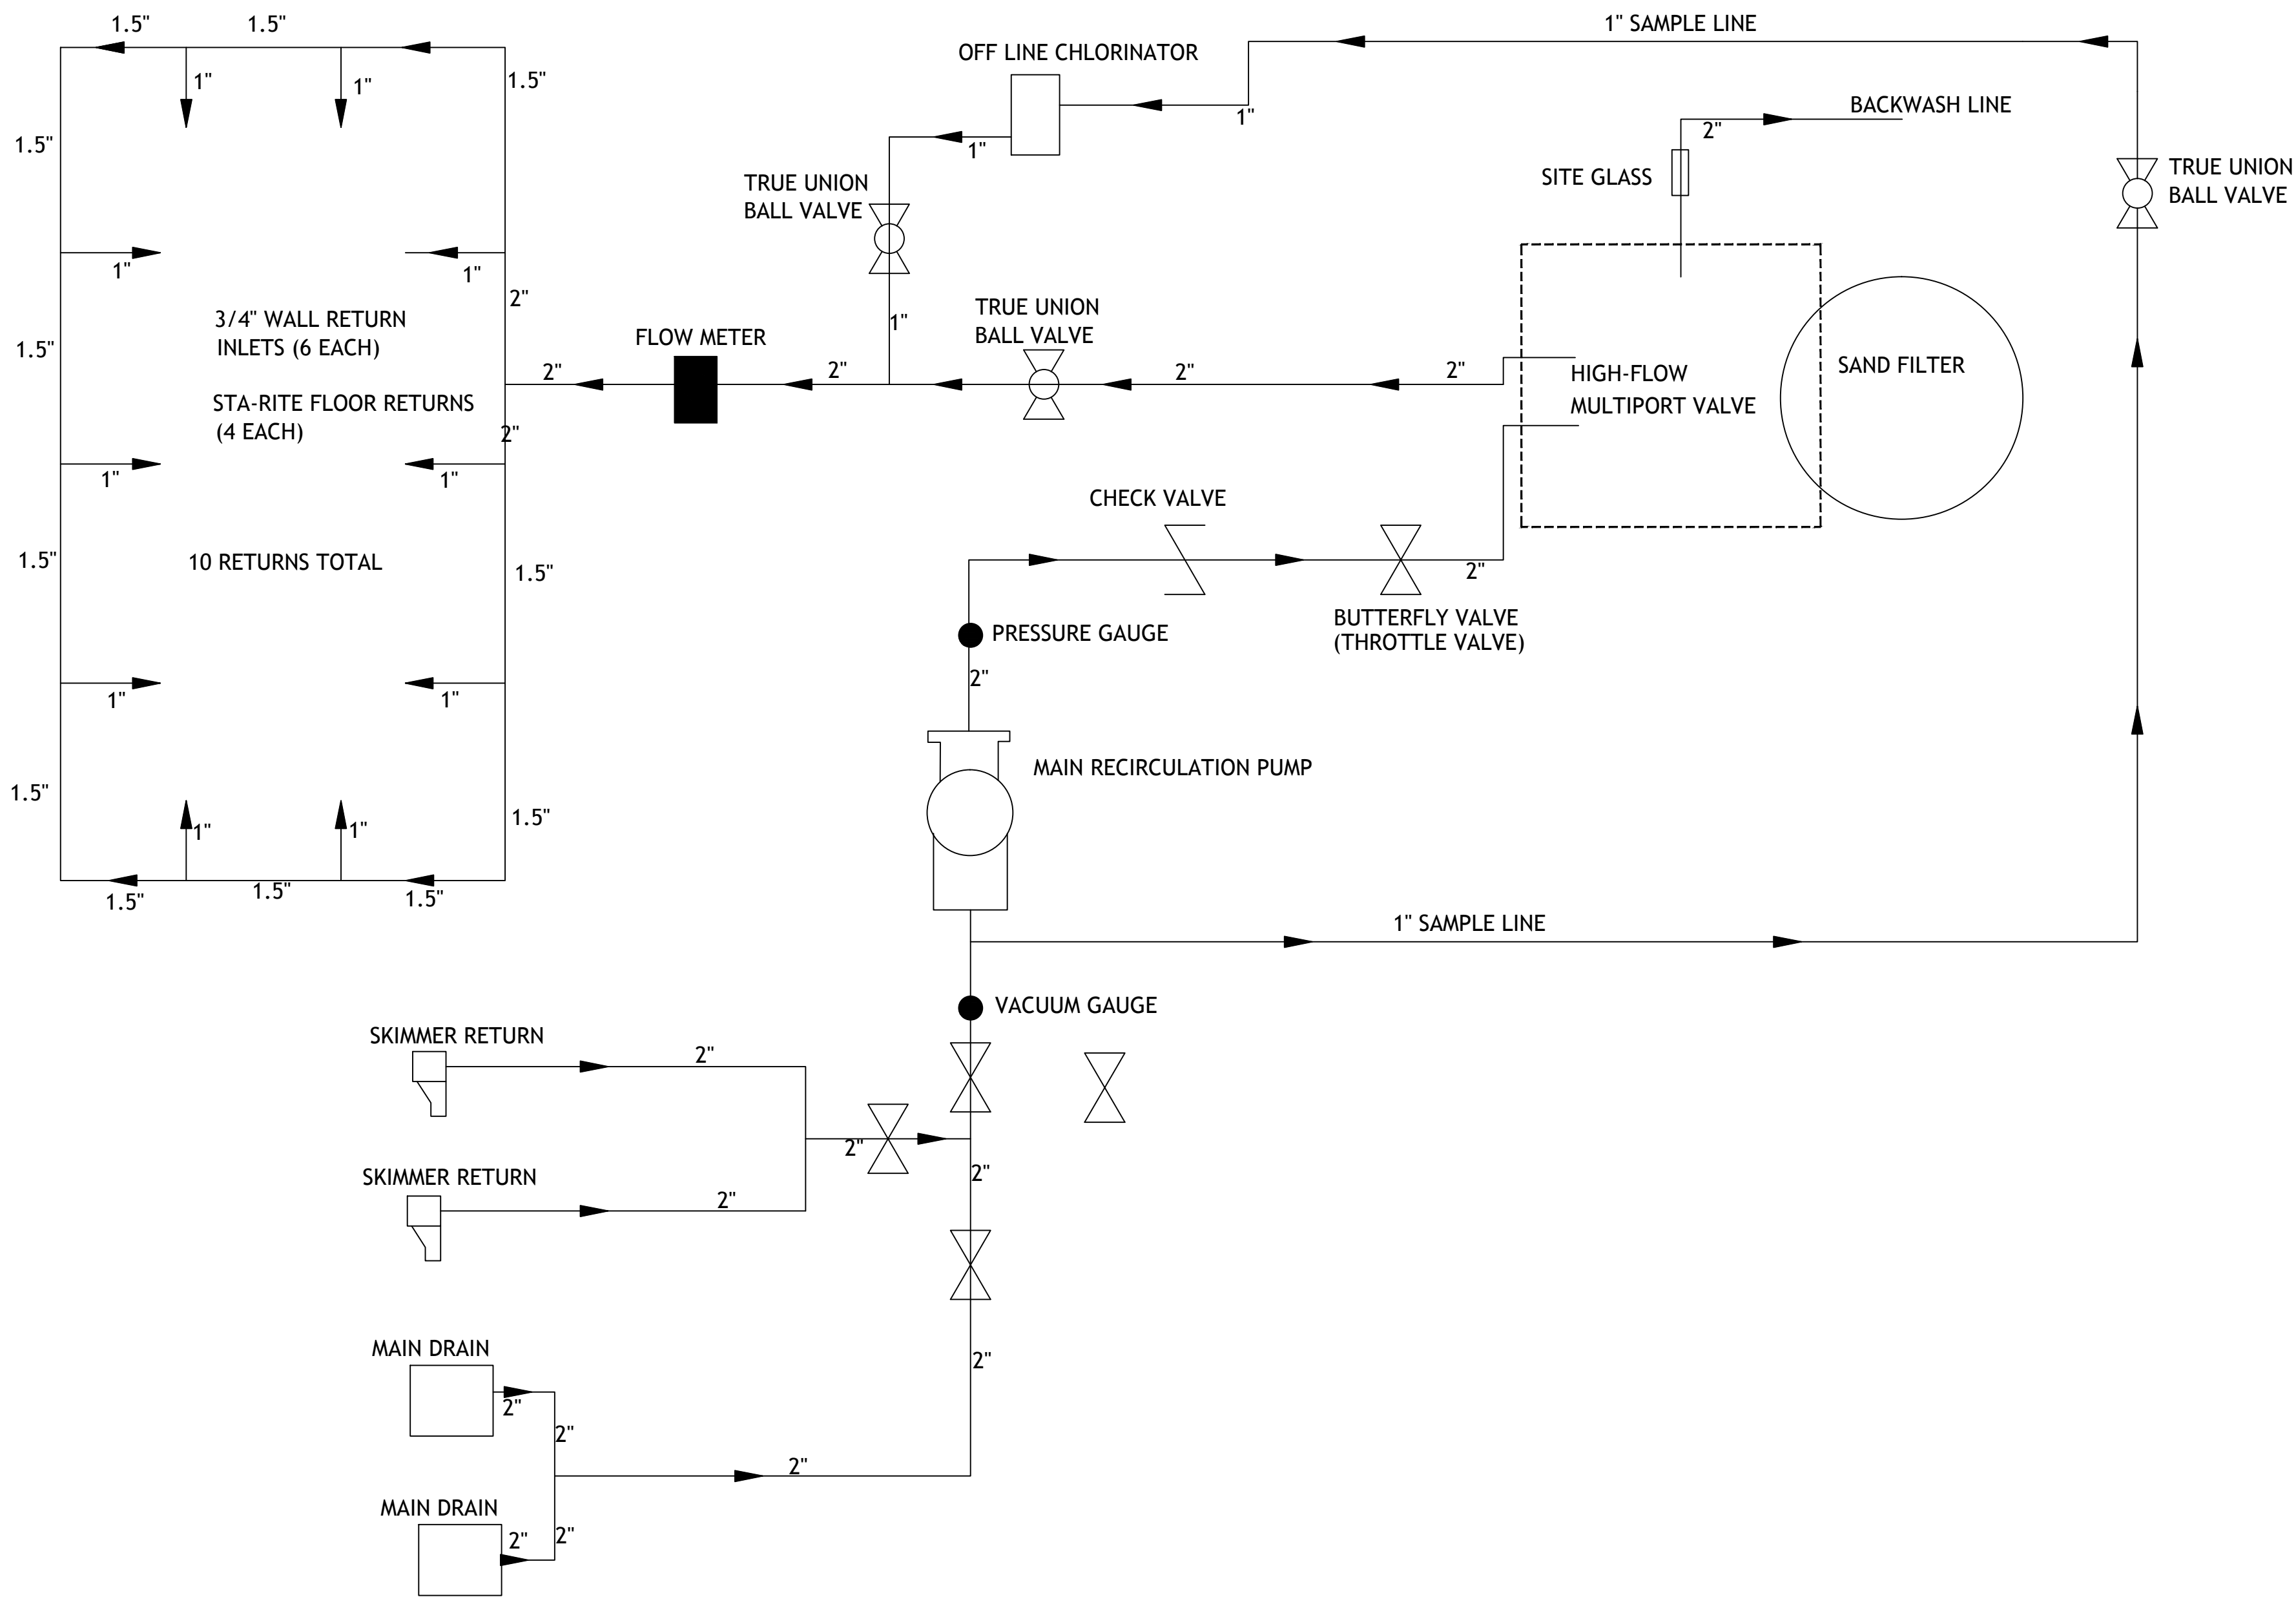

1 AS-1.2 POOL SYSTEM SCHEMATIC  
SCALE: NTS

EQUIPMENT LEGEND			
DESCRIPTION	MODEL	MANUFACTURER	NOTES/COMMENTS
3 BEND STAIR RAIL 54"	N/A	SR SMITH	SEE CUT SHEETS IN CLOSE-OUT PACKAGE
2 BEND STAIR RAIL 24"	N/A	SR SMITH	SEE CUT SHEETS IN CLOSE-OUT PACKAGE
CHALLENGER 1 HP PUMP	34620	PENTAIR	WARRANTY CARD & O&M PROVIDED
23" SAND FILTER	TR60	PENTAIR	WARRANTY CARD & O&M PROVIDED
INTELLICHLOR SALT CELL	IC20 - 520554	PENTAIR	WARRANTY CARD & O&M PROVIDED
INTELLICHLOR POWER CENTER	520556	PENTAIR	WARRANTY CARD &
DUAL TIMER	T10404R DPST	INTERMATIC	WARRANTY & O&M INCLUDED
POOL PLASTER - - FED. WHITE CEMENT - MARBLE DUST WHITE	37-0200 3200	TEHNO MIN	
MESSAGE TILE		INLAYS INC.	
DEPTH MARKER TILE		INLAYS INC.	
2"X2" KEYSTONE NOSING TILE	D204 ARTISAN BROWN SPECK	DAL-TILE	
1"X1" COLOR WAVE CLASSICS - MOSAIC	CW23 DOWN TOWN OASIS	DAL-TILE	
LATICRETE 1500 SERIES GROUT	BRIGHT WHITE 44	LATICRETE	
12"X4" BRICK COPING	BROWN FLASHED	NPT TILE	
U-3 SKIMMER	08650-1404	PENTAIR	WARRANTY CARD & O&M PROVIDED
POOL MISER WL	PM-01	LEVELOR	O&M PROVIDED W/ WARRANTY
AMERILITE 300 WATT 120 v W/ 150 FT CHORD	78927000	PENTAIR	WARRANTY CARD & O&M PROVIDED
IN-LINE CHLORINATOR	R17096	PENTAIR	WARRANTY CARD & O&M PROVIDED
STAINLESS STEEL LADDER	SRS-35-728	SR SMITH	WARRANTY PROVIDED

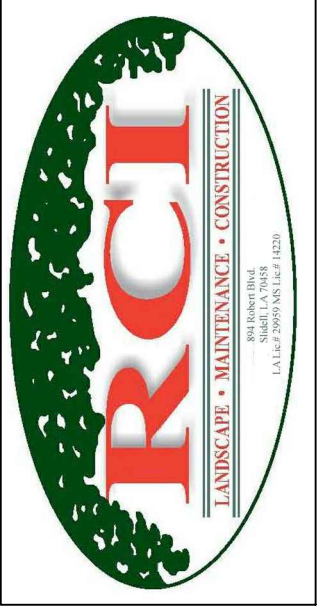

894 ROBERT BOULEVARD  
SLIDELL, LOUISIANA 70458  
PH. 985-643-2427  
FAX 985-643-2691  
RROTOLD@ROTOLOCONSULTANTS.COM

LAKWOOD MANOR APARTMENTS  
LAKE AVENUE  
METAIRIE, LA.

Copyright 2015 © Rotolo Consultants Inc.  
These drawings or parts thereof, may not be reproduced in any form, by any method, for any purpose, without prior written consent from Rotolo Consultants Inc.  
Contact: Rod Rotolo 985-643-2427  
Project No: 82-14080-LA

Revisions:		
No:	Date:	Description:

Date: 3/17/2015  
Drawn: TJH  
Checked: MR  
Sheet Title:

POOL SYSTEM SCHEMATIC & EQUIPMENT LEGEND

Drawing No.

AS-1.3

Sheet No.  
4 OF 4