


**CONSTRUCTION PLANS
FOR
BLUE MOUNTAIN ADDITION UNIT 1
SANITARY SEWER SYSTEM IMPROVEMENTS
FOR
CUMBERLAND GAP
GEAUX CORPORATION
TYLER, SMITH COUNTY, TEXAS
DECEMBER 2005**

"RECORD DRAWING" CERTIFICATION:


I CERTIFY THAT THE "RECORD DRAWING" INFORMATION SHOWN HEREON WAS OBTAINED UNDER MY DIRECT SUPERVISION AND IS CORRECT AND COMPLETE TO THE BEST OF MY KNOWLEDGE AND BELIEF. ADDITIONALLY, I HEREBY CERTIFY THAT ALL MAINS AND SERVICES HAVE BEEN INSTALLED WITHIN THE LIMITS OF DEDICATED TALL TIMBERS UTILITIES EASEMENTS OR INSIDE DEDICATED STREET RIGHT-OF-WAYS.

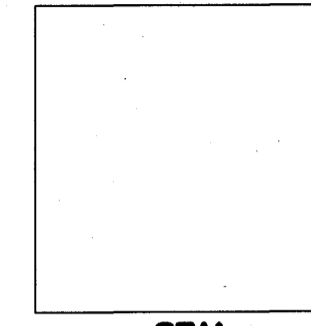

THE SEAL APPEARING ON THIS DOCUMENT WAS AUTHORIZED BY REA S. BOUDREAUX, P.E. ON 10/13/05. ALTERATION OF A SEALED DOCUMENT WITHOUT PROPER NOTIFICATION TO THE RESPONSIBLE ENGINEER IS AN OFFENSE UNDER THE TEXAS ENGINEERING PRACTICE ACT.

SHEET INDEX	
SHEET NO.	DESCRIPTION
SHEET 1	TITLE SHEET
SHEET 2	SURVEY PLAT
SHEET 3	GENERAL NOTES
SHEET 4	OVERALL PROJECT LIMITS
SHEET 5	OVERALL SEWER PLAN
SHEET 6	STORM WATER POLLUTION PREVENTION PLAN
SHEET 7-16	PLAN & PROFILE SHEETS
SHEET SS1	STANDARD SANITARY SEWER DETAIL
SHEET EC-1	EROSION CONTROL DETAIL SHEET
SHEET EC-2	EROSION CONTROL DETAIL SHEET

ESTIMATED QUANTITIES		
QUANTITY	UNIT	ITEM DESCRIPTION
2285	LF	6" SDR 26 PVC
755	LF	6" SDR 35 PVC
1390	LF	8" SDR 26 PVC
18	LF	8" DUCTILE IRON PIPE
13	EA	4' DIAMETER PRECAST CONCRETE SANITARY SEWER MANHOLE
2	EA	6" DIAMETER SANITARY SEWER CLEANOUT

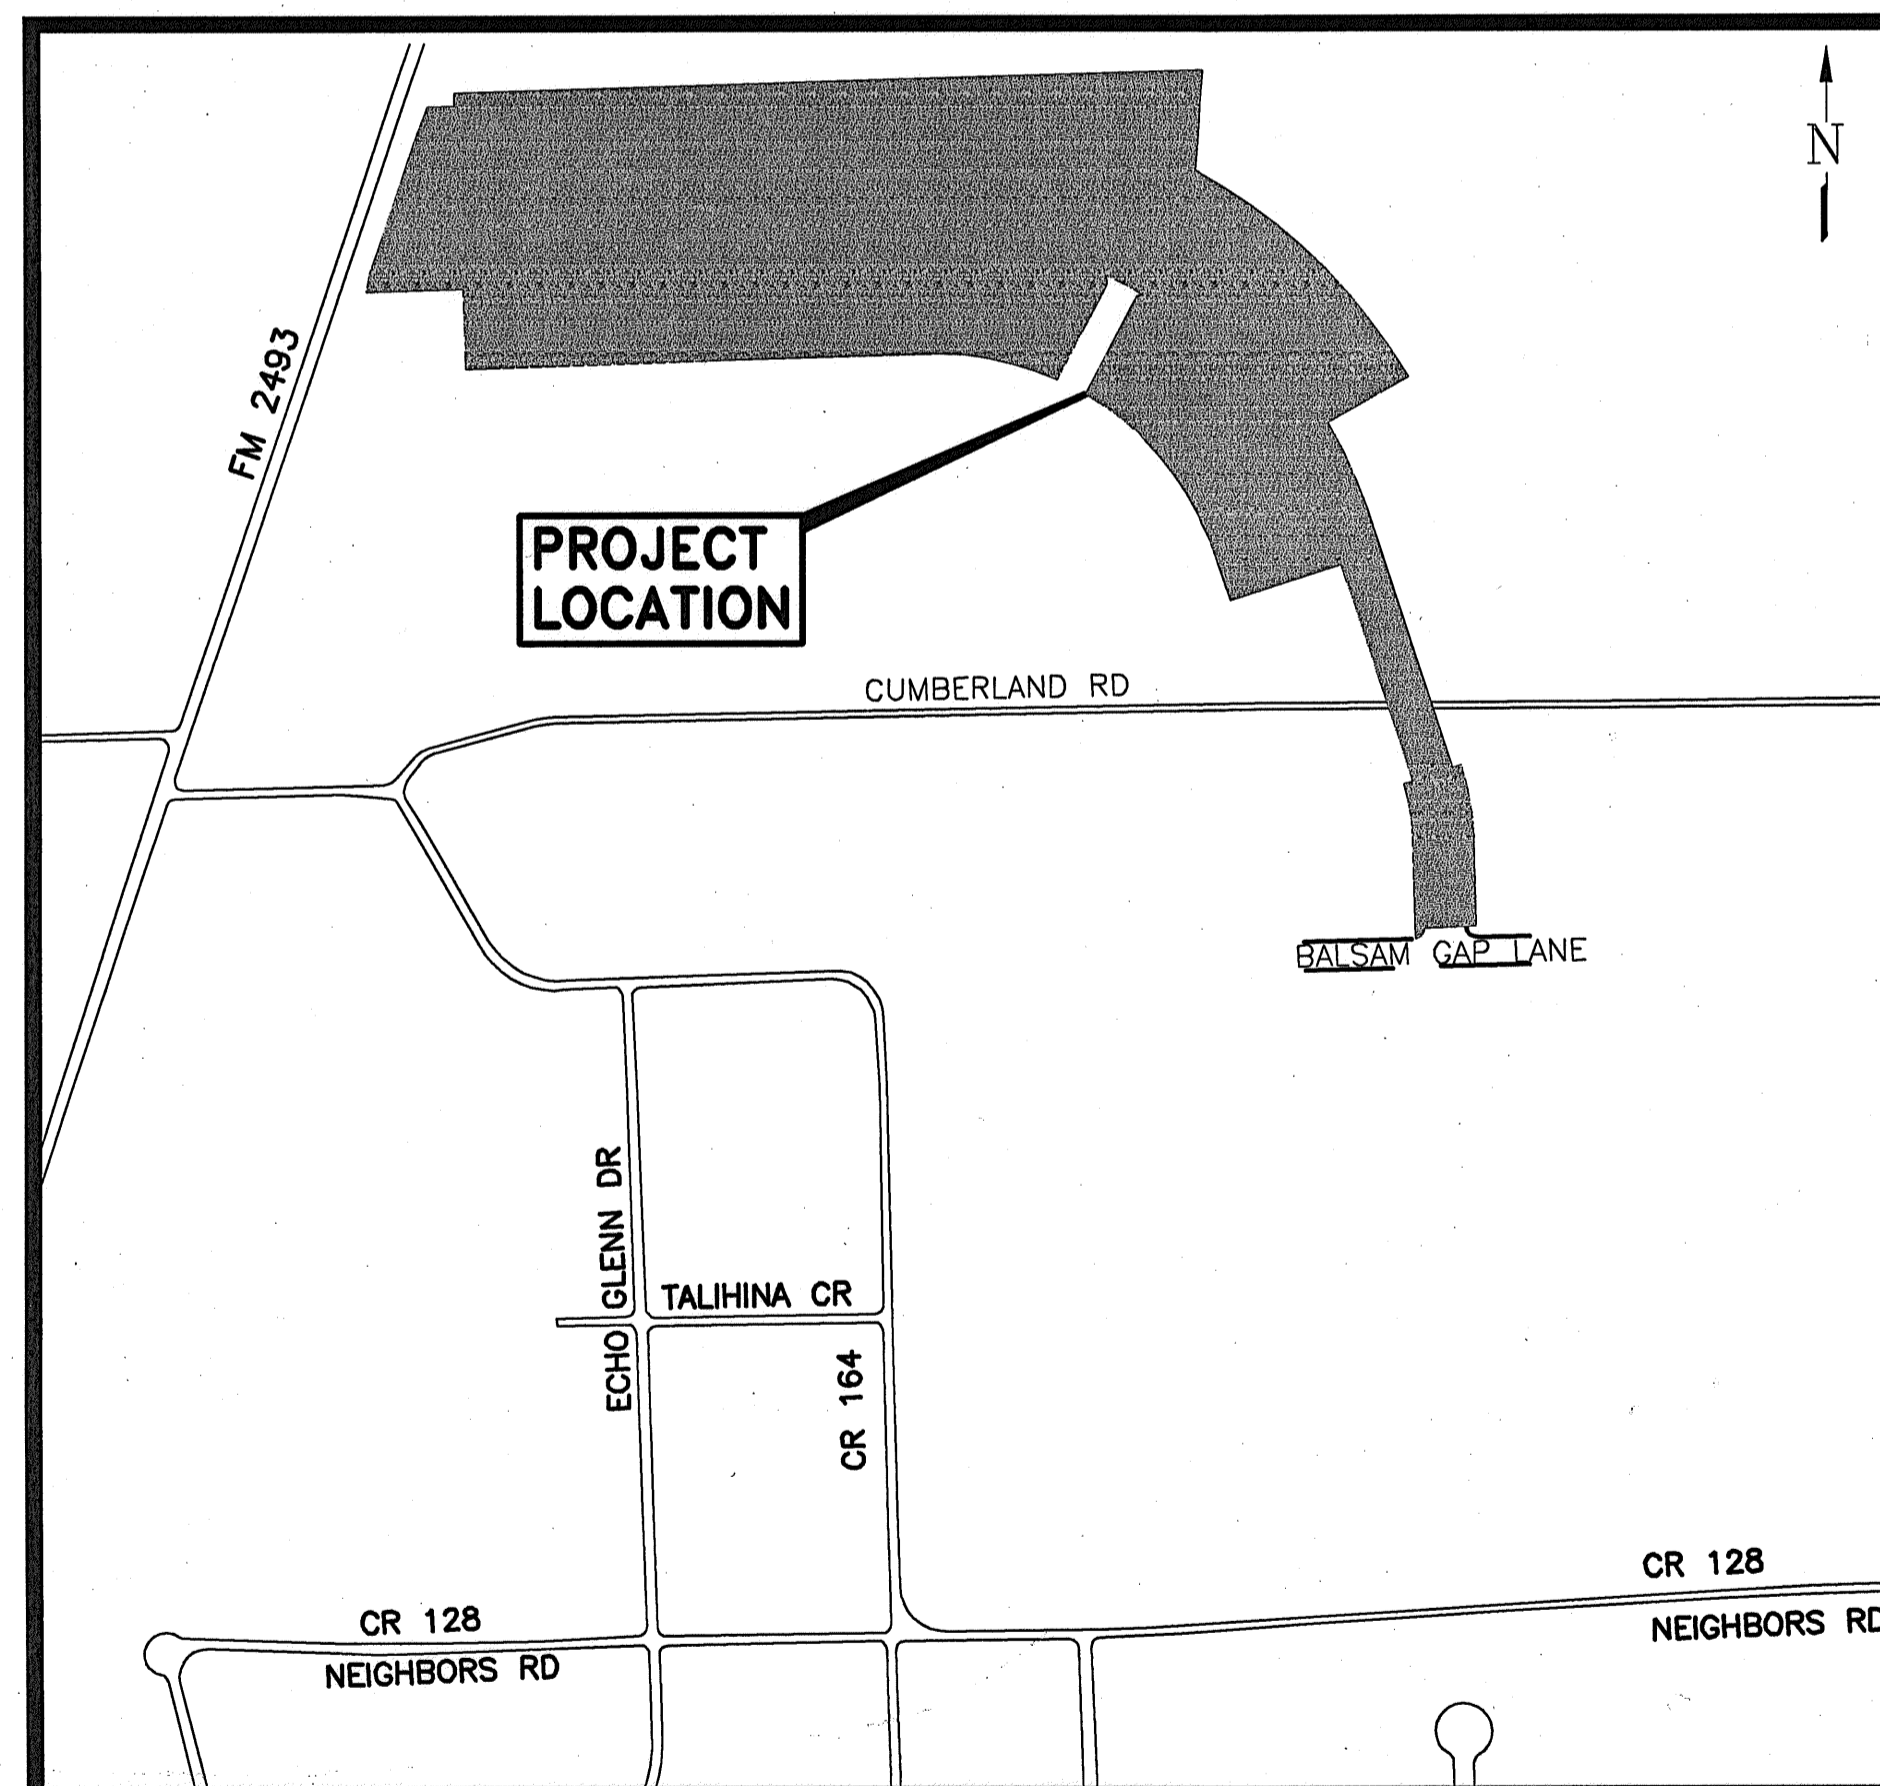

VICINITY MAP

MAYOR

JOEY SEEBER

CITY COUNCIL

- STEVE SMITH - DISTRICT 1
- JOYCE ARMSTRONG SCURRY - DISTRICT 2
- DERRICK CHOICE - DISTRICT 3
- CHRIS SIMONS - DISTRICT 4
- NATHANIEL MORAN - DISTRICT 5
- CHARLES ALWORTH - DISTRICT 6

CITY MANAGER

BOB TURNER

ACCORDING TO THE "UNDERGROUND FACILITY DAMAGE PREVENTION & SAFETY ACT, SECTION 9" IT IS THE RESPONSIBILITY OF THE CONTRACTOR TO CONTACT TEXAS ONE CALL AT 1-800-245-4545 A MINIMUM OF 48 HOURS PRIOR TO BEGINNING ANY EXCAVATION ACTIVITIES.

Rea S. Boudreaux
REA S. BOUDREAUX, P.E.
THE C.T. BRANNON CORPORATION

JANUARY 23, 2006
DATE

DAN PEDEN, P.E.
CITY ENGINEER

MICHAEL WILSON, P.E.
UTILITIES ENGINEER
TYLER WATER UTILITIES

GREGORY M. MORGAN, P.E.
OPERATION MANAGER
TYLER WATER UTILITIES

TBM-1 ELEVATION 511.28
 TOP OF THE LETTERS "OPEN" ON TOP FLANGE OF FH AT ± 118' EAST ALONG THE CL OF CR164 AND ± 100' NORTH PERPENDICULAR DISTANCE FROM THE CL OF CR164.

TBM-2 ELEVATION 509.39
 TOP OF A "TYPE II" FLOOT BRASS DISC IN CONCRETE ON THE EAST SIDE OF FM2493 AND ± 100' NORTH PERPENDICULAR DISTANCE FROM THE CL OF CR164, 8' SOUTH OF FH (TBM-1) AND 1.2' WEST OF A PP.

TBM-3 ELEVATION 528.71
 TOP OF A BRASS CAP IN TOP OF CONCRETE HEADWALL OF SAFETY END TREATMENT AT THE NORTH END OF AN 18" RCP UNDER THE ASPHALT DRIVE TO LANES CHAPEL UNITED METHODIST CHURCH ON THE EAST SIDE OF FM2493.

TBM ELEVATION 506.55
 604 NAIL IN 18" SAND JACK AT 12+64-45' RIGHT, SOUTH OF THE INTERSECTION OF BALSAM GAP LANE AND BLUE MOUNTAIN BLVD.

BY: _____ DATE _____
TALL TIMBERS UTILITIES

DESIGNED BY: RSB
 DRAWN BY: JJV
 CHECKED BY: RSB
 DATE: DECEMBER 2005
 SCALE: AS SHOWN

The Brannon Corporation

•
**ENGINEERS,
 SURVEYORS,
 & URBAN
 PLANNERS**

•
 1321
 SOUTH
 BROADWAY

•
 TYLER, TEXAS
 75701
 (803) 587-2122
 (803) 587-3348 FAX

**CONSTRUCTION PLANS
 BLUE MOUNTAIN ADDITION, UNIT 1
 SANITARY SEWER SYSTEM
 CUMBERLAND GAP
 TYLER, SMITH COUNTY, TEXAS**

REVISIONS		
NO.	DATE	REMARKS

CONTRACT NO. 05012
 SHEET NO. **1**

© COPYRIGHT 2005 THE C.T. BRANNON CORPORATION. UNAUTHORIZED REUSE OR REPRODUCTION IS PROHIBITED. 05012-01-TITLE