




INSET "A"

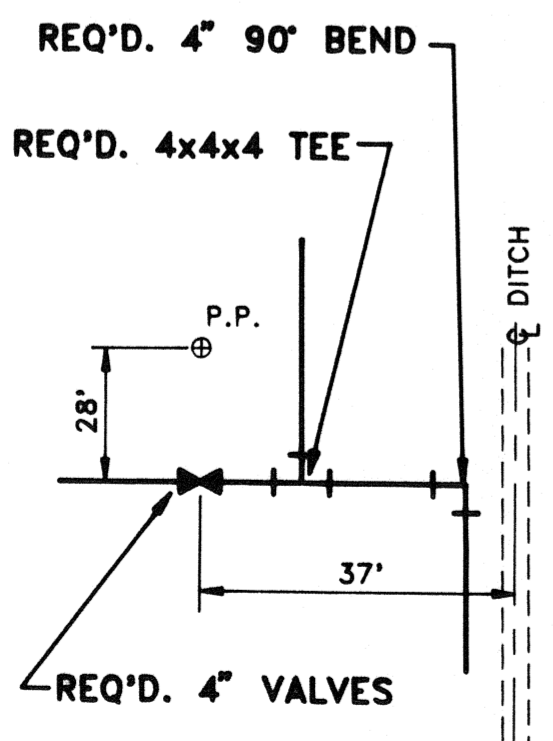

INSET "B"

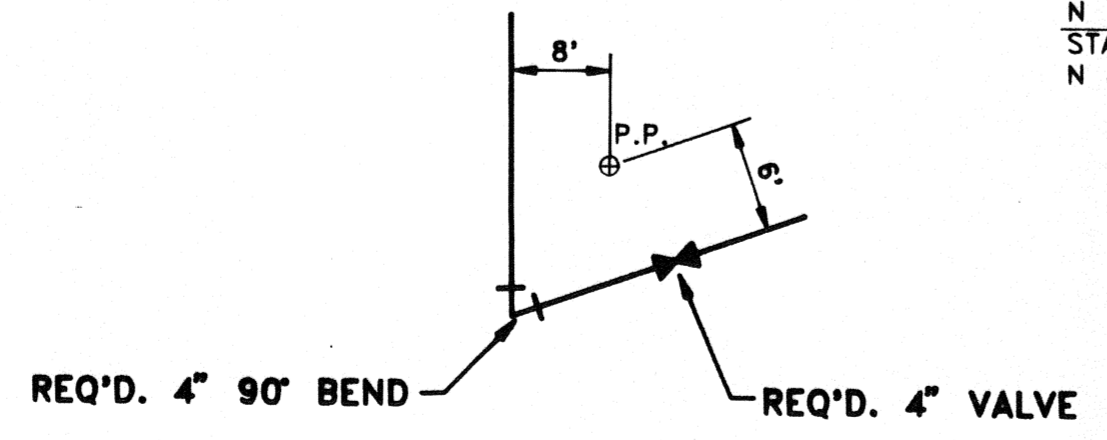

INSET "C"

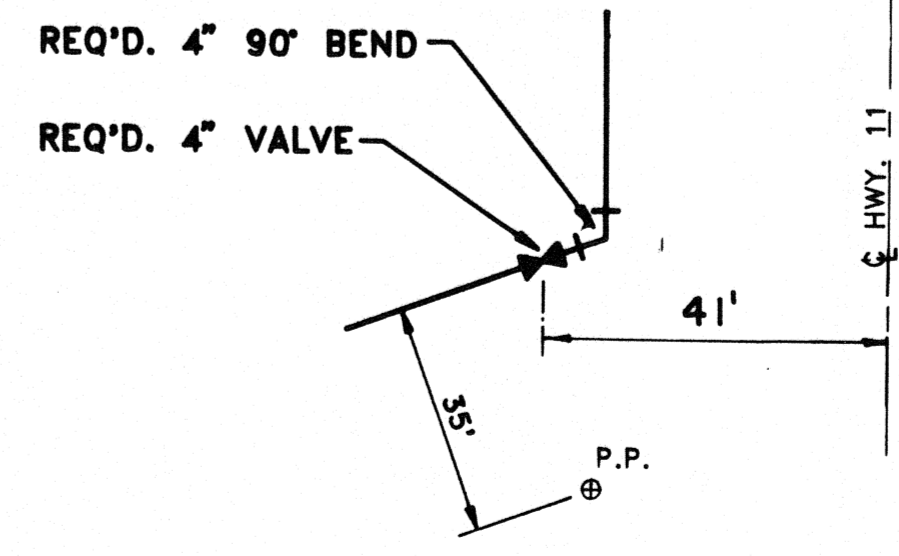

INSET "D"

No.	DATE	REVISIONS	REMARKS

NY ASSOCIATES, INC.
 CONSULTING ENGINEERS
ARCHITECTS, LTD.
 ARCHITECTS & PLANNERS
 2700 LAKE VILLA DRIVE
 METAIRIE, LA 70002

DESIGNED BY: R.A.C.
 DRAWN BY: S.T.P.
 CHECKED BY: E.W.D.
 CHIEF DRAFTSMAN: E.W.D.
 PROJECT MGR.: R.A.C.
 APPROVED BY: T.L.J.
 DATE: NOVEMBER, 1990

STAMP

ALTON WATER SYSTEM
 ALTON, LOUISIANA
 PREPARED FOR
ST. TAMMANY POLICE JURY

JOB No. **88017.02**
 SCALE: **1" = 40'**
 SHEET NUMBER
7 OF 11

RECORD DRAWING 7-23-92
DATE

PLAN SHEET