



ELEVATION ON LINE B-B
SCALE 1/4" INCH = 1' FOOT

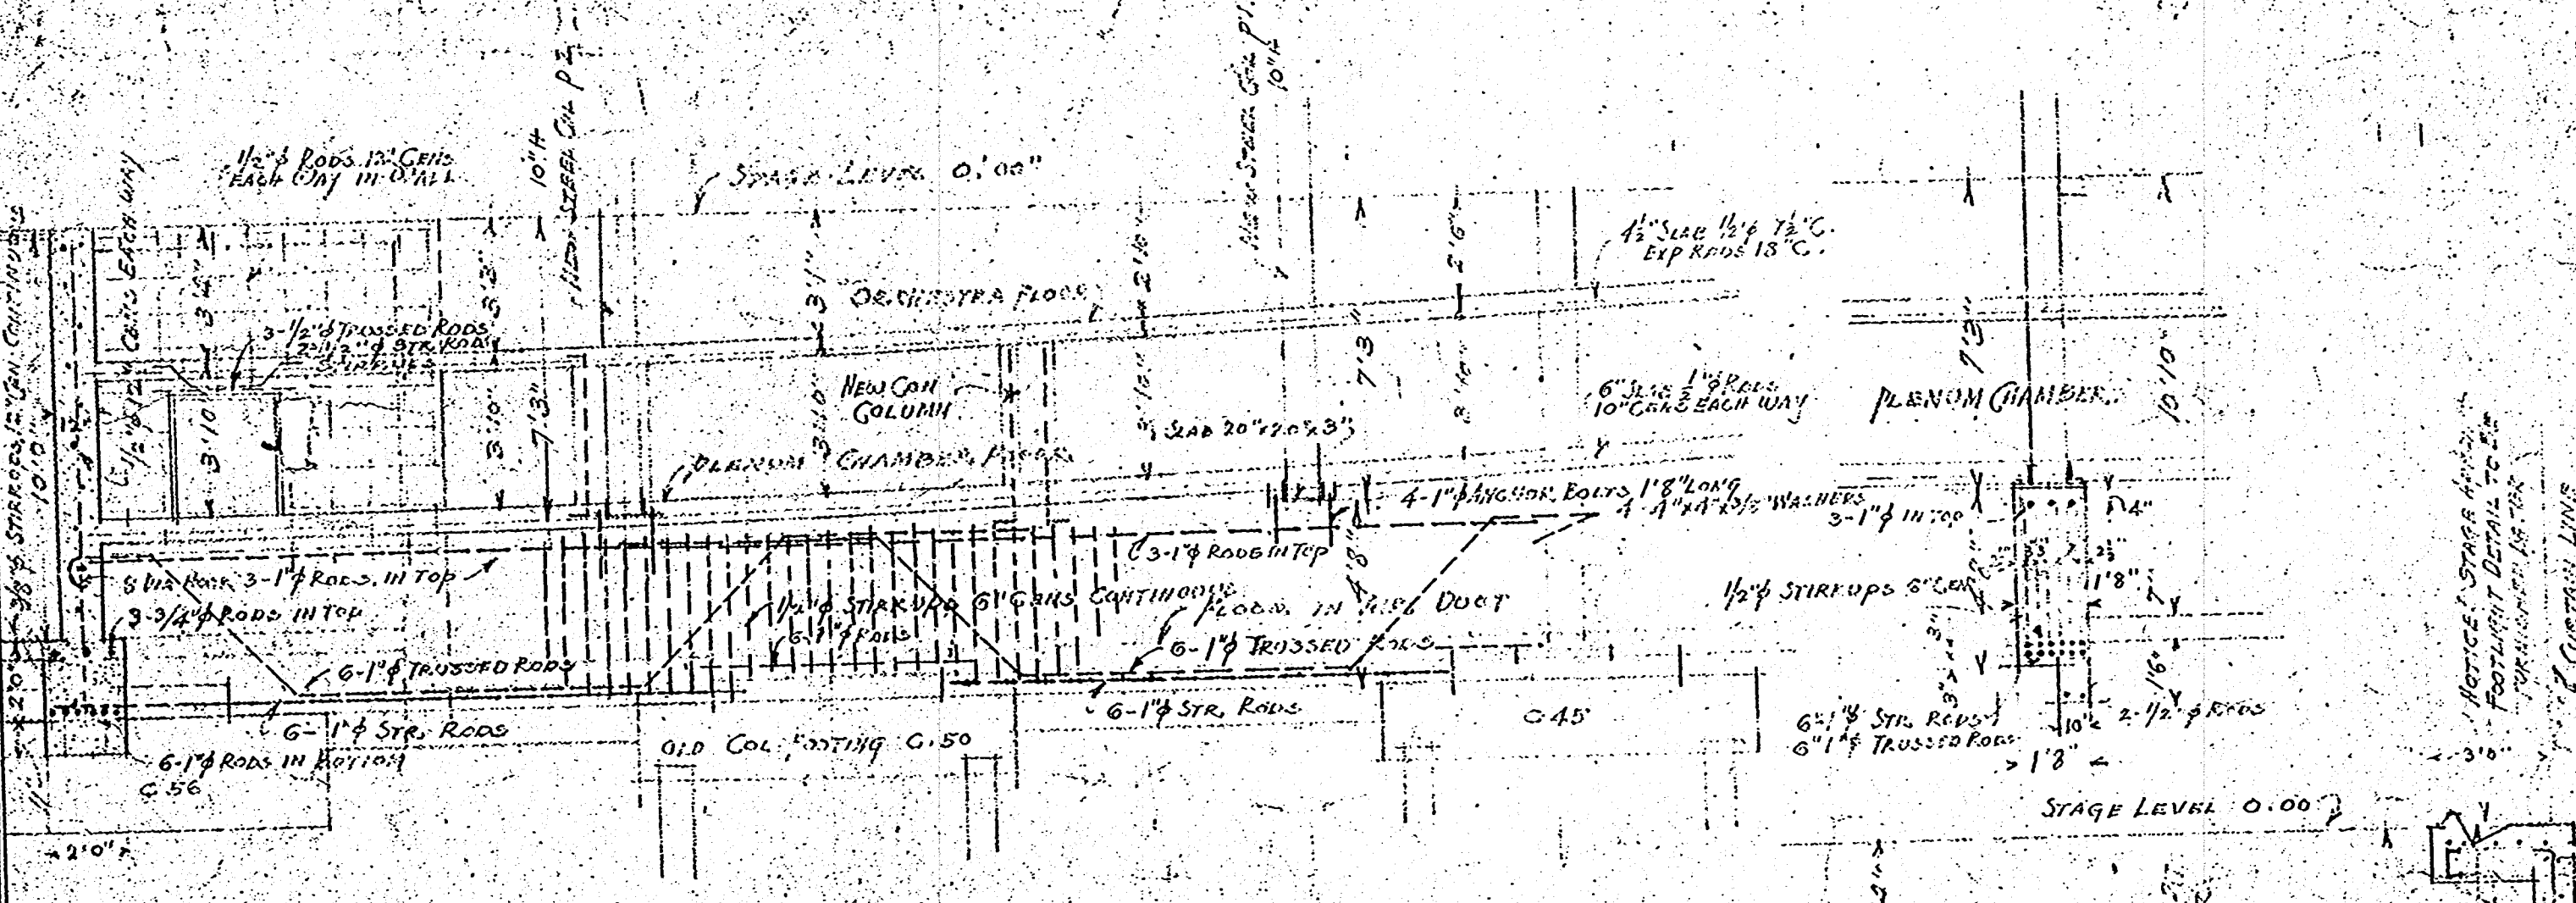


ELEVATION ON BEAM ON LINE C-C

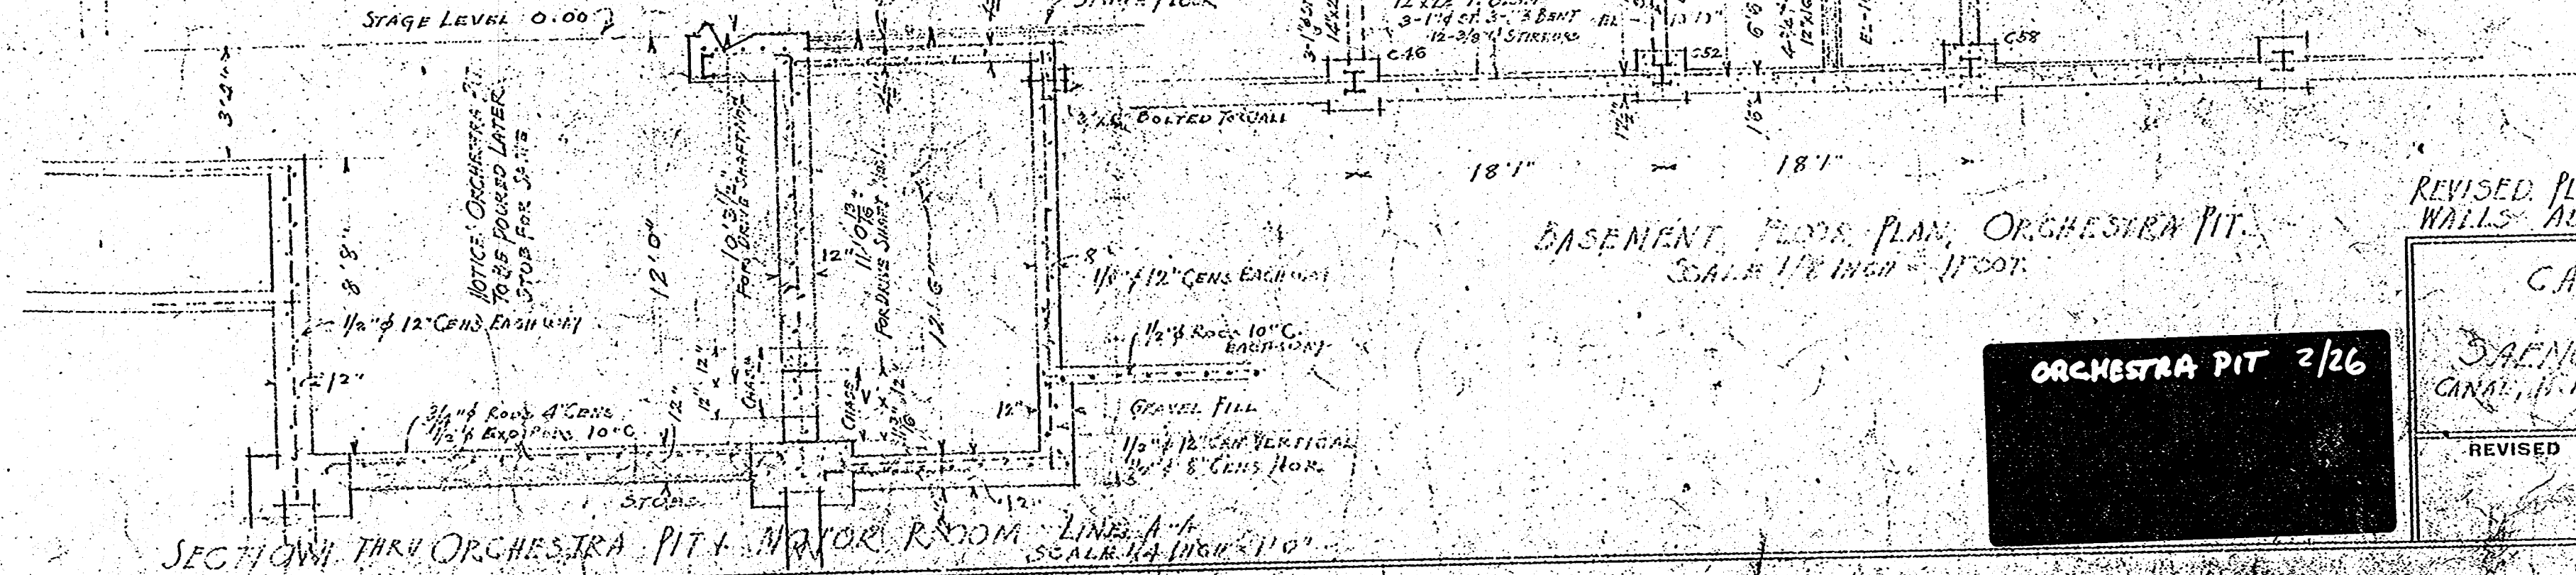

BASEMENT FLOOR PLAN, ORCHESTRA PIT
SCALE 1/2" INCH = 1' FOOT

SECTION THRU ORCHESTRA PIT & MAJOR ROOM LINE A-A
SCALE 1/4" INCH = 1' FOOT

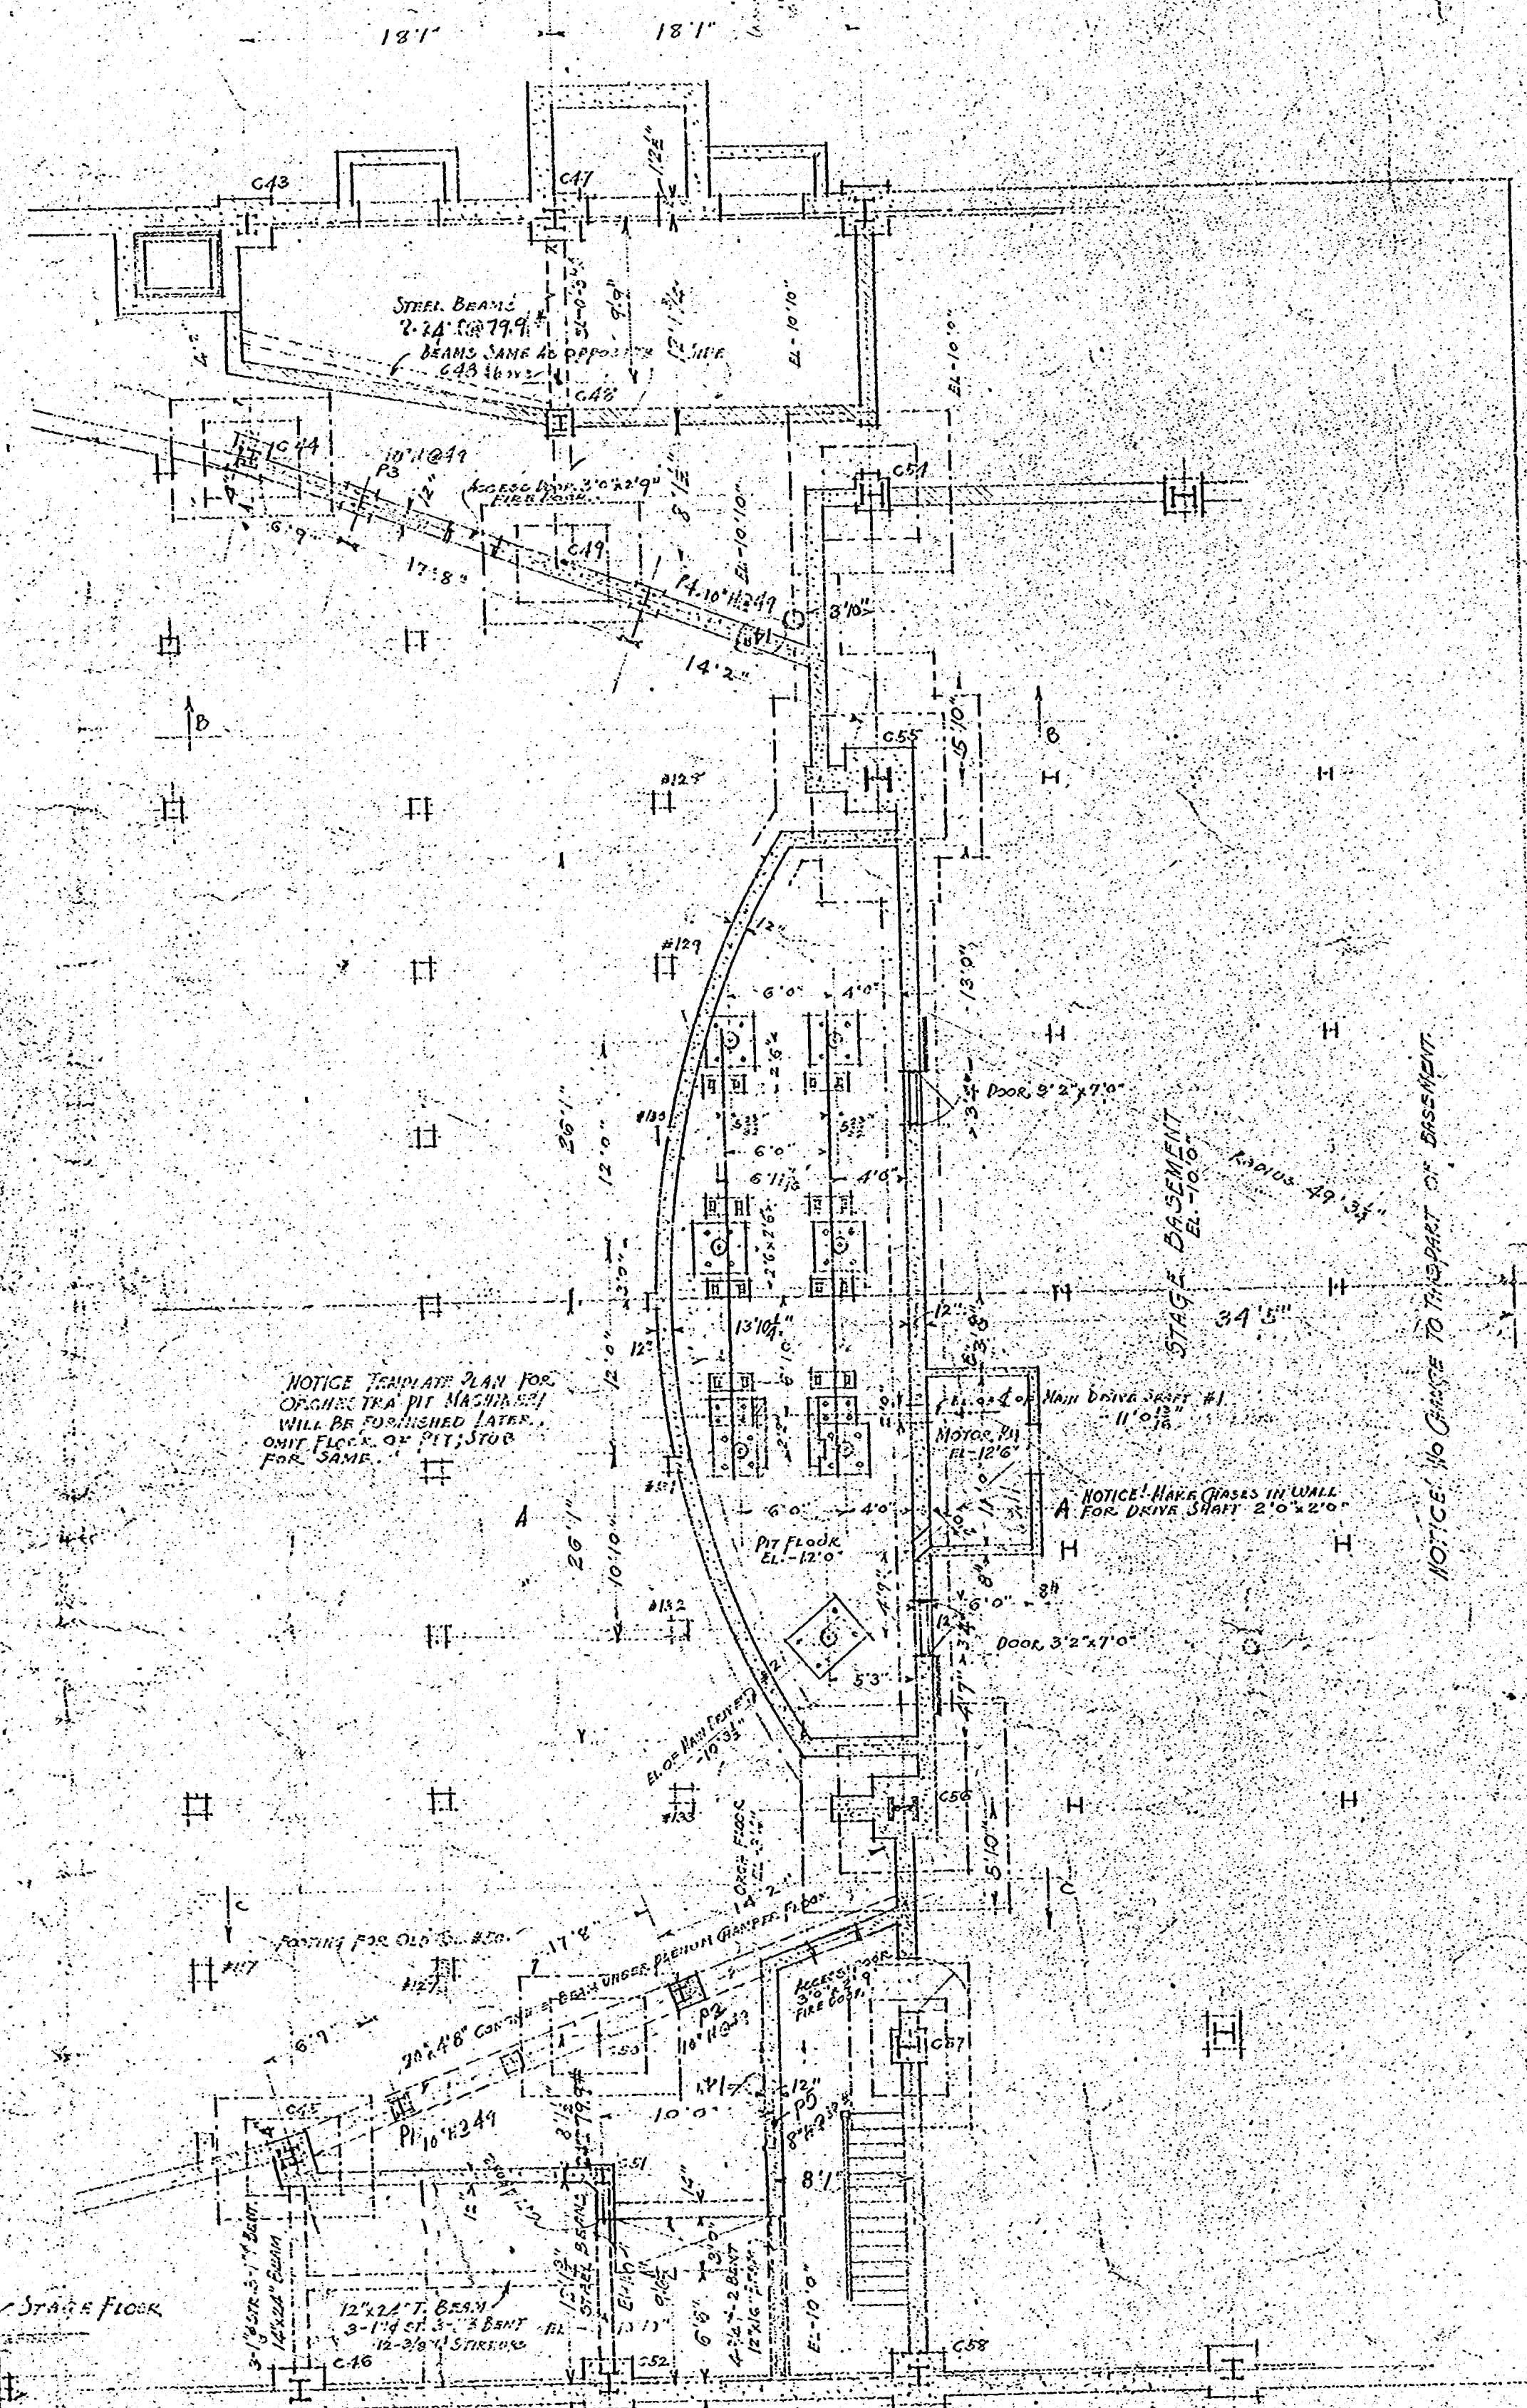

REVISED PLAN OF ORCHESTRA PIT & CHANGES TO WALLS ADJACENT TO SAME.

CANAL STREET THEATRE
FOR
SAENGER THEATRE CO.
CANAL ST. RAMPART, BERTRAND ST. & CANAL ST.
NEW ORLEANS, LA.

ORCHESTRA PIT 2/26

REVISOR
EMILE WEIL ARCHITECT
WHITNEY CENTRAL BUILDING
NEW ORLEANS, LA.

PLAN SHEET
391
022
DATE