

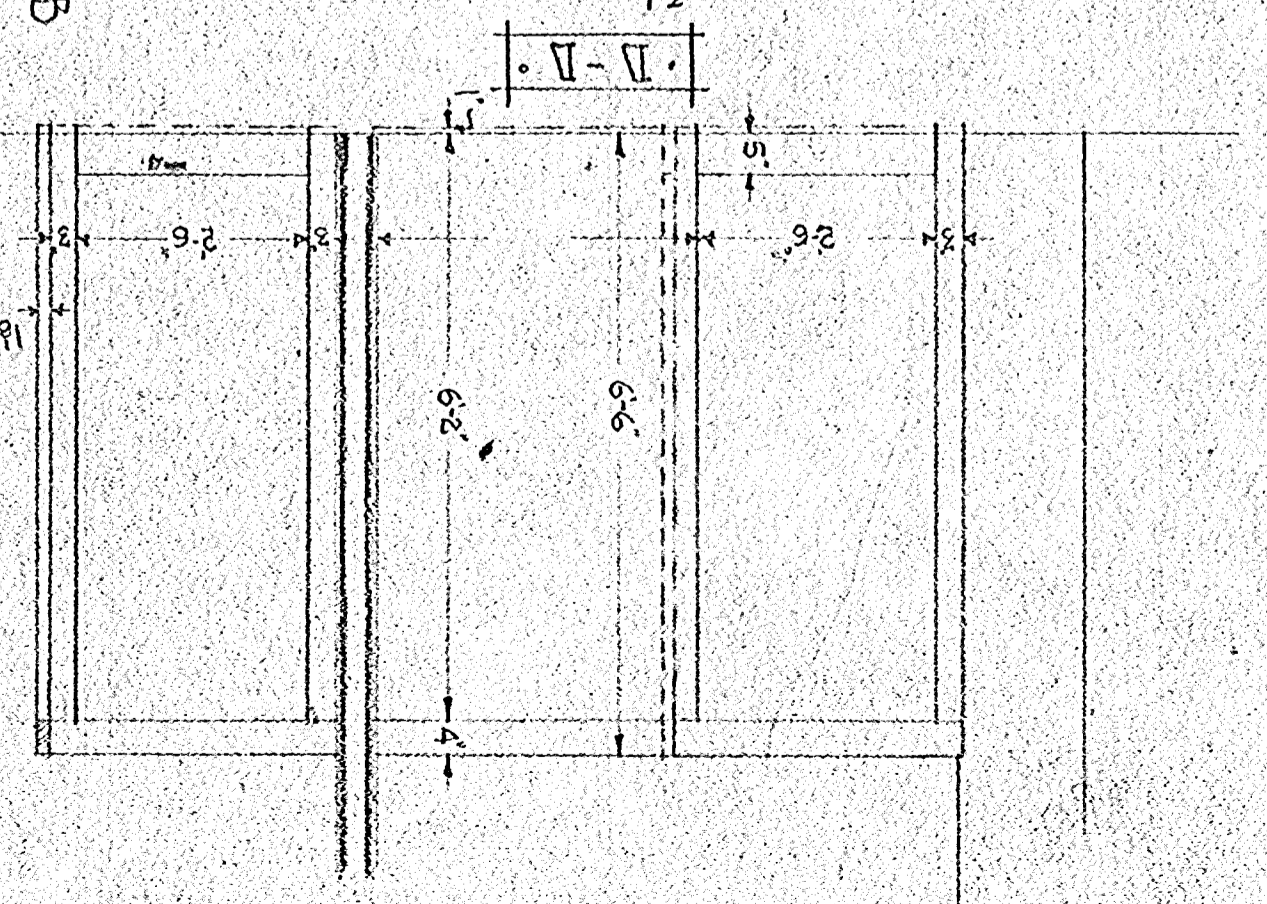


A-A

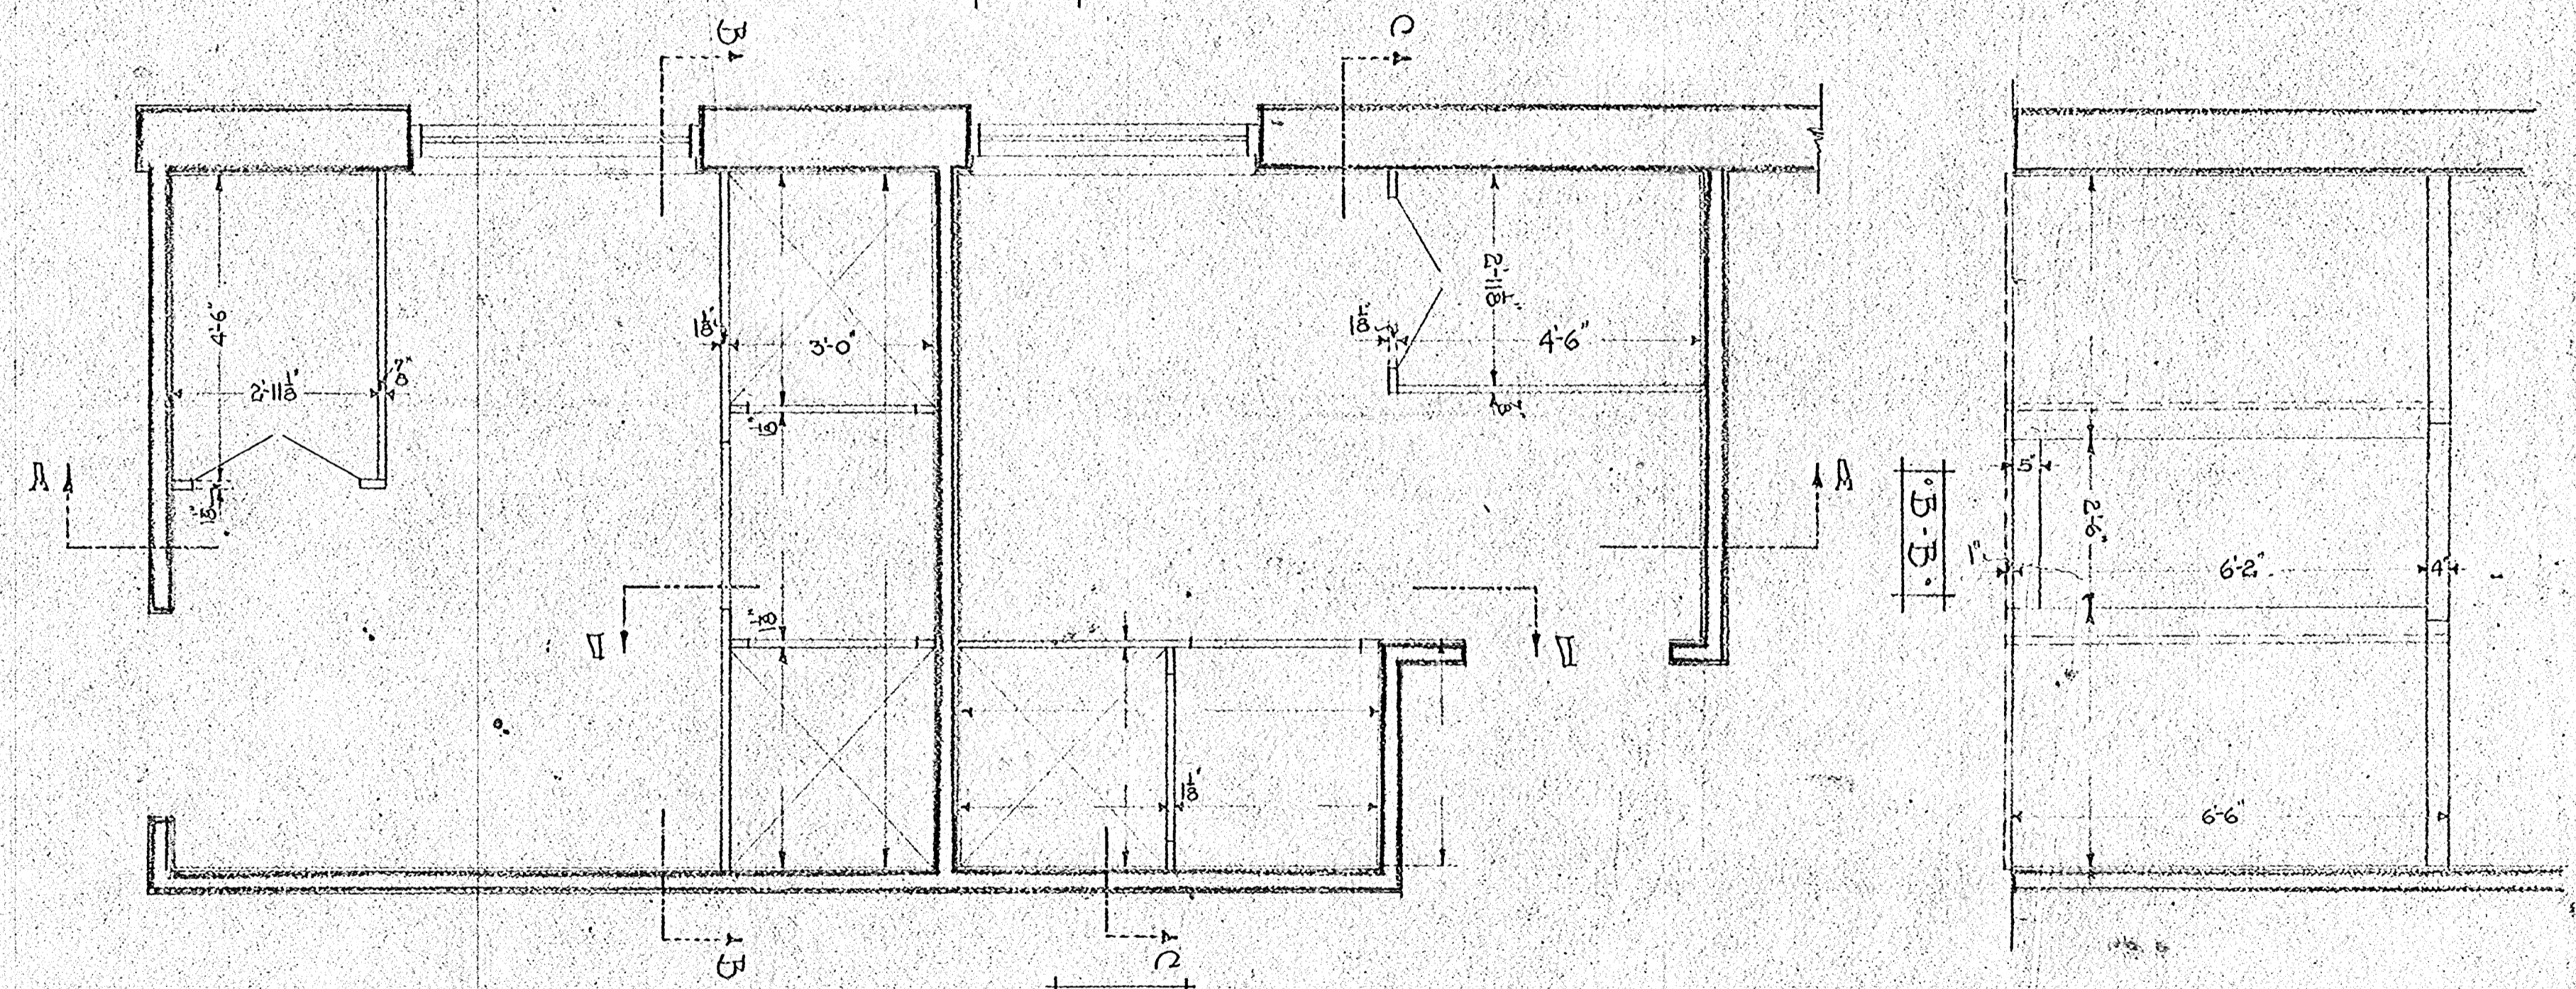

B-B

B-B

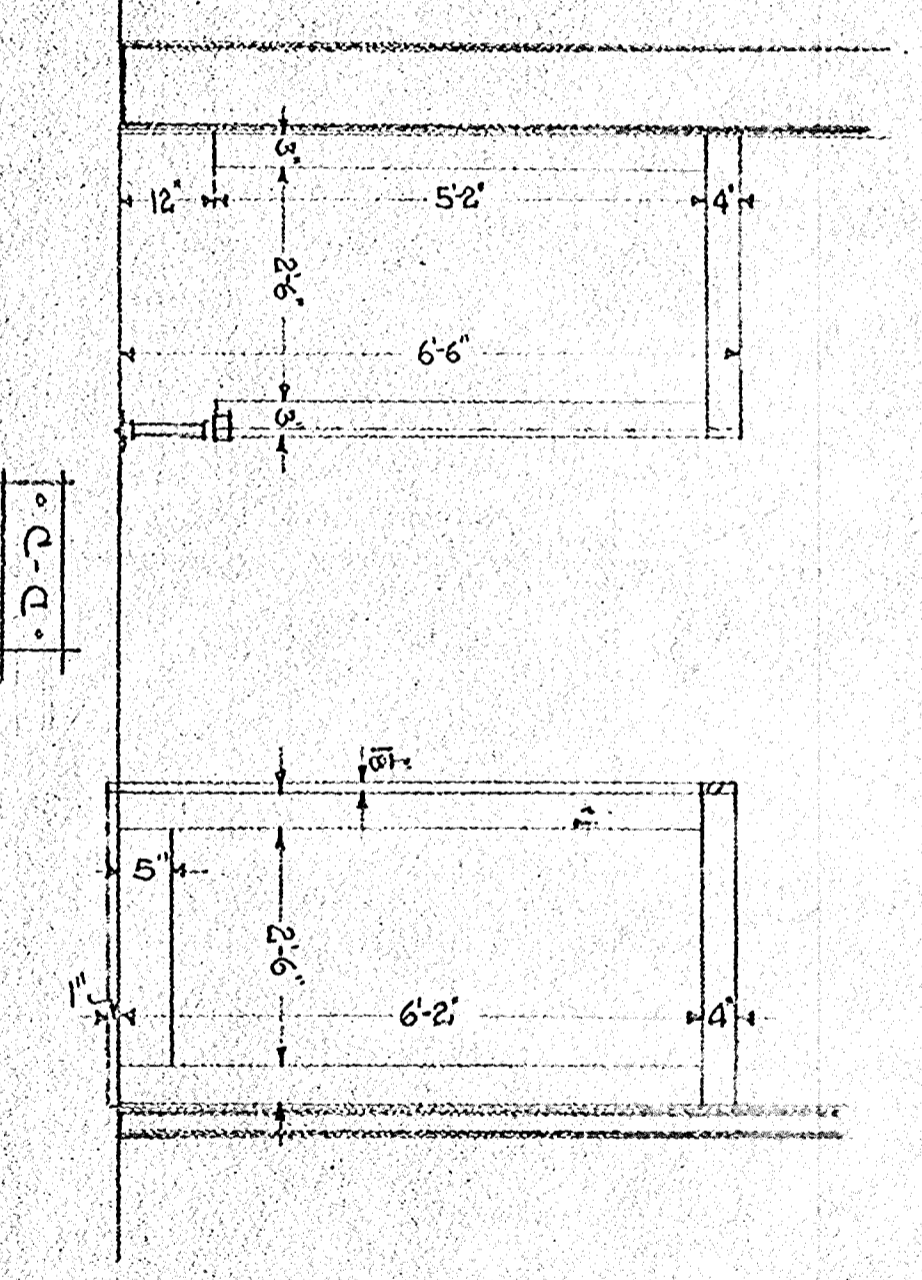

C-C

NOTE: ALL MARBLE SHOWN TO BE PINK TENA. POL.
 BACKS & ENDS OF TOILET & SHOWER WALLS & WAINSCOT BY OTHERS.
 FRONTS & PARTITIONS OF SHOWERS TO EXTEND INTO FLOOR APPX 1 INCH.
 FLOOR SLABS & FLOOR BY OTHERS.
 ALL MEASUREMENTS TAKEN FROM FIN. WALLS.

marked for approval

ALBERT WEIBLEN MARBLE & GRANITE CO.
 NEW ORLEANS, LA.
 STRENGER-CANAL ST. THEATER.
 3RD FL. UPPER ARCADE TOILET & SHOWER FRONTS.
 GEO. J. GLOYER, CO.
 ARCHT. E. WEIL, INC.
 ORDER 492 DRAWING 1 SCALE 1/2"=1'-0"
 DEVELOPED BY Ottolini CHECKED DATE Dec. 31, 1926.