

Fin. Fl. - 2


Door

BLACK & GOLD
ROMAN TRAVERTINE
B. & G.

Fe of EXISTING BASE
B. & G.

TERRAZZO FIELD & BORDER
BY OTHERS
SIDEWALK

TERRAZZO FIELD & BORDER
BY OTHERS
LOBBY

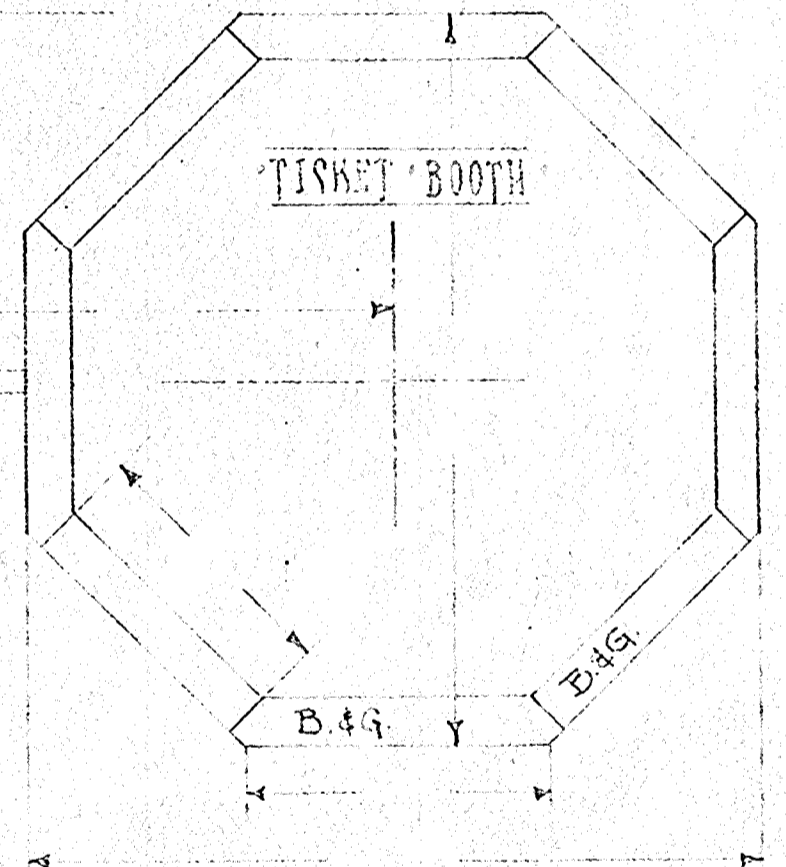

CONTINUED DRAWING # 4

FULL FINISH SLOPE

POSITION
BOILER ROOM WALL

For Amplified
July 30/26

BORDER FOR CANAL ST. SIDEWALK & LOBBY

NOTE
ALL BORDER TO BE BLACK & GOLD & ROMAN TRAVERTINE AS SHOWN S. R. FINISH
BORDER TO BE SET AGAINST EXISTING BASE ALL FIELDS BY OTHERS
DETAILS FOR TICKET BOOTH TO FOLLOW

APPROVED
BY ARCHITECT
DATE 7-21-26 PPC

330-5

3

ALL MARBLE SHOWN MARKED B

ERT WILSON ARCHITECTS
SAENGER CANAL ST. THEATER
CANAL ST. ENTRANCE
GEO. J. GLOVER CO.
EMILIA WEIL, INC.
225
OHIO
6-24-26