


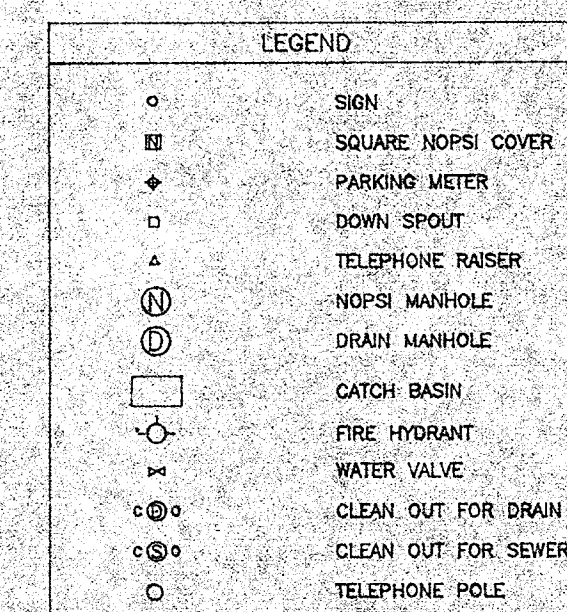

1 OF 1