




1/2  
 1/4" = 1'-0"

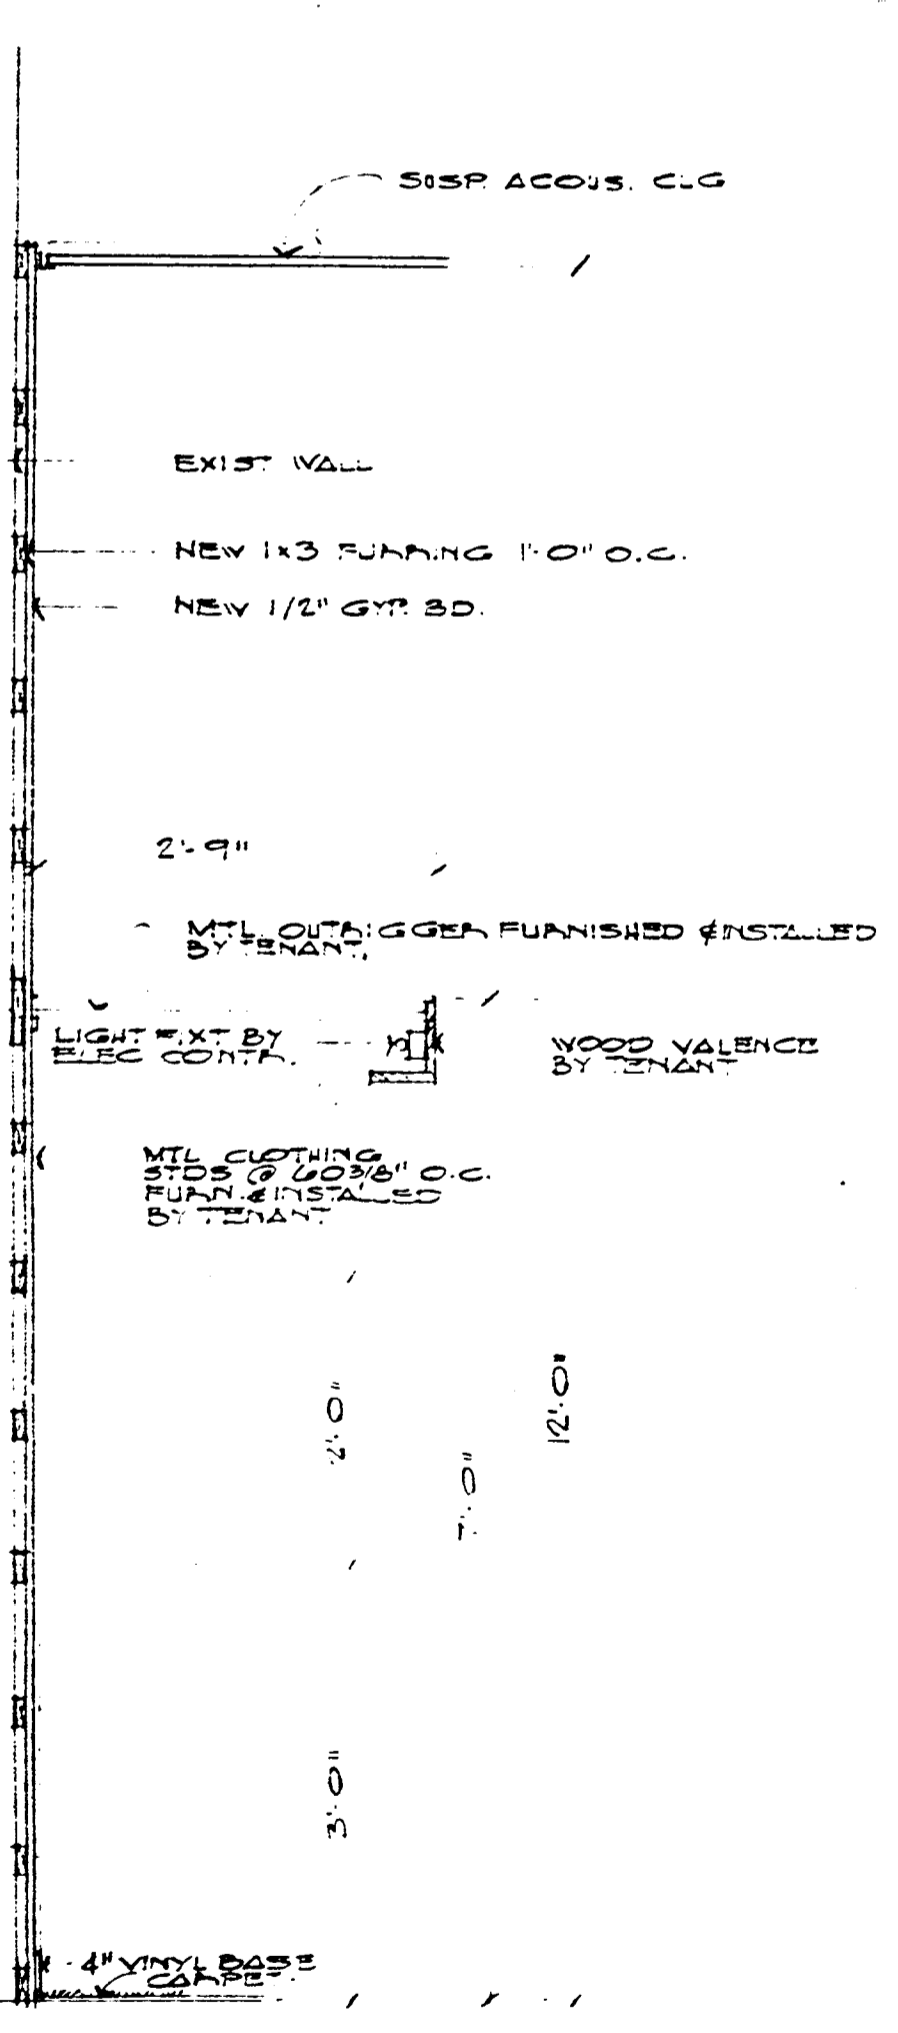


3/2  
 3/4" = 1'-0"

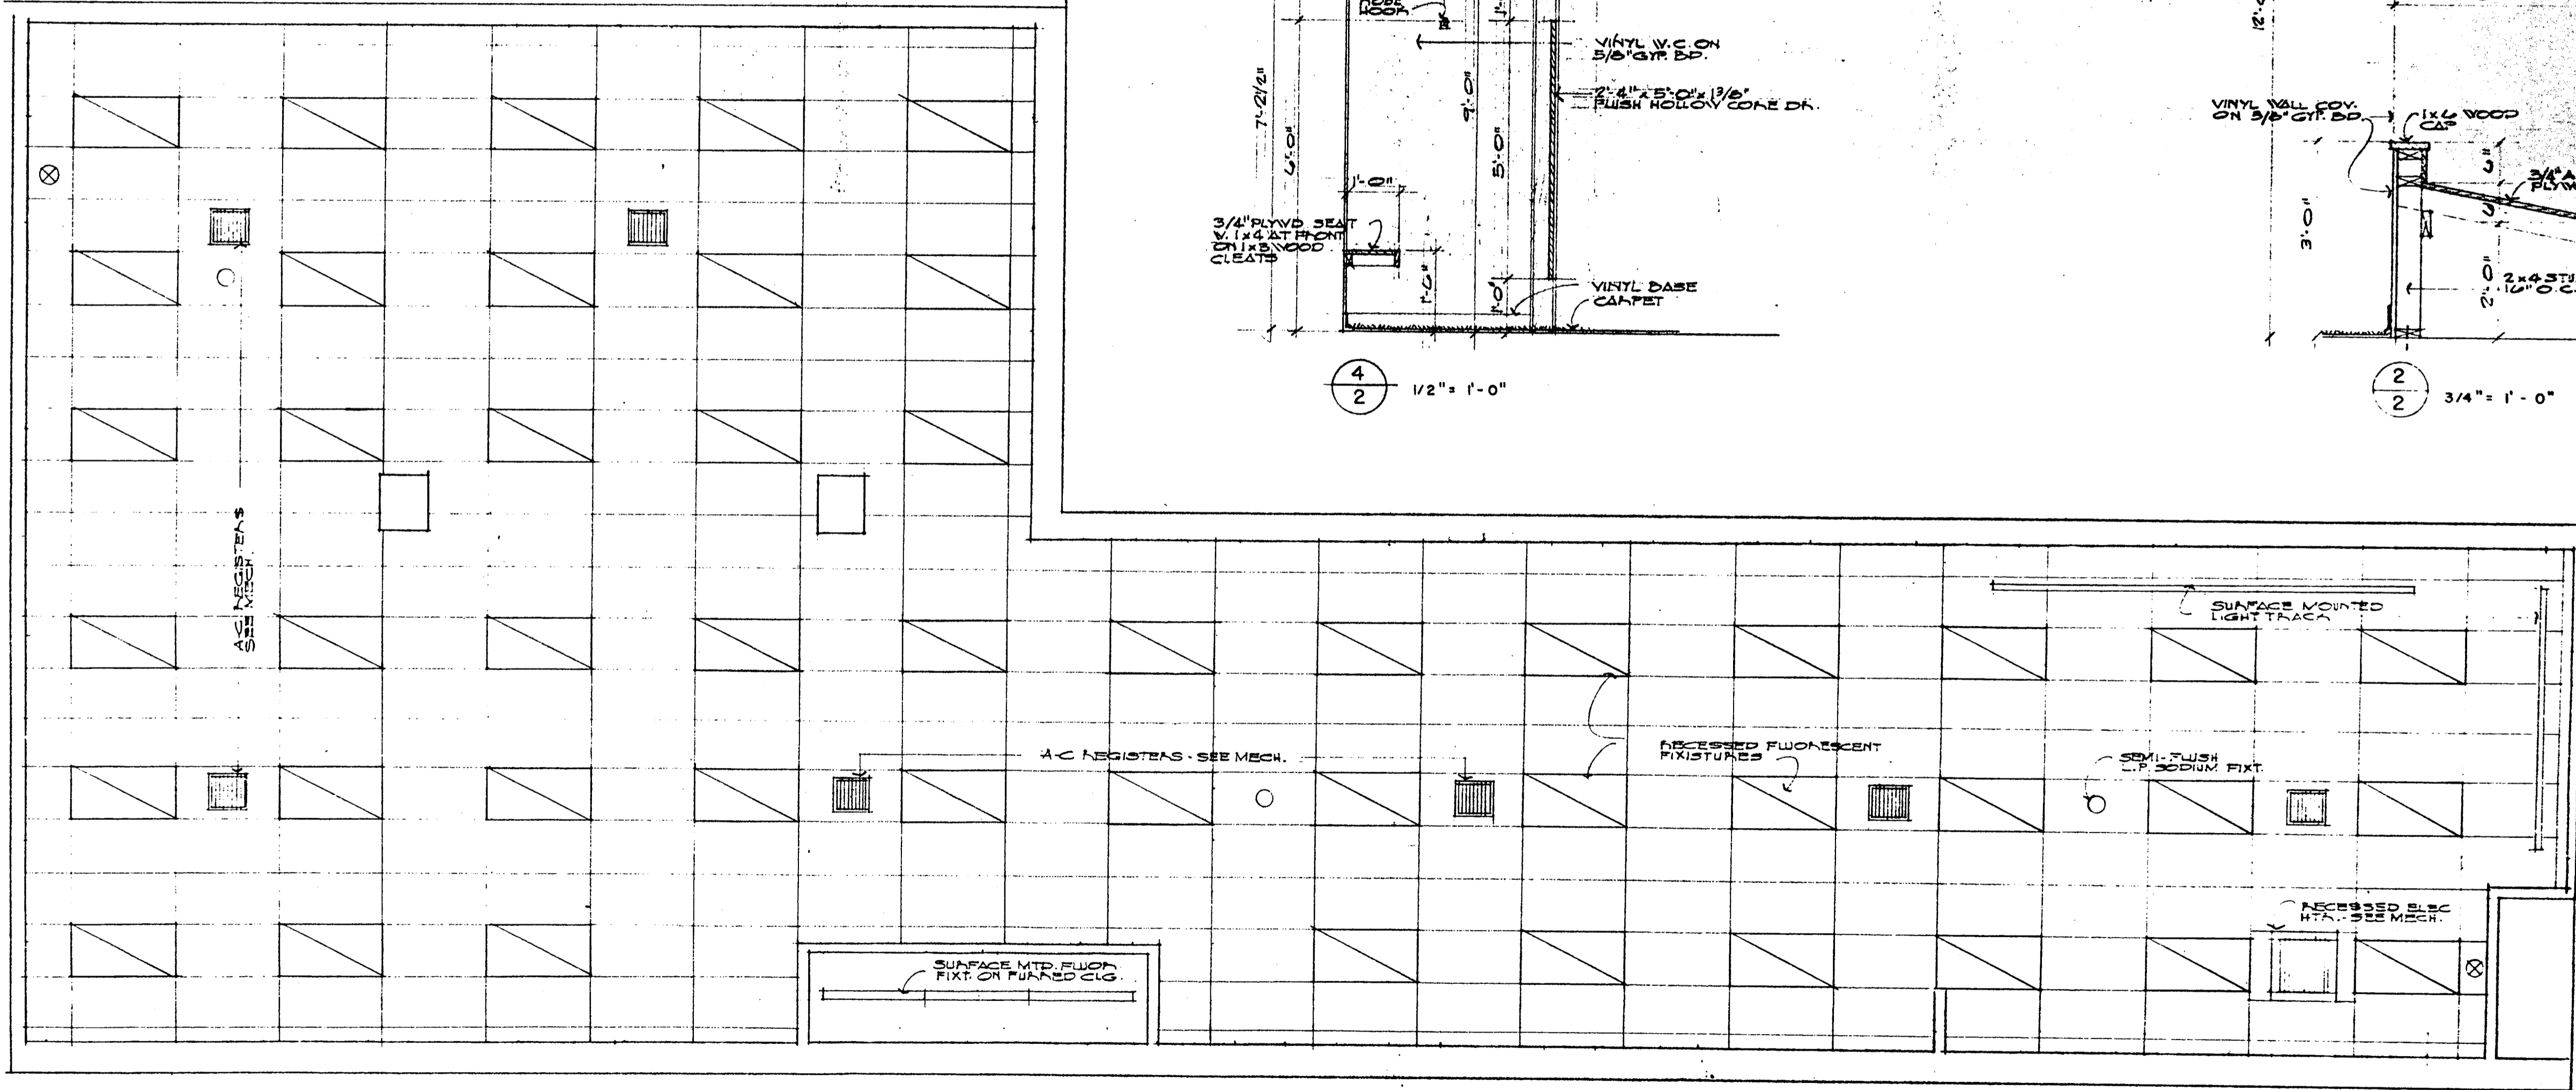

REFLECTED CEILING PLAN 1/4" = 1'-2"

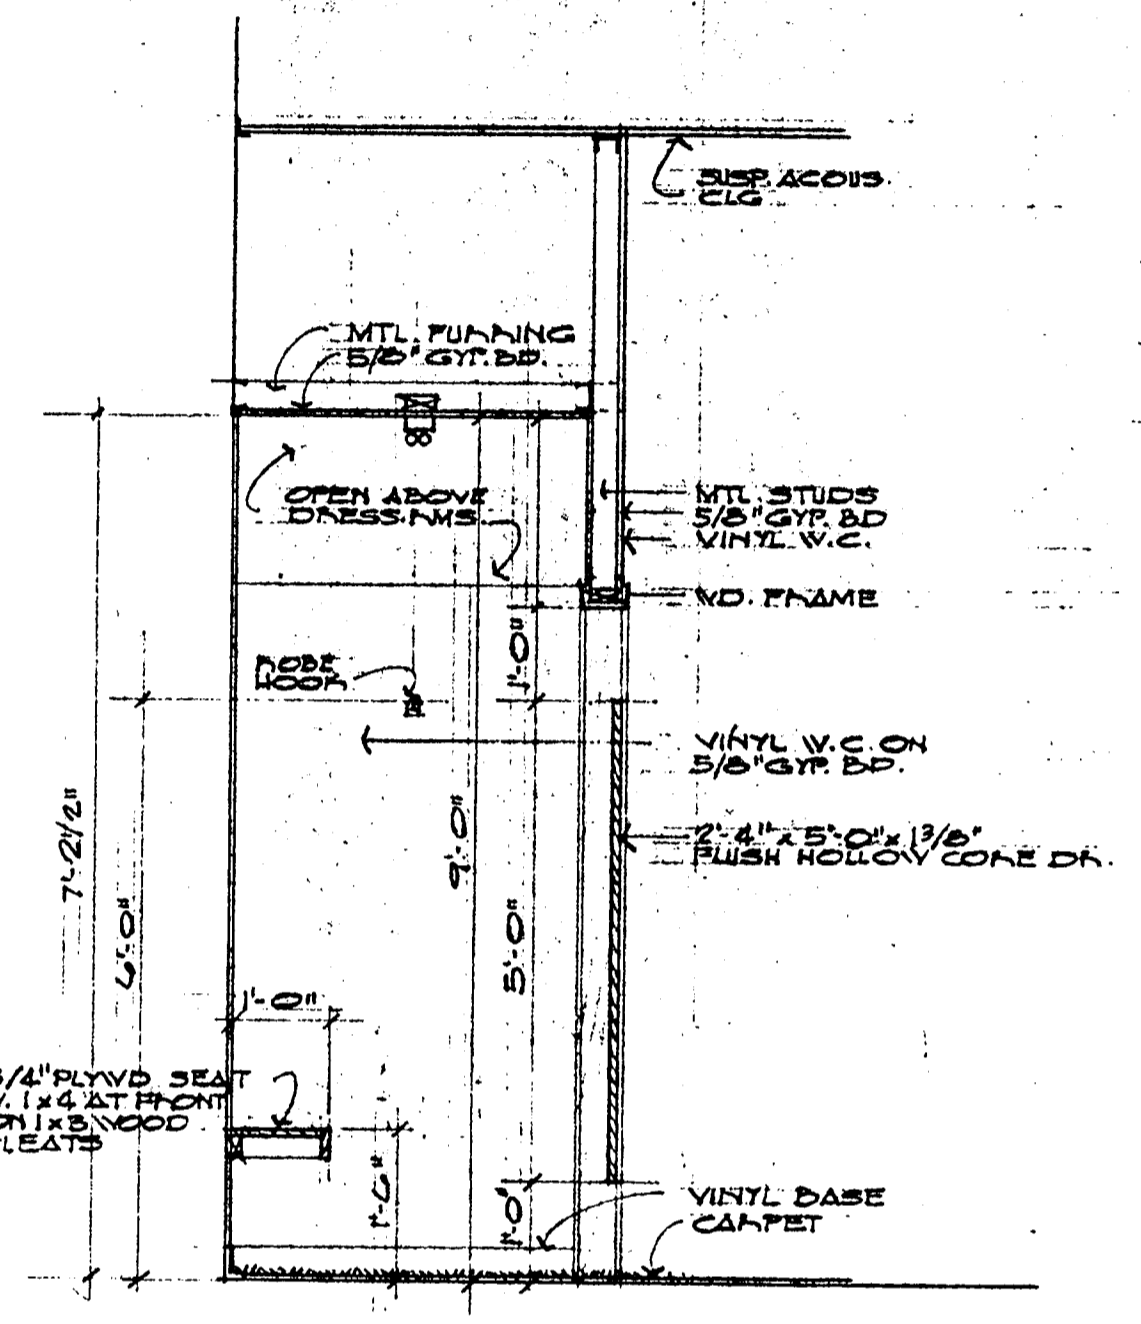

4/2  
 1/2" = 1'-0"

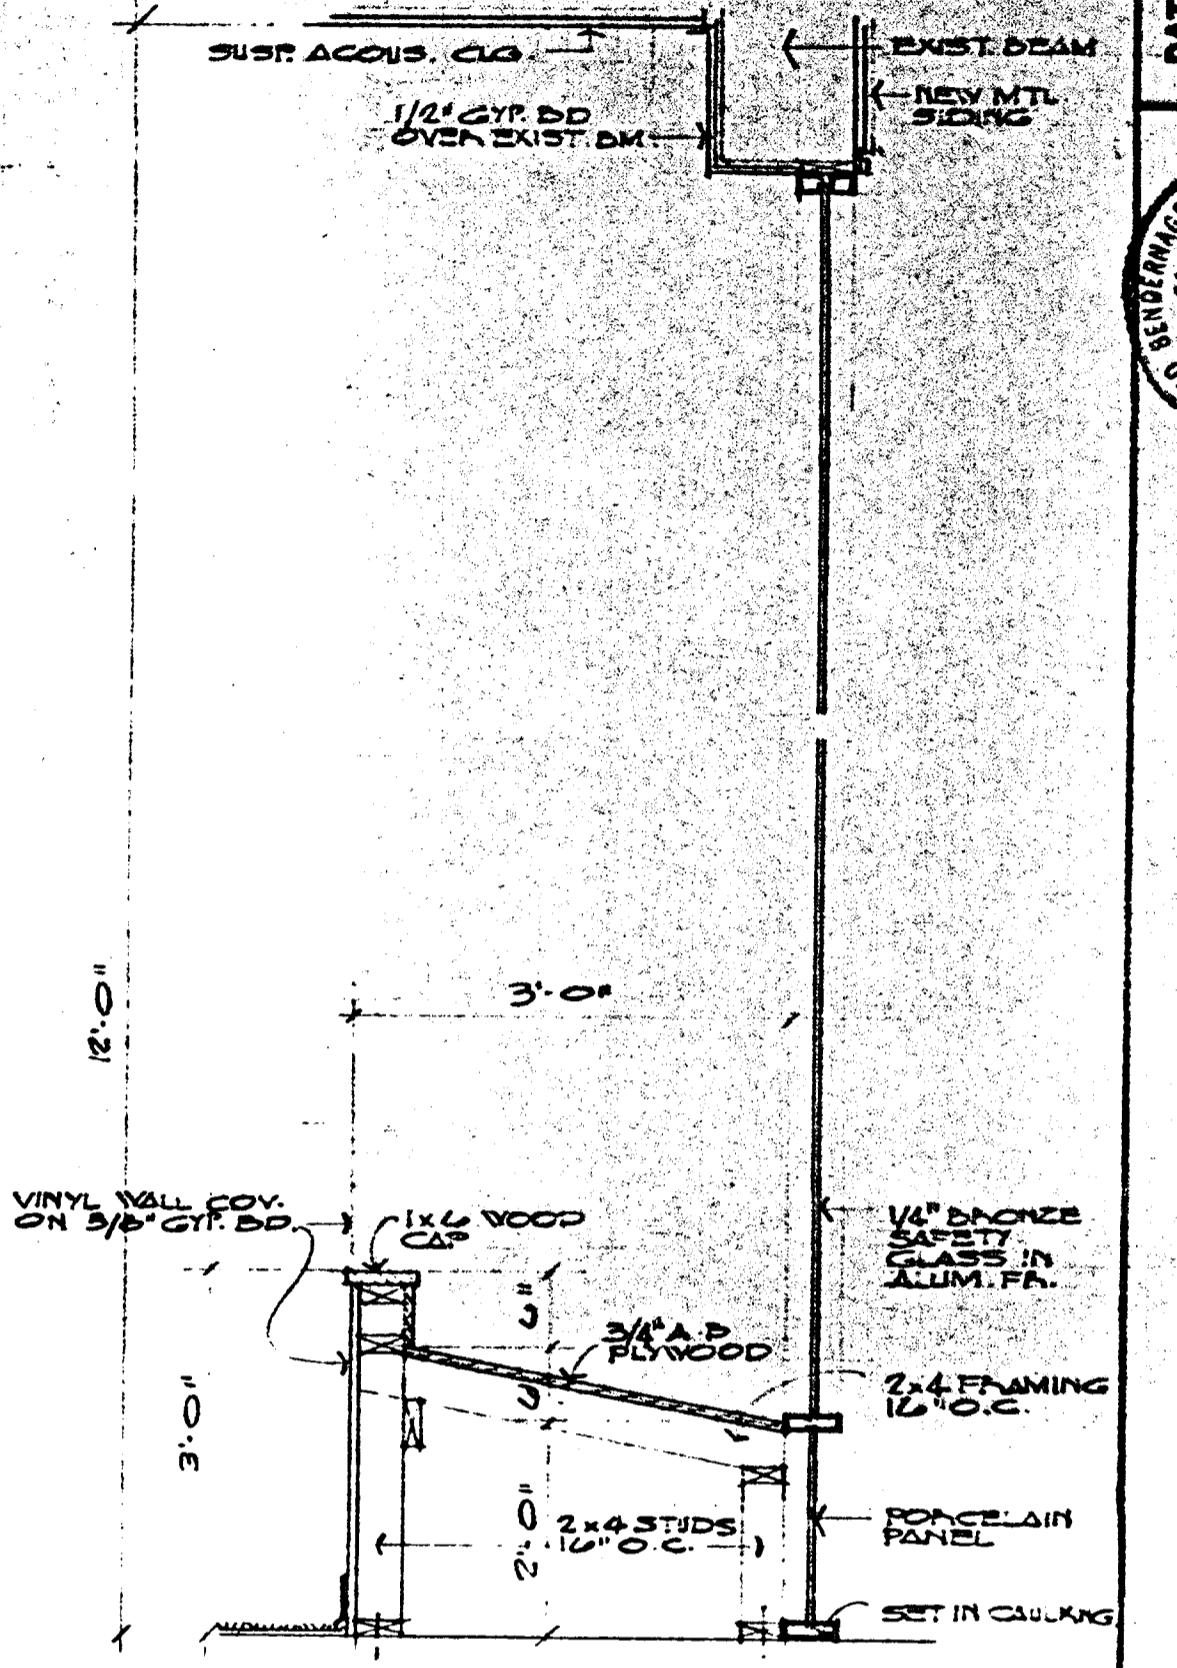

2/2  
 3/4" = 1'-0"