

LIGHTING FIXTURE SCHEDULE (1)

NO.	LAMPS		MTG.	MFR. CAT. NO. (3)	DESCRIPTION & REMARKS
	No.	TYPE (2)			
F-1	4	FA0 CW	RECESSED	LITHONIA 2GP440 A12	LAY-IN 2'x4' TROFFER, ACRYLIC LENS IN HINGED METAL FRAME.
F-1A	2	FA0 CW	RECESSED	LITHONIA GP 240 A12	SAME AS F-1, EXCEPT 1'x4'.
F-2	2	FA0 CW	SURFACE	GARCY RN9942 40W	2-LAMP STRIP. USE 8' LENGTH WHERE APPLICABLE.
F-3	1	150PAR/SP OR 150PAR/FL OR Q250PAR/38 FL AS NOTED	LIGHTING TRACK	LIGHTOLIER 7631 OR EQUAL COMPATIBLE WITH TRACK USED.	TRACK CYLINDER, LARGE ENOUGH TO ACCOMMODATE LAMPS LISTED. WHITE FINISH. AIM AS DIRECTED. FURNISH 18 FIXTURES & 6 LAMP OF EA. KIND. OTHERS BY TENANT.
F-4	3	FBT5/CV	SURFACE	SILTRON MINI 308-120 1 FACE	SELF CONTAINED EXIT LIGHT W/ BATTERY, CHARGER, AUTO. TRANSFER SW. ETC. 2 LAMPS ON SWITCHED NORMAL CKT., 1 ON EM. BATTERY CKT.
F-5	1	50W L.P. SODIUM	SEMI-FL.	VOIGHT LTG. (201)461-2495 STC-42-120	SHIELDED FIXTURE WITH WHITE DIFFUSER. SELF CONTAINED BALLAST.
F-6	2	12-VOLT TUNGSTEN HALOGEN. EXIDE MODEL H 1212	SURFACE	EXIDE QG2-V	BATTERY OPERATED EM. LIGHT W/ BATTERY, CHARGER, AUTO TRANSFER SWITCH, CHARGE INDICATOR ETC. MOUNT ON WALL NEAR CLG. CONNECT PERMANENTLY. AIM AS DIRECTED.

NOTES


- (1) FOR GENERAL FIXTURE REQUIREMENTS SEE SHEET E-2.
- (2) G.E. ORDERING ABBREVIATION GIVEN. ALSO APPROVED I.T.T., PENNSYLVANIA & VESTINGHOUSE.
- (3) OR APPROVED EQUAL, UNLESS NOTED OTHERWISE.

LEGEND

SYMBOL	DESCRIPTION	NOTES
---	WIRING CONCEALED OVERHEAD OR IN WALLS.	(1)
---	WIRING CONCEALED UNDER FLOOR	(1)
---	WIRING EXPOSED	(1)
~	WIRING IN FLEX. CONDUIT	(1)
---	LIGHTING TRACK - 2 CIRCUIT	(2)
□	FLUORESCENT FIXTURE, LAY-IN TYPE	(3)
▬	FLUORESCENT FIXTURE, 2-LAMP STRIP	(3)
⊙	NIGHT LIGHT	(3)
⊗	SELF CONTAINED EXIT LIGHT	(3/4)
⊕	BATTERY OPERATED EMERGENCY LIGHTS	
⊙	JUNCTION BOX, CLG. MTD.	(5)
⊙	JUNCTION BOX, WALL MTD.	(5)
⊕	FLUSH WALL RECEPTACLE, 2-POLE, 3-WIRE, GROUNDING	(5)
⊙	WALL SWITCH, 20A. 277V. A.C.	(5)
⊙	THERMAL TRIP SW. (MANUAL MOTOR STARTER)	(3/5)
⊙	TEL. OUTLET	(5)
⊙	PAY TEL. OUTLET	(5)
⊙	MOTOR, 2 H.P.	(6)
⊕	MOTOR CONTROLLER	(7)
⊕	SAFETY SWITCH	

NOTES

- (1) CROSS MARKS INDICATE NO. OF CONDUCTOR OTHER THAN 2. → INDICATES CIRCUIT RUN TO PANEL.
- (2) FURNISH AND INSTALL TRACK FIXTURES AS INDICATED. AIM AS DIRECTED.
- (3) SUBSCRIPT IDENTIFIES LIGHT WITH CONTROLLING SWITCH.
- (4) SWITCH ONLY NON-EMERGENCY LIGHTS.
- (5) WALL MTD. OUTLETS ARE FINISH WHEN SMALL CIRCLE IS WITHIN WALL LINES.
- (6) FURNISHED & INSTALLED UNDER MECH. ROOM. WIPED UNDER THIS DIV.
- (7) FURNISHED UNDER MECH. DIV. INSTALLED & WIRED UNDER THIS DIV.

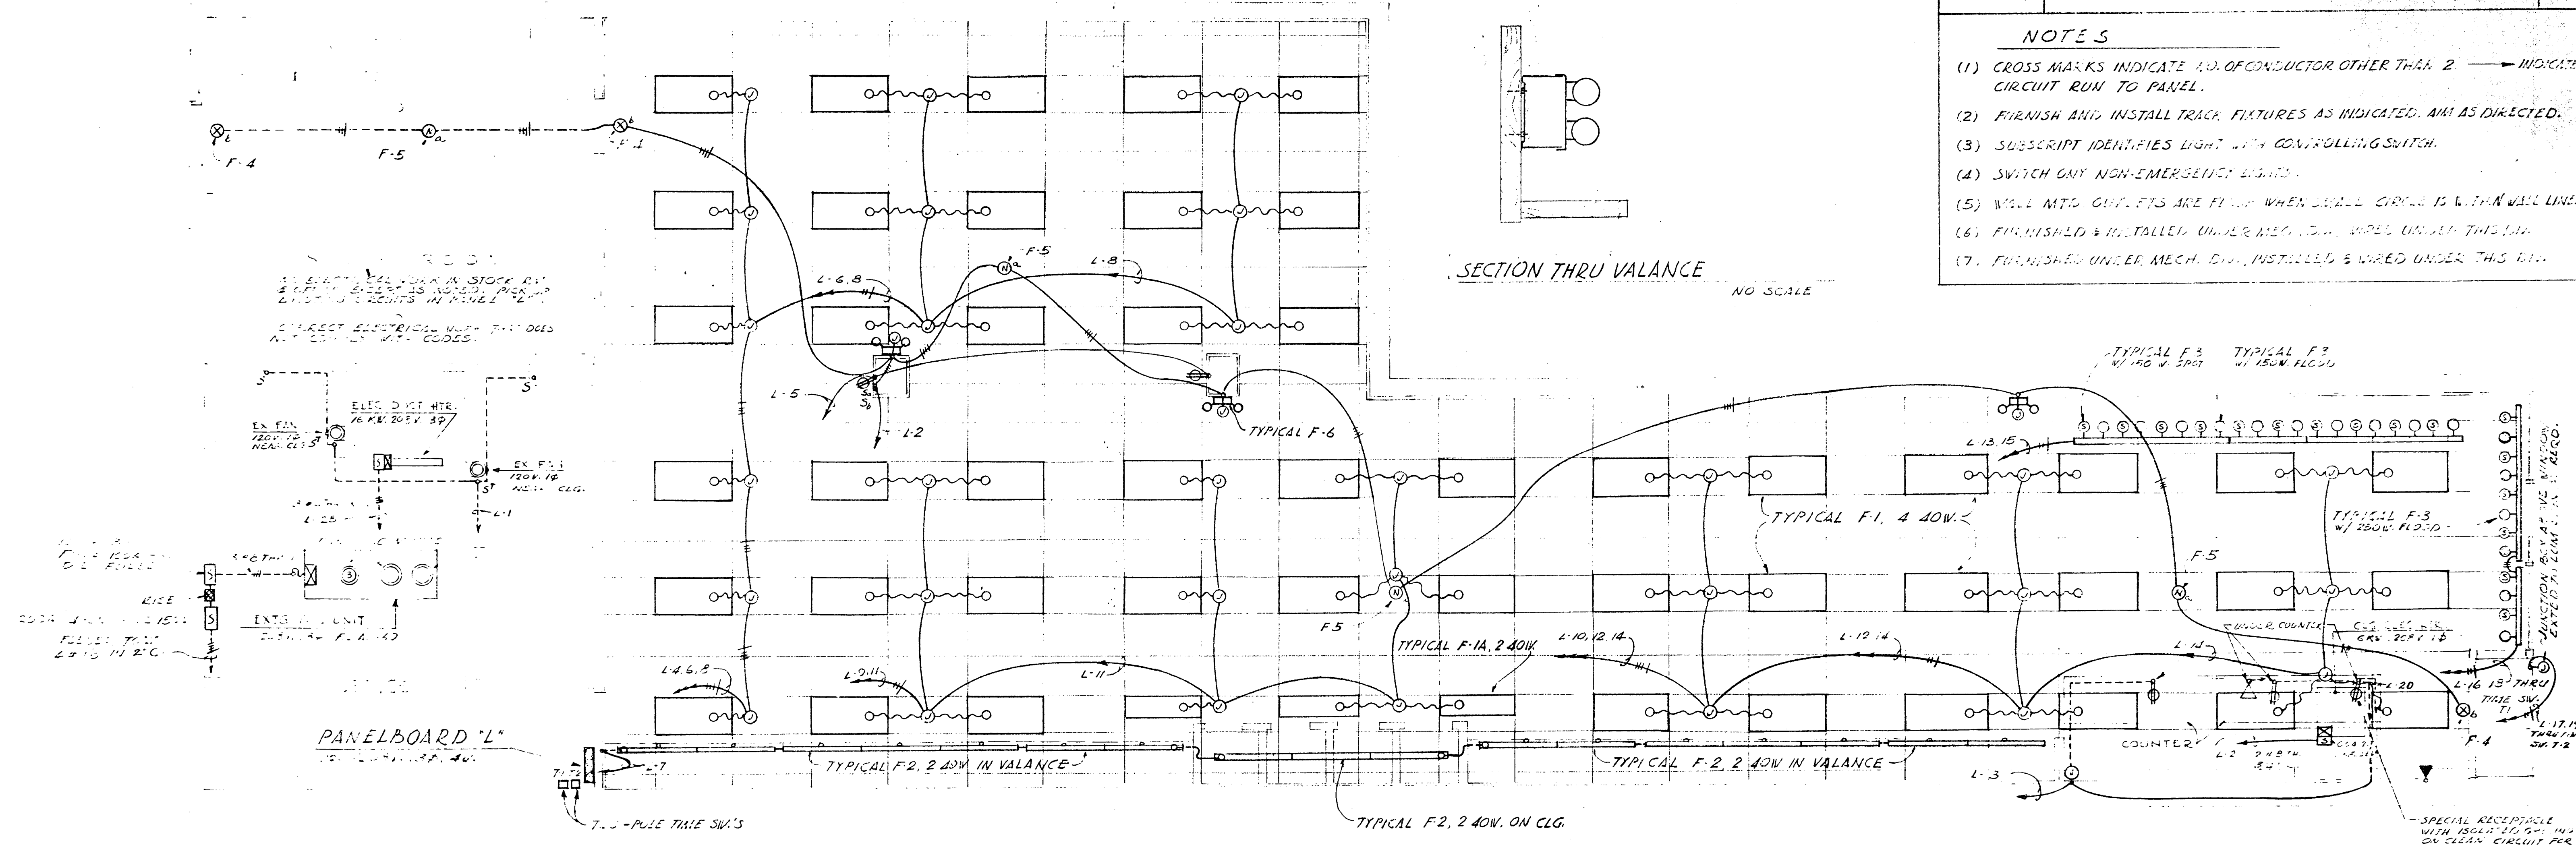

FLOOR PLAN - ELECTRICAL

1/4" = 1'-0"