


LEGAL DESCRIPTION :

LOTS 2B and 3B, LAZY RIVER ESTATES, SECTION "B",
St. Tammany Parish, Louisiana.

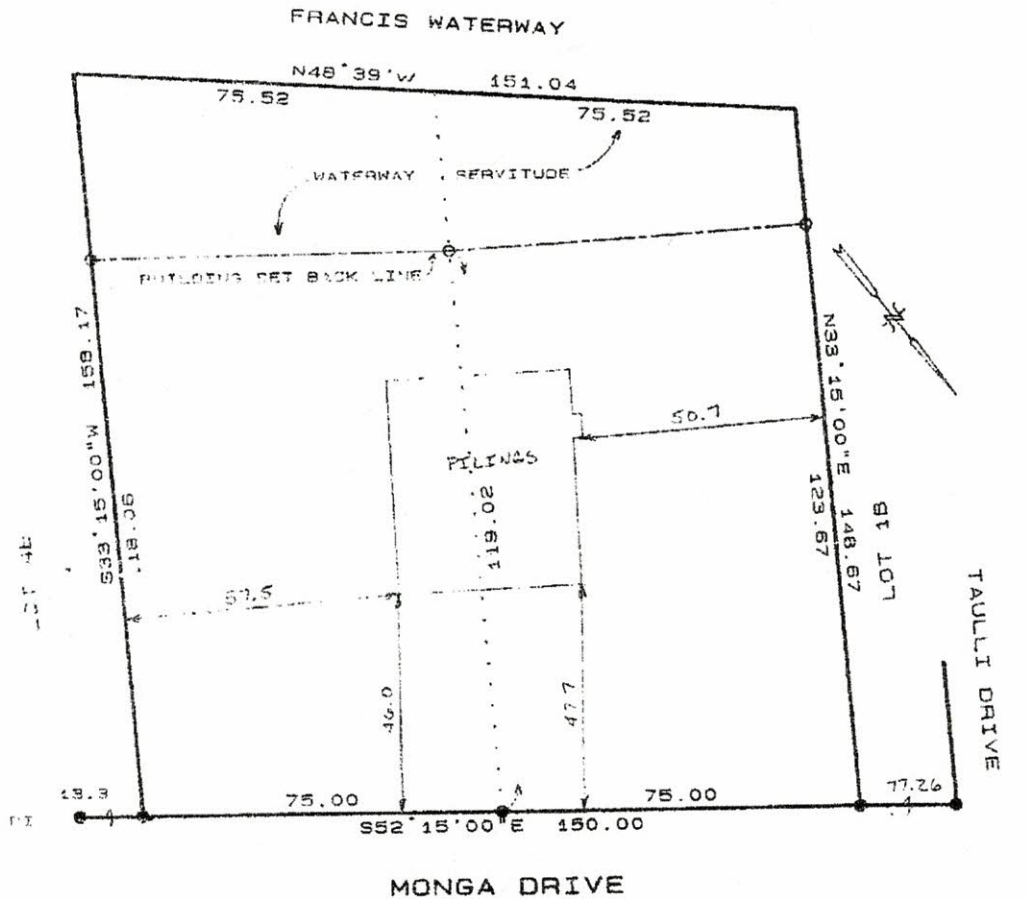

CERTIFIED TO :

Michale Dunn wife/and Aristide Lignieres
First National Bank of St. Bernard
PROPERTY TITLE, INC.

LEGEND :

- BUILDING SETBACKS
- FRONT 25 SIDES 5
- REAR 25 STREET
- FOUND 1/2" IRON ROD
- SET 1/2" IRON ROD
- FENCE ---- X ----
- RECORD BEARINGS

This is to certify that the plat is based on a physical survey made on the ground in accordance with Minimum Standard Estimating Accuracy / AASB Land Title Ordinance, Pursuant to the Standards of a SUBURBAN survey and the Professional Standards of Practice cited in LAO 46:1X1. The signature must be in ink and sealed for this plat to be certified. *Ned R. Wilson*

THIS SURVEY IS IN ACCORDANCE WITH THE DESCRIPTION FURNISHED BY THE CLIENT. THERE MAY BE ADDITIONAL RESTRICTIONS NOT SHOWN ON THIS PLAT THAT MAY EXIST IN THE PUBLIC RECORDS. THERE ARE NO VISIBLE ENCROACHMENTS EXISTING OTHER THAN THOSE SHOWN HEREON. ELEVATIONS SHOWN REFER TO NGVD (29). IF NOT OTHERWISE NOTED.

NED R. WILSON, PLS

LOUISIANA REGISTERED LAND SURVEYOR NO. 4336
1990 SUNST DRIVE
MANDRVILLE, LOUISIANA 70448
TEL: (504) 835-5491 FAX: (504) 826-5526

SURVEY:	DATE:	CPN :	225205 0240 D
BOUNDARY	26 DEC 94	FIRM DATE :	2 APR 91
FORM BOARDS	3 FEB 95	FIRM ZONE :	"A"
SLAB TIE-IN		BASE FLOOD :	10.0
AS-BUILT		LOWEST FLOOR :	13.9
REVISED		NATURAL GROUND :	7.0
SCALE :	1 inch = 30 feet	JOB NO.	3583