



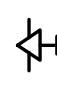








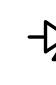
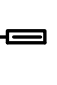
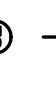
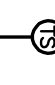
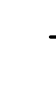
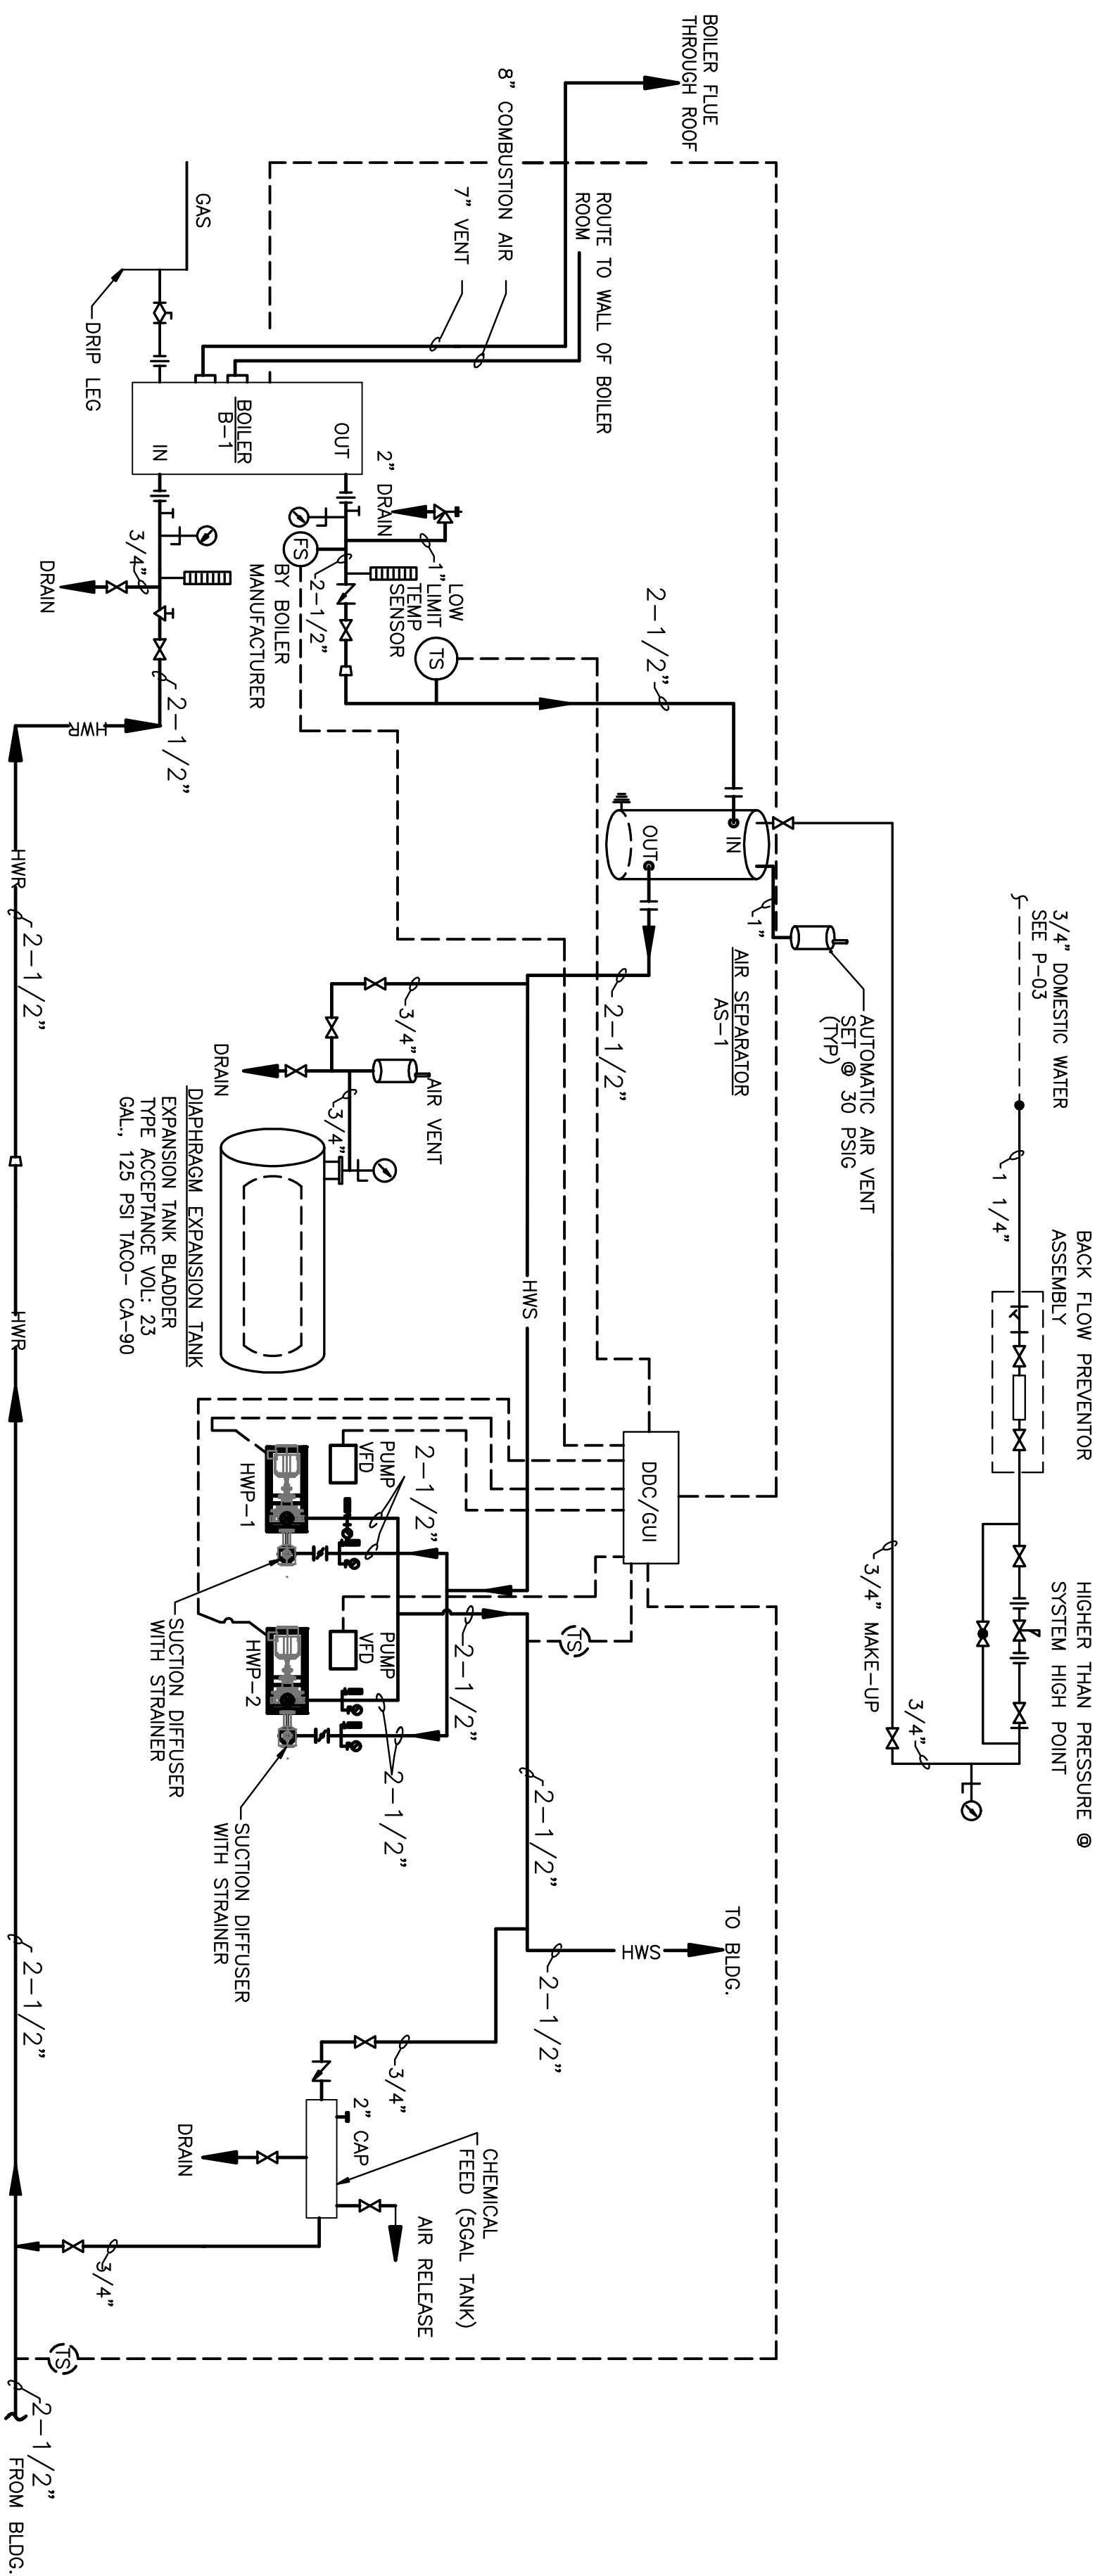


# HEATING HOT WATER SYMBOL LEGEND:

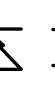-  BALL VALVE
-  BUTTERFLY VALVE
-  CHECK VALVE
-  CIRCUIT SETTER
-  GAS COCK
-  GATE VALVE
-  AUTOMATIC AIR VENT
-  OUTSIDE AIR TEMPERATURE RESET 3 WAY CONTROL VALVE
-  PIPING TEE-IN NUMBER
-  PRESSURE GAUGE W/ COOK
-  PRESSURE REDUCING VALVE WITH CHECK
-  RELIEF VALVE
-  TEMPERATURE INDICATOR
-  TEMPERATURE SENSOR
-  TRIPLE DUTY VALVE
-  "Y" STRAINER
-  Y-STRAINER WITH VALVED CLEANOUT
-  FLOW SWITCH UNLESS INTERNAL TO BOILER

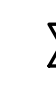


**HEATING HOT WATER SYSTEM SCHEMATIC**  
SCALE: N.T.S.

**HUSEMAN & Associates**  
 ARCHITECTURAL & MECHANICAL ENGINEERING  
 3927 N. HO SERVICE RD. (504) 456-3119  
 SUITE 2019 METairie, LA 70002 FAX (504) 456-3122  
 Drawn By: RP  
 Designed By: JL  
 Checked By: GB

**WALDEMAR S. NELSON AND COMPANY**  
 ENGINEERS AND ARCHITECTS  
 1200 ST. CHARLES AVE. NEW ORLEANS, LA.

RECORD DRAWING DATE	10/29/09
CODE ID NO.	2
DRAWING SIZE	D
SPEC. NO./OR.	
CONSTRN. CONTR. NO.	
NAVFAC DRAWING NO.	12030940
SHEET	11 OF 15
M-06	

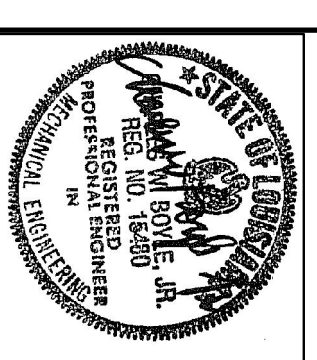

**NAVFAC**  
 Naval Facilities Engineering Command  
 Southeast Division, Jacksonville, FL

NAS JRB New Orleans	Belle Chasse, Louisiana
<b>NAVAIRSEFAC CALIBRATION BLDG.</b>	
HVAC HEATING HOT WATER PIPING SCHEMATIC	
APPROVED	DATE: AUGUST 22, 2008
	EFD FOR COMMANDER, NAVFAC

DRAWING REVISIONS				
REV.	DESCRIPTION	PREP BY	DATE	APPRD.
0	FINAL DESIGN	RP	10/29/09	CB

**BROADMOOR**  
 BUILDING by DESIGN  
**BROADMOOR, L.L.C.**  
 2740 North Amick Road  
 Metairie, Louisiana 70002  
 www.broadmoorllc.com