


DESIGNATOR	ITEM NAME/TYPE	SIZE	LOCATION COORDINATES MAD27	LOCATION COORDINATES MAD83
			NORTH EAST	LAT/LONG
111PW	VALVE	12"	E248,774	30.359590791, 89.629905078
112PW	VALVE	12"	E248,774	30.359579793, 89.629904989
113PW	VALVE	8"	E248,774	30.358870458, 89.629899229
114PW	VALVE	8"	E248,774	30.355290790, 89.629870164
115PW	VALVE	1.25"	E248,750	30.35261297, 89.629929775
116PW	VALVE	8"	E248,774	30.355290790, 89.629870164
117PW	VALVE	8"	E249,624	30.354667296, 89.627171904
117APW	VALVE	1.5"	E251,078	30.354667296, 89.627171904
118PW	VALVE	12"	E248,774	30.358870458, 89.629899229
118APW	VALVE	1.5"	E248,750	30.358870458, 89.629899229
119PW	VALVE	14"	E248,732	30.359584480, 89.630038189
339PW	VALVE	6"	E248,755	30.354671783, 89.629926536
340PW	VALVE	6"	E247,120	30.353257178, 89.630097372
341PW	VALVE	6"	E247,020	30.353049030, 89.635412702
118APW	VALVE	1.5"	E246,950	30.354202398, 89.635644056
118APW	VALVE	1.5"	E248,900	30.358762919, 89.629498872
116APW	VALVE	1.5"	E248,125	30.355311221, 89.631927914
341APW	VALVE	6"		
110CPW	VALVE	1.5"		
110DPW	VALVE	1.5"		
111BWP	VALVE	6"		
110FPW	VALVE	6"		
110FPW	VALVE	6"		
118BPW	VALVE	6"		
118CPW	VALVE	6"		
113BPW	VALVE	6"		
341BPW	VALVE	6"		

SYM	ZONE	DESCRIPTION	DATE	APPROVED
14	E-13	INC E.O. 18 PER SWR-8044M100 TO ADD POST INDICATOR VALVE AND 4 INCH LINE TO BUILDING 2436.	11/10/04	ISSUED/CEF
13	H-1	REVISED TO ADD GPS COORDINATES TO VALVE CHART PER 9008ZKAO1	11/10/04	ALL CHANGE
12	A2	K.L.H. 08/09/05 I.D.S. 08/09/05 ADMIN CHANGE TO MAKE FORMAT COMPATIBLE WITH WINDCHILL. T.L.M. 11/30/04 C. ADCOX 11/30/04	11/10/04	ISSUED/CEF
11	G-10	INC SWR-WS000URC000 M1, CLOSED POTABLE WATER VALVE T.D.S. 09/30/03 T.L.M. 09/30/03	11/10/04	ISSUED/CEF
10	F-9	UPDATED TO INC SHOP REDLINES, ALSO UPDATED SITE MAP OF THIS AREA. T.D.S. 5/19/03 H. LEE 5/19/03	11/10/04	ISSUED/CEF
9	G9	INC E.O. 16 PER SWR-8044M100, INC E.O. 17 PER SWR-8044M100	11/10/04	ISSUED/CEF
8	F-10	INC E.O. 15 PER SWR-WS000UC800	11/10/04	ISSUED/CEF
7	G-5	INC SWR-88009C0100, CHANGED SHUTTLE PARKWAY TO TRENT LOIT PARKWAY. I.D.S. 4/28/99 D.L.L. 4/28/99	11/10/04	ISSUED/CEF
6	H,10 C,2	INC. E.O. NO. 10 PER CP-93NVAE, E.O. NO. 11 PER FSR-85F4H480, E.O. NO. 12 PER FSR-WS004UC000, E.O. 13 PER FSR-CC00950007, E.O. NO. 5 & 6 WERE NOT USED. INC. E.O. NO. 7 PER FSR WSG8W00, E.O. NO. 8 PER FSR 900A801 & E.O. NO. 9 PER CP-91M00Z.	11/10/04	ISSUED/CEF
5		ADDED BLDG 12109 & VALVE 118APW WITH VALVE BOX PER FSR-704E3927, ADDED BLDGS. 2410 & 2411 WITH VALVE 118APW WITH VALVE BOX PER FSR-704E3927. BUILT REDLINES TO BLDGS PER AS V.H. 10-14-87 INC. E.O. 2 PER FSR-704E3927	11/10/04	ISSUED/CEF
4		ADDED BUILDING 2406 PER FSR-WNSG4H	11/10/04	ISSUED/CEF
3		ADDED SITEWIDE WATER PER EMI.640333 TO BUTLER COMPLEX.	11/10/04	ISSUED/CEF
2		ADD POTABLE WATER LINE TO BUTLER COMPLEX.	11/10/04	ISSUED/CEF
1		ADD POTABLE WATER LINE TO BUTLER COMPLEX.	11/10/04	ISSUED/CEF

- LEGEND**
- DRAWING INTERFACE
  - DRAWING NUMBER
  - PI CHANGE IN DIRECTION
  - ♦ FIRE HYDRANT
  - ⊗ VALVE
  - DISCHARGE BASIN

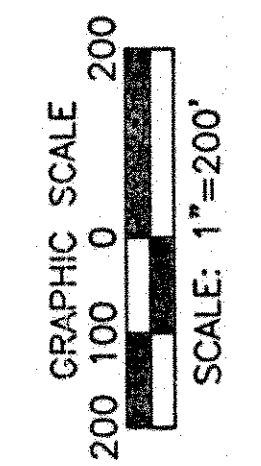

SYM	ZONE	DESCRIPTION	DATE	APPROVED	
31	32	33	34	35	36
25	26	27	28	29	30
19	20	21	22	23	24
13	14	15	16	17	18
7	8	9	10	11	12
1	2	3	4	5	6

REVISIONS

DATE	SIGNATURES	DESCRIPTION
8-10-05	R.W. LOPEZ	ISSUED/CEF
12/08/03	D.E. LOUHEI	ISSUED/CEF
4-21-06	ISSUED/CEF	ISSUED/CEF
4-21-06	ISSUED/CEF	ISSUED/CEF
4-21-06	ISSUED/CEF	ISSUED/CEF

JOHN C. STEWART  
SPACE CENTER  
SEC. 145 3000-0000

**MSS** Mississippi Space Services

SITE PLAN  
POTABLE WATER  
REF. NO. 2

DATE: 8-10-06  
DRAWING NO.: 12G00-R002  
SHEET: 14

