


FLOOR PLAN
SCALE: 1/4" = 1'-0"

Must have support for door headers



FRONT ELEVATION
SCALE: 1/4" = 1'-0"

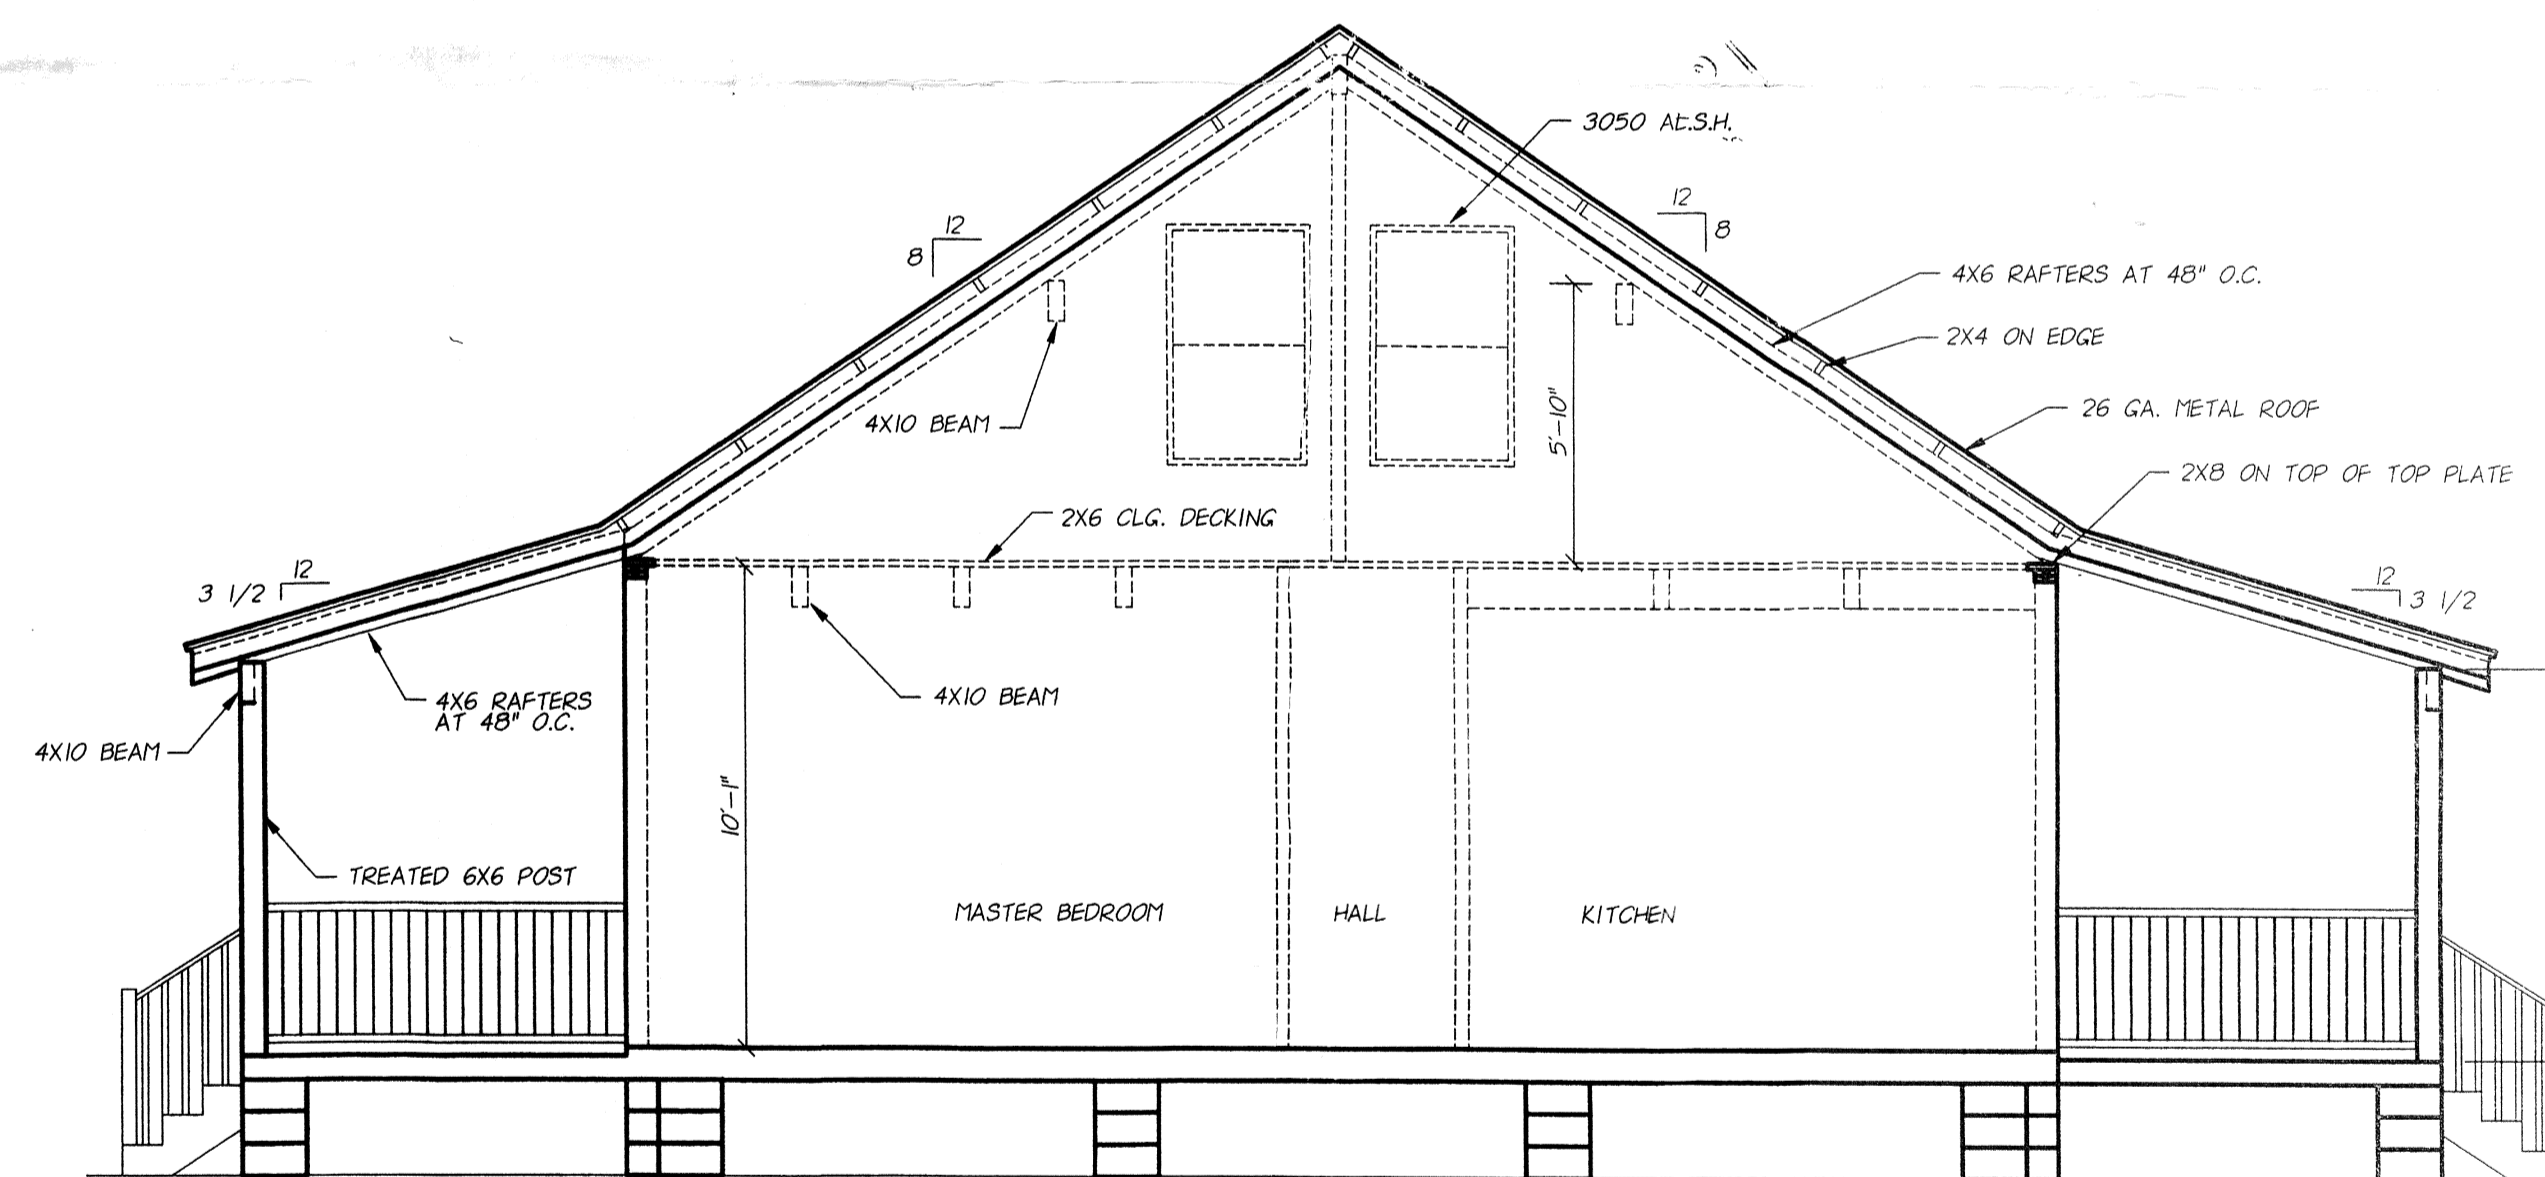

SIDE ELEVATION/SECTION
SCALE: 1/4" = 1'-0"

DOOR SCHEDULE				
MARK	WIDTH	HEIGHT	THICK	DESCRIPTION
1	3'-0"	6'-8"	1 3/4"	SEE ELEVATION
2	2'-8"		1 3/8"	2 PANEL MASONITE INTERIOR
3	2'-6"			
4	2'-4"			
5	2'-0"			
6	1'-6"			
7	2'-8"			
8	2'-8"		1 3/4"	1 LT. MTL. CLD. POCKET

THIS DRAWING CONTAINS VALUABLE, CONFIDENTIAL, PROPRIETARY TRADE SECRET INFORMATION OF SOUTHERN COUNTRY DESIGNS. NO REPRODUCTION OR OTHER USE OF THE DRAWING OR ANY OF ITS CONTENTS IS PERMITTED WITHOUT THE WRITTEN CONSENT OF SOUTHERN COUNTRY. AN UNPUBLISHED WORK BY SOUTHERN COUNTRY DESIGNS. ALL RIGHTS RESERVED.

PLANS FOR
VERNON BOND

SOUTHERN COUNTRY DESIGNS, LLC
"Where the American Dream Begins"
PHONE (985) 624-8390
email: southerncountrydesigns@gmail.com

DATE: 02/08/13
SCALE: 1/4" = 1'-0"

SHEET	LIVING AREA	AREA U.B.	INDEX	DRAWN BY	REV. BY
A1	1500	2300	5458	HVM1	HVM1

NOTE:
ALTHOUGH EVERY EFFORT HAS BEEN MADE IN PREPARING THESE PLANS, THE CONTRACTOR MUST CHECK ALL DETAILS AND DIMENSIONS AND BE RESPONSIBLE FOR SAME.