

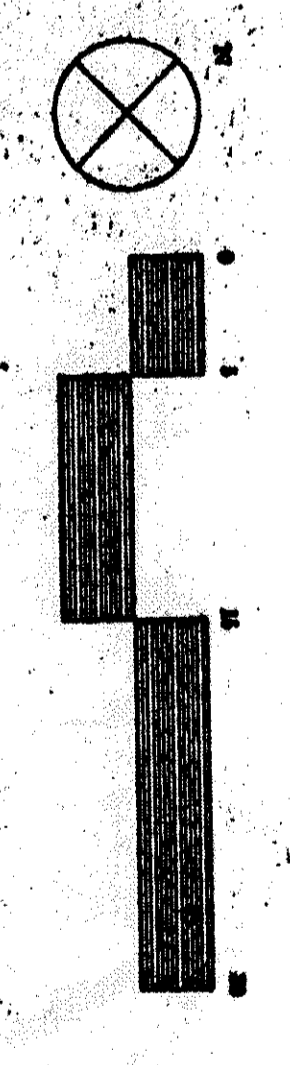


385
1973852

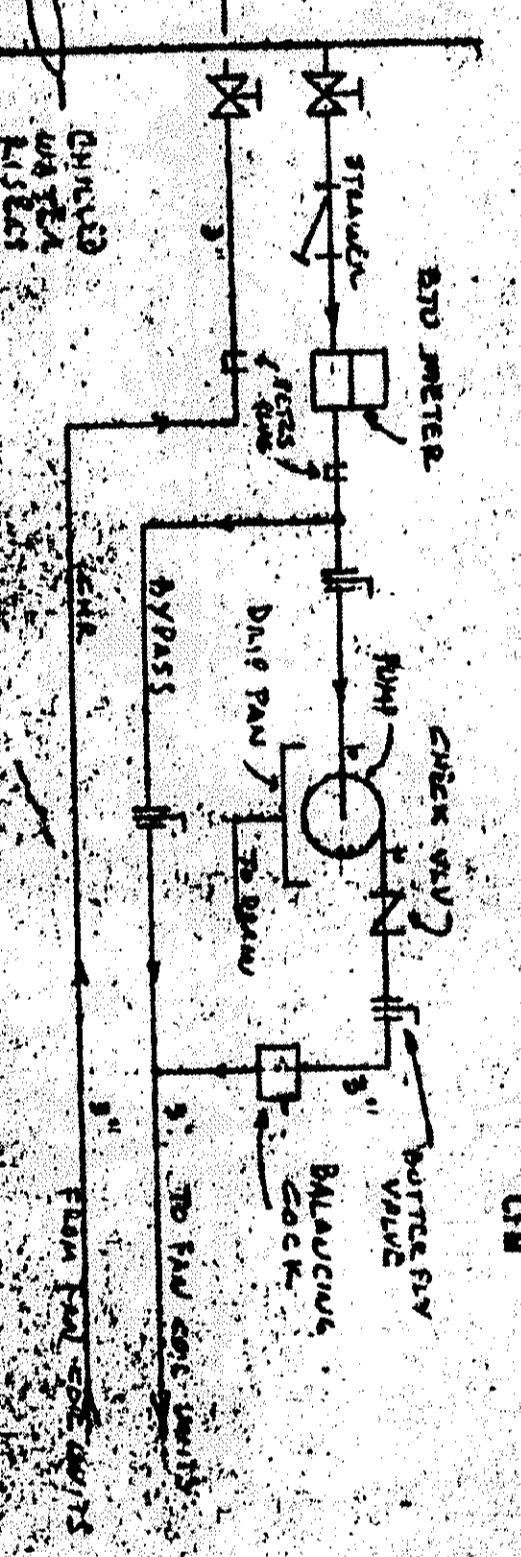

ESMOND PETSKA & ASSOCIATES
 JOHN S. ESMOND
 Principal
 501 Stewart Building
 301 State Street
 Boston, MA 02109
 Tel: 617/452-8800
 Fax: 617/452-8804

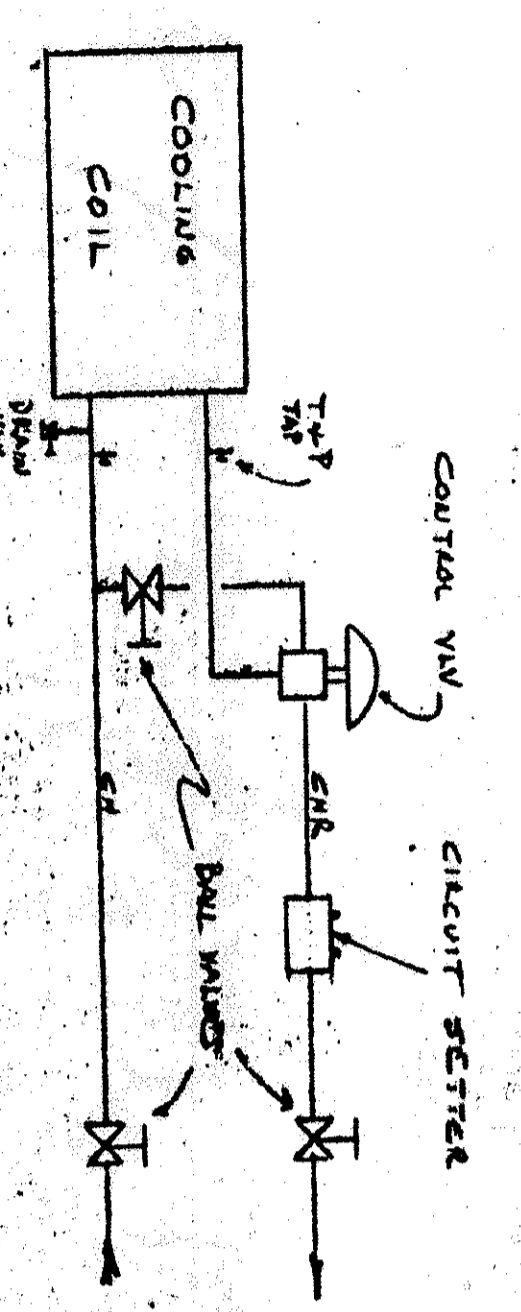

HAYES
 ARCHITECTS
 400 Federal Street
 Boston, MA 02109
 Tel: 617/552-3300
 Fax: 617/552-3300

PROGRAM / SPACE PLANNING
ENERGY CORPORATION
 GENERATION & TRANSMISSION
 THREE LAKEWAY CENTER

AS INSTALLED DRAWINGS
 1. 2nd FLOOR MECHANICAL PLAN

MIA