



**GENERAL NOTES**

THE LOCATIONS OF UNDERGROUND UTILITIES AS SHOWN HEREON ARE BASED ON ABOVEGROUND STRUCTURES AND RECORD DRAWINGS PROVIDED THE SURVEYOR. LOCATIONS OF UNDERGROUND UTILITIES OR STRUCTURES MAY VARY FROM LOCATIONS SHOWN HEREON. ADDITIONAL BURIED UTILITIES OR STRUCTURES MAY BE ENCOUNTERED. NO EXCAVATIONS WERE MADE DURING THE PROGRESS OF THIS SURVEY TO LOCATE BURIED UTILITIES OR STRUCTURES.

I HAVE CONSULTED THE FLOOD INSURANCE RATE MAPS AND FOUND THIS PROPERTY IS IN A SPECIAL FLOOD HAZARD AREA. F.I.R.M. COMMUNITY MAP NO. 225205 0535 D; DATED: 04/02/1991 FLOOD ZONE: A10; BASE FLOOD ELEVATION: 9.0'.


NOTE: BEARINGS SHOWN REFER TO THE LOUISIANA STATE PLANE COORDINATE SYSTEM (LOUISIANA SOUTH 1702 - NAD83) BASED ON GPS RTN TIES ACCESSED ON 10/27/2022.

REFERENCE: A Survey plat by this firm Dated 04/27/1999 Survey # 950859.

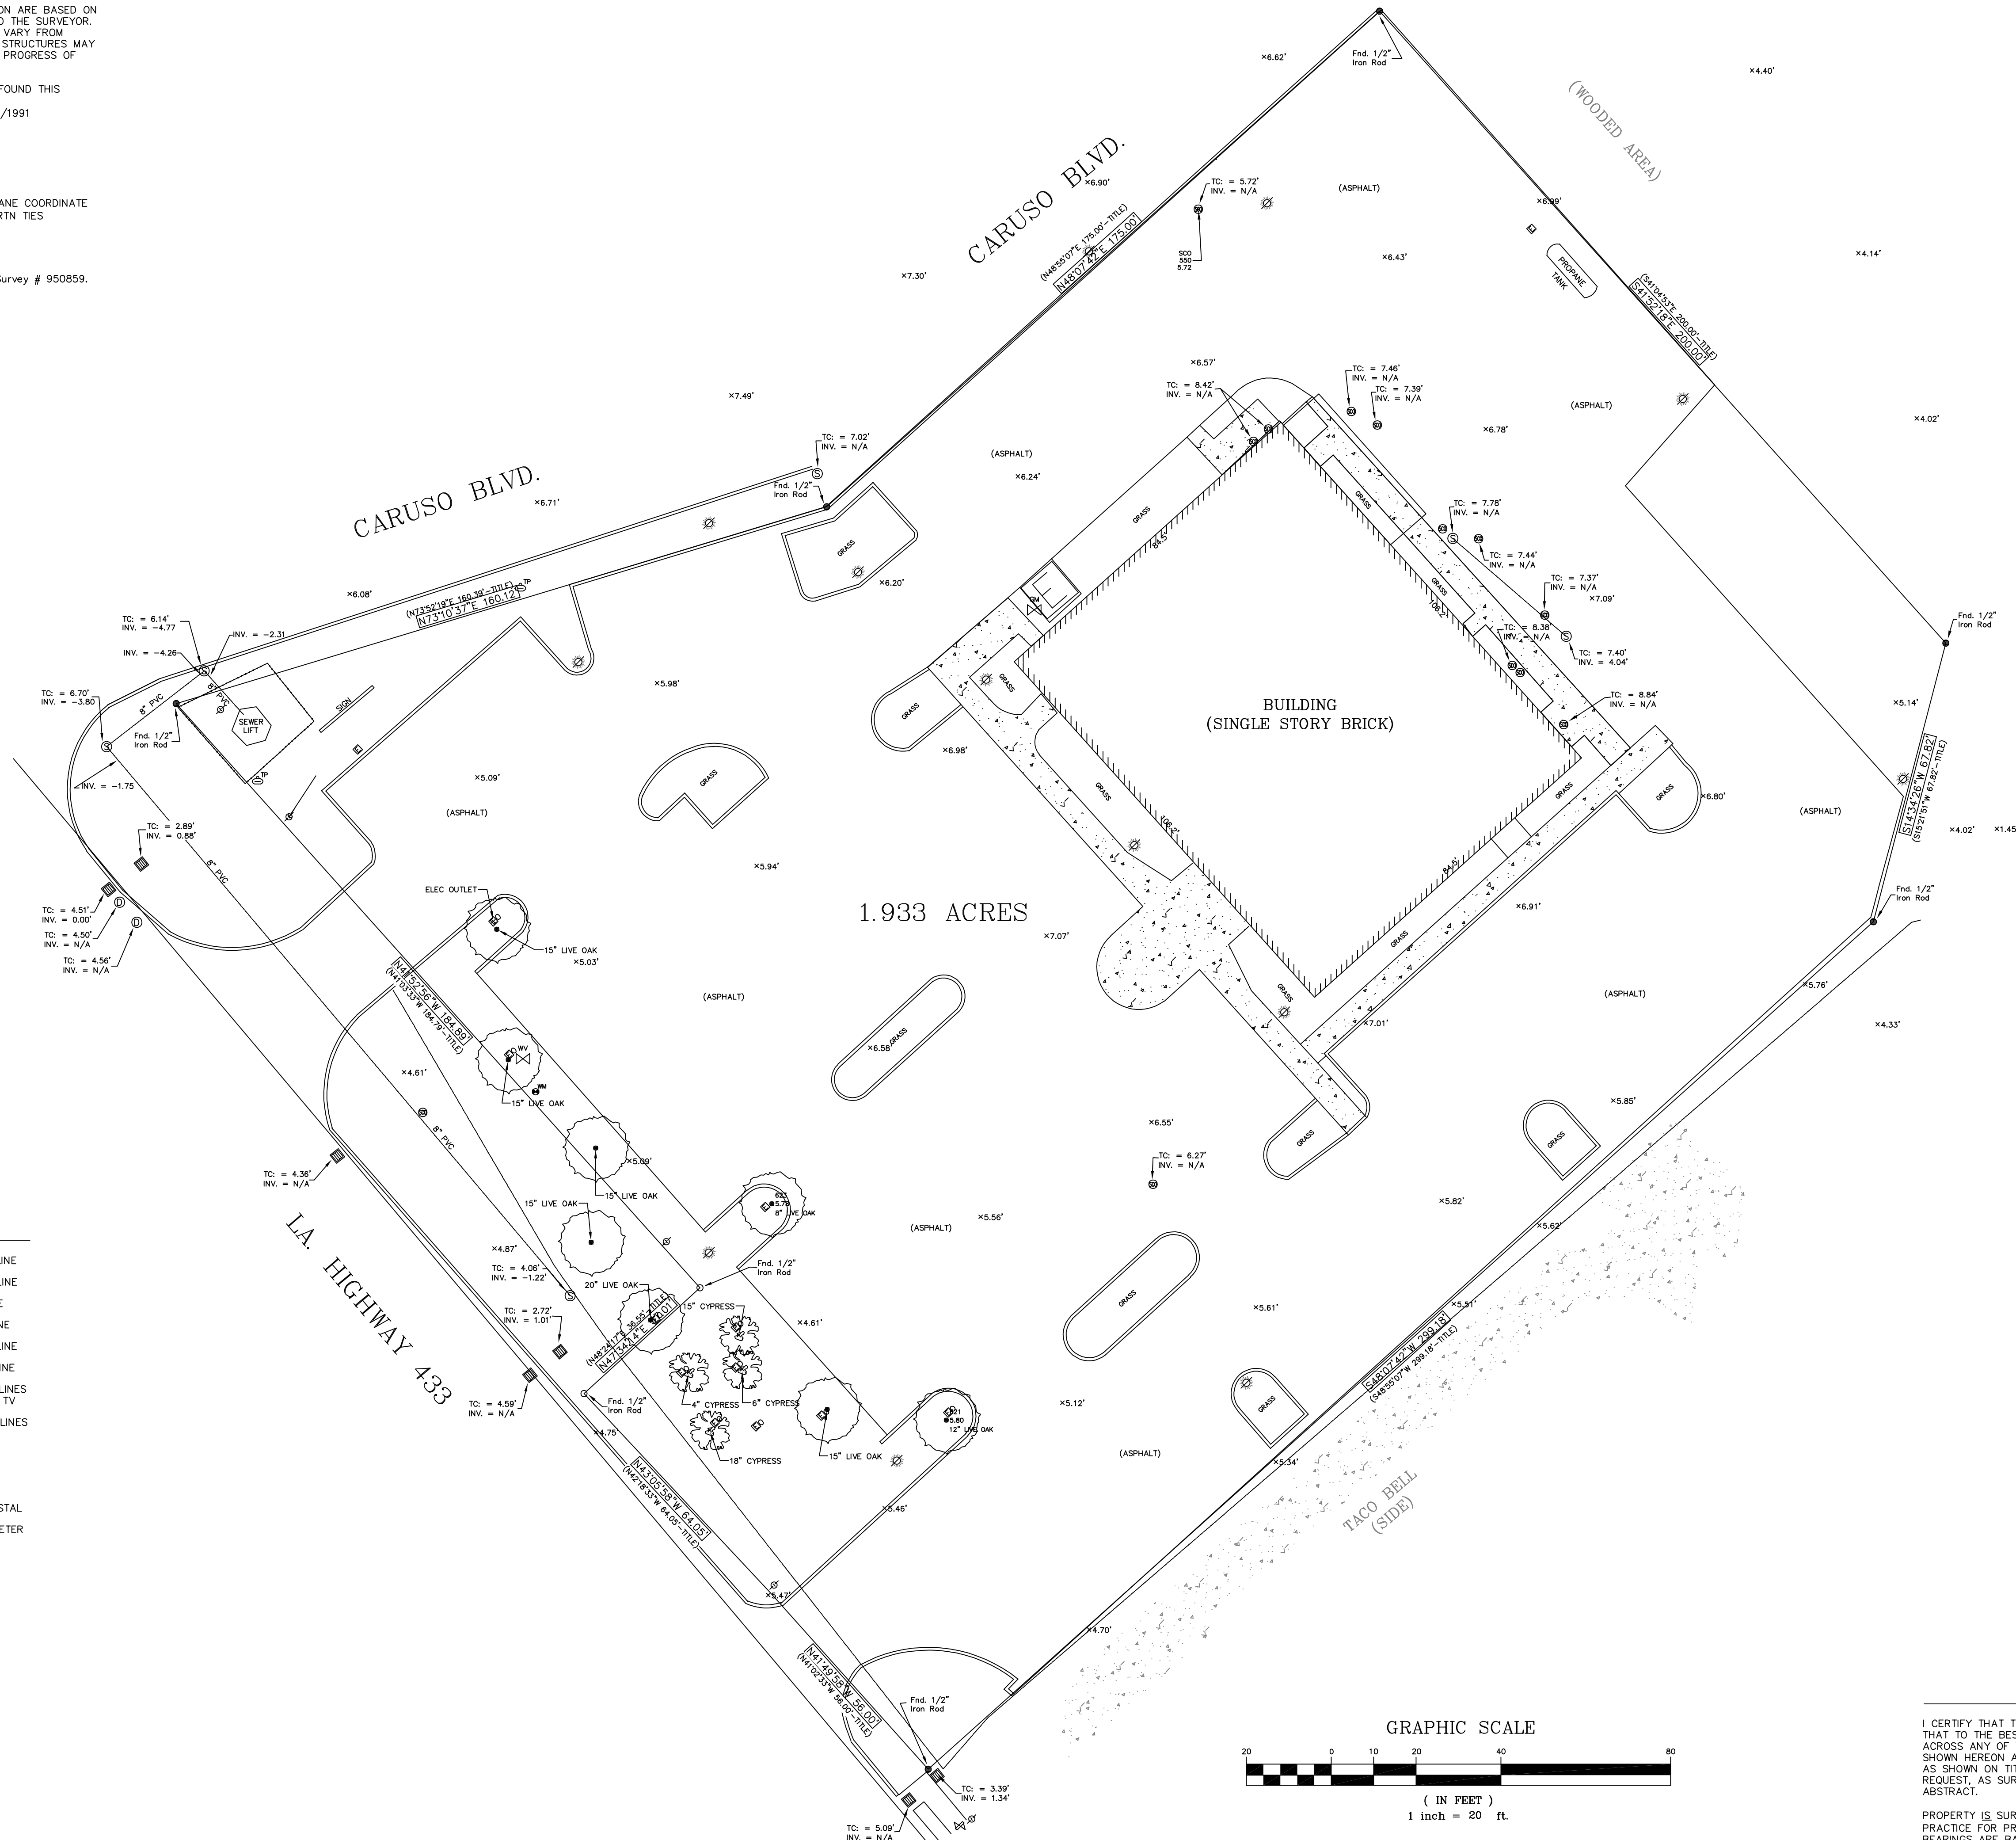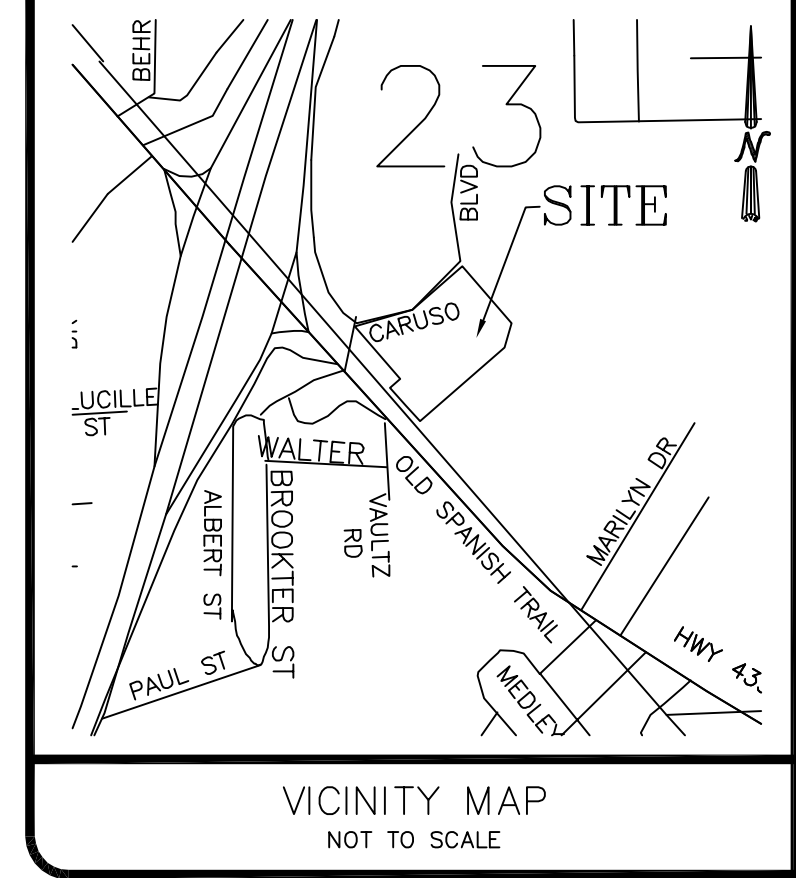

**LEGEND**

	S	SEWER MANHOLE, SEWER LINE
	W	WATER MANHOLE, WATER LINE
	G	GAS MANHOLE, GAS LINE
	T	TELE. MANHOLE, TELE. LINE
	D	DRAIN MANHOLE, DRAIN LINE
	D	DRAIN INLET, DRAIN LINE
	W	POWER POLE / OVERHEAD LINES
	E	ELEC. TOWER / OVERHEAD LINES
	CB	CATCH BASIN
	LS	LIGHT STANDARD
	TL	TRAFFIC LIGHT
	TP	TELE., ELEC., CATV PEDESTAL
	EM	GAS, WATER, ELECTRIC METER
	WV	GAS, WATER VALVE
	SC	SEWER, DRAIN CLEANOUT
	FH	FIRE HYDRANT
	GA	GUY WIRE ANCHOR
	S	SIGN
	P	PYLON
	MB	MAILBOX
	T	TREE
	SH	SHRUB
	F	FENCE

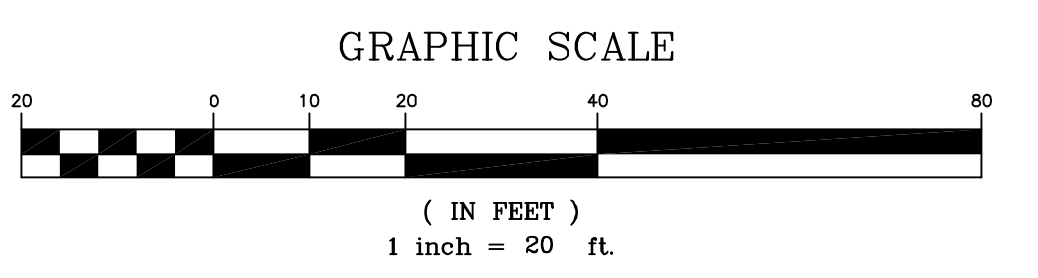

**CERTIFICATION**

I CERTIFY THAT THIS PLAT DOES REPRESENT AN ACTUAL GROUND SURVEY AND THAT TO THE BEST OF MY KNOWLEDGE NO ENCROACHMENTS EXIST EITHER WAY ACROSS ANY OF THE PROPERTY LINES, EXCEPT AS SHOWN. ENCUMBRANCES SHOWN HEREON ARE NOT NECESSARILY EXCLUSIVE. ENCUMBRANCES OF RECORD AS SHOWN AS SURVEYOR HAS NOT PERFORMED ANY TITLE SEARCH OR ABSTRACT.

PROPERTY IS SURVEYED IN ACCORDANCE WITH THE LOUISIANA "STANDARDS OF PRACTICE FOR PROPERTY BOUNDARY SURVEYS" FOR A CLASS C SURVEY. BEARINGS ARE BASED ON RECORD BEARINGS UNLESS NOTED OTHERWISE.

**SURVEYED BY:**  
S. BRETT FITZGERALD  
LA. REG. NO. 5018

**J.V. Burkes & Associates, Inc.**  
SURVEYING ENGINEERING • ENVIRONMENTAL

1805 Shortcut Highway  
Slidell, Louisiana 70458  
E-mail: jvbassoc@jvburkes.com  
Phone: 985-649-0075 Fax: 985-649-0154

NO.	DESCRIPTION	DATE	BY

A SURVEY PLAT OF A 1.933 ACRE PARCEL LOCATED IN SECTION 23, T-9-S, R-14-E, GREENSBURG LAND DISTRICT, ST. TAMMANY PARISH, LOUISIANA

DECLARATION IS MADE TO ORIGINAL PURCHASER OF THE SURVEY. IT IS NOT TRANSFERABLE TO ADDITIONAL INSTITUTIONS OR SUBSEQUENT OWNERS. SURVEY IS VALID ONLY IF PRINT HAS ORIGINAL SEAL OF SURVEYOR.

KE KAUFMANN & COMPANY, INC.

SCALE: 1" = 20'

DATE: 10/27/2022

DRAWN BY: VLL CHECKED BY: JDL

DWG. NO. 20220566

SHEET 1 OF 1

P:\FIELD\_1\RESURVEY\2461 - Jackson, George 2501 Old Spanish Trail\Drawings\Measure Drawings\20220566.dwg