

DAMMON ENGINEERING, INC.

EMMETT DAMMON

ARCHITECT ROBERT WILTSE

1095 FLORIDA AVENUE SLIDELL, LA. 70458

WEBSITE: WWW.DAMMONENGINEERING.COM

EMAIL: DAMMONENG@BELLSOUTH.NET

ARCHITECTURE ENGINEERING STUDIES PLANNING INVESTIGATION EXPERT WITNESS

MARCO'S PIZZA TENANT BUILDOUT

532 GAUSE BLVD SLIDELL, LA 70458

MECHANICAL PLAN



SCALE: AS NOTED

JOB#: 2083

DATE: 11-10-10

SHEET 5

M-1


OF 11

ROOFTOP AIR CONDITIONING UNIT SCHEDULE

Table with columns: MARK, AREA SERVED, TOTAL SUPPLY AIR, MIN OA, ESP IN WG, FAN MOTOR QTY, HP, FILTERS, COOLING DATA, COMP. DATA, HEATING DATA, UNIT ELECTRICAL DATA, BASIS OF DESIGN, UNIT WEIGHT, REMARKS.

- 1. ALL COOLING CAPACITIES SHOWN ARE BASED ON AN AMBIENT OUTDOOR TEMPERATURE OF 115° F.
2. CONTRACTOR SHALL INSTALL ALL NEW FILTERS PRIOR TO TEST AND BALANCE WORK.
3. PROVIDE LOW AMBIENT COOLING CAPABILITY DOWN TO 20°F.
4. PROVIDE ALL COMPRESSORS WITH 5 YEAR WARRANTIES.
5. ALL CAPACITIES LISTED ARE MINIMUM REQUIRED QUANTITIES.
6. PROVIDE UNIT WITH MOISTUREMISER FACTORY INSTALLED PACKAGE, TSATCPLH01-B THERMISTAT AND RCD-HN-61KK-324 RELAY.
7. MANUAL OUTSIDE AIR DAMPER OPTION AND MATCHED ROOF CURBS PROVIDED AND INSTALLED BY MECHANICAL CONTRACTOR.
8. OWNER HAS NATIONAL ACCOUNT AGREEMENT WITH YORK CORP. THIS CONTRACTOR TO UTILIZE THIS PRICING.
9. PROVIDE SMOKE DETECTORS IN EACH RTU WITH FAN SHUT DOWN RELAYS FOR UNIT SHUT DOWN.
10. CONTRACTOR TO VERIFY STRUCTURE AND COORDINATE RTU'S WITH LANDLORD.

H.V.A.C. SYMBOLS LEGEND

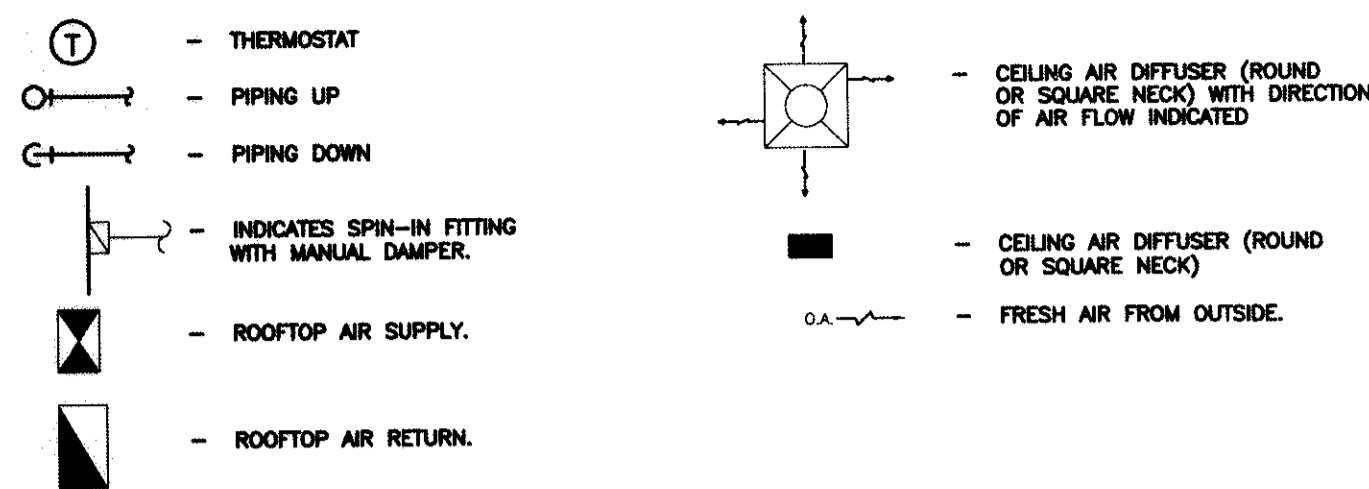

H.V.A.C. KEY NOTES

- 1. PROVIDE RETURN AIR FILTER GRILLES IN CEILING; PROVIDE DUCT TRANSITION FROM R.A. AT RTU TO SHEET METAL R.A. PLENUM.
2. CONDENSING UNIT ON ROOF OF BUILDING FOR WALK-IN COOLER. ATTACH TO METAL ROOF USING S-5 UTILITY CLAMPS (WWW.S-5.COM).
3. CONDENSATE DRAIN TO SANITARY SEWER P.C. (TYPICAL).
4. 8"x6" EXHAUST DUCT UP THRU 12" HIGH ROOF CURB TO EXHAUST DISCHARGE HOOD.
5. 21"x10" E.A. DUCT UP TO EF-2 ON ROOF. HOLD 10'-0" FROM O.A. INTAKES.
6. 18"x16" S.A. DUCT UP TO SUPPLY FAN (SF-1) ON ROOF.
7. DASHED LINE INDICATES EXHAUST FAN/SUPPLY FAN ON ROOF. REF. DWG M-2 FOR ADDITIONAL INFORMATION.
8. INTAKE TO BE A MINIMUM OF 10'-0" FROM EXHAUST.
9. THE EXHAUST OUTLET SHALL ALWAYS BE LOCATED AT THE REAR OF THE HOOD AND THE SUPPLY AIR INLET SHALL BE LOCATED AT THE SIDES OF THE HOOD. ACCOMMODATE THIS. CONTRACTOR SHALL PROVIDE OFFSETS IN THE SUPPLY AIR DUCT WHERE REQUIRED.
10. MECHANICAL CONTRACTOR SHALL COORDINATE THERMOSTAT MOUNTING LOCATION WITH CONTRACTOR INSTALLING EQUIPMENT IN THIS AREA. THERMOSTAT SHALL NOT BE LOCATED NEAR EQUIPMENT WHICH PRODUCES HEAT OR HUMIDITY. TYPICAL FOR ALL.
11. O.A. INTAKE HOOD SHALL BE A MINIMUM OF 10'-0" FROM ANY EXHAUST, GAS OR PLUMBING VENT.
12. MECHANICAL CONTRACTOR SHALL INSTALL ALL CONDENSATE DRAIN LINE CONNECTIONS FOR WALK-IN COOLER. M.C. SHALL INSTALL COMPRESSOR AND EVAPORATOR AND MAKE FINAL CONNECTIONS.
13. ALL ROOF MOUNTED HVAC EQUIPMENT SHALL BE HELD A MINIMUM OF 10'-0" FROM THE EDGE OF ROOF, UNLESS BUILDING HAS 42" PARAPET WALL OR 42" GUARD RAILS. M.C. SHALL PROVIDE GUARD RAILS AROUND EQUIPMENT IF ABOVE CONDITIONS ARE NOT MET.
14. 24"x24" LOUVER IN BATHROOM DOOR. REFER TO ARCHITECTURAL DRAWINGS FOR DETAIL. LOUVER TO BE FURNISHED AND INSTALLED BY G.C.
15. STRAP OR ANCHOR UNIT ACCORDING TO THE MANUFACTURER'S RECOMMENDATION FOR 130 MPH WINDS WITH A 30 SECOND GUST.

H.V.A.C. GENERAL NOTES

- A. ALL SUPPLY, RETURN DUCTS AND OUTSIDE AIR DUCTS INSIDE BUILDING SHALL BE INSULATED EXTERNALLY WITH 1 1/2" THICK FIBERGLASS WITH A DENSITY OF 1.5 POUNDS PER CUBIC FOOT AND BE COMPLETE WITH VAPOR BARRIER JACKET. ALL DUCT INSULATION, TAPE COVERINGS, AND FLEXIBLE CONNECTORS SHALL HAVE A FLAME SPREAD RATING OF 25 OR LESS AND A SMOKE DEVELOPED RATING OF 50 OR LESS IN ACCORDANCE WITH ASTM E84. ALL SA/RA/OA DUCT INSULATION SHALL HAVE A MINIMUM "R" VALUE EQUAL OR GREATER THAN 7.5. ALL INSULATION SHALL MEET REQUIREMENTS OF STATE AND LOCAL CODES AND MECHANICAL CODES.
B. ALL FLEXIBLE DUCTS SHALL BE METAL FLEX CLASS 1 TYPE 500 AIR DUCT AND SHALL BE U.L. LISTED AND HAVE 1" THICK FIBERGLASS INSULATION ENCASED IN A VAPOR BARRIER OF SEAMLESS, NON-COMBUSTIBLE, CO-POLYMER PLASTIC.
C. ALL FLEXIBLE DUCTS SHALL BE CONNECTED TO TRUNK OR BRANCH DUCTS WITH A MINIMUM OF THREE SHEET METAL SCREWS AT EACH CONNECTION AND BE TAPED TO PROVIDE AN AIR TIGHT SEAL. MAXIMUM LENGTH OF FLEXIBLE DUCT SHALL BE 5'-0". REFER TO DETAIL.
D. FLEXIBLE DUCT HANGER STRIPS SHALL BE MINIMUM 2" WIDE BY 22 GAUGE GALVANIZED METAL.
E. ALL DUCTWORK SHALL BE INSTALLED IN ACCORDANCE WITH THE MOST RECENT PUBLISHED SMACNA STANDARDS FOR LOW-VELOCITY, LOW-PRESSURE DUCTS.
F. ALL CONTROL WIRING SHALL BE FURNISHED AND INSTALLED BY H.V.A.C. CONTRACTOR.
G. THERMOSTATS SHALL BE HONEYWELL T-7300/07300 B1008 OR EQUAL WITH SHIELDED CABLE. ALL THERMOSTATS AND LOW VOLTAGE WIRING SHALL BE FURNISHED AND INSTALLED BY MECHANICAL CONTRACTOR.
H. HOOD EXHAUST AND SUPPLY FANS SHALL BE FURNISHED WITH BIRD SCREENS, DISCONNECT SWITCHES AND HINGED BASE ON EXHAUST FAN.
I. H.V.A.C. CONTRACTOR SHALL INSTALL EXHAUST FAN AND FURNISH AND INSTALL COMPLETE EXHAUST DUCT SYSTEM. DUCTS SHALL BE INSULATED WITH MINERAL WOOL AND COVERED WITH 20 GA. STAINLESS STEEL COVER WHERE EXPOSED.
J. MIDWEST PIZZA EQUIPMENT TO FURNISH SUPPLY FAN AND CURB. MECHANICAL CONTRACTOR TO INSTALL SUPPLY FAN, CURB, AND DUCT SYSTEM COMPLETE.
K. PROVIDE NEOPRENE FLEXIBLE CONNECTIONS AT SUPPLY AND RETURN DUCT CONNECTIONS ON H.V.A.C. UNITS.
L. H.V.A.C. CONTRACTOR SHALL BALANCE H.V.A.C. SYSTEM TO AIR QUANTITIES INDICATED. PROVIDE TYPED WRITTEN REPORT TO OWNER UPON COMPLETION.
M. CONTRACTOR SHALL VISIT SITE PRIOR TO SUBMITTING BID TO VERIFY ALL EXISTING CONDITIONS.
N. CONTRACTOR SHALL FIELD VERIFY DUCT CLEARANCE/ SPACE FOR ROUTING DUCTS PRIOR TO SUBMITTING BID. CONTRACTOR MAY ALTER DUCT SIZES TO ACCOMMODATE CLEARANCES ABOVE CEILING, BUT MUST MAINTAIN SAME EFFECTIVE DUCT AREA.
O. ALL WORK SHALL BE FURNISHED AND INSTALLED TO COMPLY WITH ALL STATE AND LOCAL CODES.
P. M.C. SHALL PROVIDE ALL REQUIRED DUCT TRANSITIONS FROM PIZZA OVEN HOOD CONNECTIONS TO SUPPLY AIR AND EXHAUST AIR DUCT SIZES INDICATED.
Q. MECHANICAL CONTRACTOR SHALL PROVIDE AS-BUILT DRAWINGS TO GENERAL CONTRACTOR PRIOR TO FINAL PAYMENT.
R. SMOKE DETECTORS FOR FAN SHUT-DOWN WHERE REQUIRED BY MECHANICAL CODE SHALL BE FURNISHED AND INSTALLED BY THE ELECTRICAL CONTRACTOR. REFER TO ELECTRICAL DRAWINGS.
S. ALL ROOF MOUNTED HVAC EQUIPMENT INCLUDING COOLER CONDENSING UNITS SHALL BE HELD A MINIMUM OF 10'-0" FROM THE EDGE OF ROOF.
T. ALL HOOD AND HOOD EXHAUST DUCT SUPPORTS AND HANGERS TO BE SECURED BY NON-COMBUSTIBLE SUPPORTS AND INSTALLED PER SMACNA STANDARDS AND NFPA 96.
U. TYPE 1 HOOD EXHAUST DUCT SHALL BE MINIMUM OF 16 GAUGE AND TYPE 2 HOOD EXHAUST DUCT SHALL BE MINIMUM OF 24 GAUGE WELDED CARBON STEEL PER SMACNA STANDARDS.
V. SHEET METAL SA/RA/OA DUCTWORK SHALL COMPLY WITH THE FOLLOWING GAUGES: DIMENSION OF LONGEST SIDE: 26" THRU 30" 0" - 12" 13" TO 18" SHEET METAL GAUGES: 26 24
W. ALL JOINTS, LONGITUDINAL AND TRANSVERSE SEAMS, AND CONNECTIONS IN DUCTWORK MUST BE SECURELY SEALED USING WELDMENTS, MECHANICAL FASTENERS WITH SEALS, GASKETS, OR MASTICS; MESH AND MASTIC SEALING SYSTEMS, OR TAPES, TAPES AND MASTICS MUST BE LISTED AND LABELED IN ACCORDANCE WITH UL 181A OR UL 181B.
X. MECHANICAL FASTENERS AND SEALS, MASTICS, OR GASKETS MUST BE USED WHEN CONNECTING DUCTS TO FANS OR OTHER AIR DISTRIBUTION EQUIPMENT, INCLUDING MULTIPLE-ZONE.
Y. OPERATION AND MAINTENANCE DOCUMENTATION MUST BE PROVIDED TO THE OWNER THAT INCLUDES AT LEAST THE FOLLOWING INFORMATION: a) EQUIPMENT CAPACITY (INPUT AND OUTPUT) AND REQUIRED MAINTENANCE ACTIONS. b) EQUIPMENT OPERATION AND MAINTENANCE MANUALS. c) HVAC SYSTEM CONTROL, MAINTENANCE AND CALIBRATION INFORMATION, INCLUDING WIRING DIAGRAMS, SCHEMATICS, AND CONTROL DRAWINGS, AT CONTROL DEVICES, OR, FOR DIGITAL CONTROL SYSTEMS, IN PROGRAMMING COMMENTS. d) COMPLETE NARRATIVE OF HOW EACH SYSTEM IS INTENDED TO OPERATE.
Z. EACH SUPPLY AIR OUTLET OR DIFFUSER MUST HAVE ITS OWN BALANCING DEVICE. ACCEPTABLE BALANCING DEVICES INCLUDE ADJUSTABLE DAMPERS LOCATED WITHIN THE DUCTWORK, TERMINAL DEVICES, AND SUPPLY AIR DIFFUSERS.

AIR BALANCE SCHEDULE

Table with columns: ITEM, O.A., R.A., S.A., E.A., PRESSURE. Includes items AHU-1, AHU-2, AHU-3, SF-1, EF-1, EF-2.

EXHAUST FAN SCHEDULE

Table with columns: MARK, MFR., MODEL, SERVICE, CFM, S.P., HP, VOLTAGE. Includes items EF-1, EF-2, SF-1.

RETURN / SUPPLY AIR DIFFUSER SCHEDULE

Table with columns: ITEM, MFR., TYPE, MODEL, SIZE, NECK SIZE. Includes items TTUS, TMS, TNS, 50F-A.


- NOTE:
1. DIFFUSERS SHALL HAVE OPPOSED BLADE DAMPERS.
2. DIFFUSERS SHALL FIT 24" X 24" LAY-IN CEILING GRID.
3. DIFFUSERS SHALL BE LOUVER FACE TYPE, WITH BAKED ENAMEL FINISH EXCEPT FOR PERFORATED DIFFUSERS IN KITCHEN AREA.
4. DIFFUSERS/GRILLES SHALL BE EQUAL TO ANEMOSTAT, CARNES, METALARE, TITUS
5. RA GRILLES TO BE ALUMINUM, EGG-CRATE TYPE, 1/2"x1/2" SPACING WITH WHITE FINISH.

RESPONSIBILITY NOTES

- 1. ROOF OPENING FOR H.V.A.C. EQUIPMENT AND RELATED WORK SHALL BE THE RESPONSIBILITY OF THE H.V.A.C. SUBCONTRACTOR. HE SHALL NOTIFY THE LANDLORD'S ROOFER FOR HIS WORK TO MAINTAIN THE ROOF SOUND.
2. THE H.V.A.C. SUBCONTRACTOR SHALL IDENTIFY ALL ROOF MOUNTED H.V.A.C. EQUIPMENT AND APPARATUS WITH 2" HIGH PAINTED ORANGE SPHERE MARK ON ALL SIDES OF THIS EQUIPMENT.
3. IF DRAWINGS CALL FOR THE REUSE OF EXISTING EQUIPMENT, THE TENANT'S GENERAL CONTRACTOR SHALL VERIFY THAT ALL SUCH EQUIPMENT IS IN PROPER WORKING ORDER. THE NECESSARY STEPS TO ACCOMPLISH SUCH IF REPLACEMENT IS REQUIRED USE THE EQUIPMENT AND MARKING AS SPECIFIED ON THESE SCHEDULES OR AS CALLED OUT ON THE SPECIFICATIONS ON THIS SHEET. ALL SUCH ITEMS MUST MEET ALL GOVERNING CODES AND STANDARDS OF PRACTICE.

MECHANICAL NOTES:

- 1. CONTRACTORS AND SUB-CONTRACTORS SHALL CAREFULLY REVIEW THE CONSTRUCTION DOCUMENTS. INFORMATION REGARDING THE COMPLETE WORK IS DISPERSED THROUGHOUT THE DOCUMENT SET AND CANNOT BE ACCURATELY DETERMINED WITHOUT REFERENCE TO THE COMPLETE DOCUMENT SET.
2. ALL WORK SHALL COMPLY WITH STATE AND LOCAL CODE REQUIREMENTS AS APPROVED AND AMENDED BY THE GOVERNING CITY. PURCHASE ALL PERMITS ASSOCIATED WITH THE WORK. OBTAIN ALL INSPECTORS REQUIRED BY CODE.
3. USE OF COMBUSTIBLE MATERIALS IS NOT ALLOWED IN THE RETURN AIR PLENUM. MATERIALS USED IN THE PLENUM SHALL HAVE FLAME SPREAD RATING NOT TO EXCEED 25, AND SMOKE DEVELOPED RATING NOT TO 50 WHEN TESTED IN ACCORDANCE WITH ASTM E 84. ALL EXPOSED WIRING IN THE PLENUM SHALL BE PLENUM RATED.
4. CONTRACT LANDLORD APPROVED ROOFING CONTRACTOR TO FLASH AND SEAL ROOF PENETRATIONS TO MAINTAIN ROOFING WARRANTY.
5. ALL ROOF PENETRATIONS MUST BE APPROVED BY THE LANDLORD PRIOR TO INSTALLATION.
6. EXPOSED DUCTWORK TO BE GALVANIZED SHEET METAL PER SMACNA STANDARDS. LINE WITH NEOPRENE COATED 1.0", 1.5 POUNDS PER CUBIC FOOT DUCT INSULATION.
7. ROUND FLEXIBLE DUCT TO BE UL-181, CLASS I, AIR DUCT MATERIALS.
8. DUCT SIZES SHOWN ARE CLEAR INSIDE DIMENSIONS.
9. IN ALL SYSTEMS OVER 2,000 CFM AND LESS THAN 15,000 CFM, SMOKE DETECTORS SHALL BE INSTALLED IN ACCORDANCE WITH NFPA 72E IN THE RETURN DUCT DOWNSTREAM OF THE AIR HANDLING UNIT AND ALL FILTERS, TO AUTOMATICALLY STOP THE FAN.
10. PROVIDE U.L. LISTED 125 F FIRESHOT IN RETURN AIR OF EACH SYSTEM UNDER 2,000 CFM TO SHUT DOWN FAN IN THE EVENT OF FIRE.
11. PROVIDE U.L. RATED FIRE DAMPERS WHERE REQUIRED AT ALL DUCT PENETRATIONS OF FIRE-RATED ASSEMBLIES AND WHERE REQUIRED BY CODE, INCLUDING OUTSIDE AIR INTAKES.
12. ALL AIR HANDLING SYSTEMS TO BE BALANCED TO ASSURE PROPER AIR FLOWS PER PLANS.
13. EXHAUST FAN EQUAL TO BROAN MODEL NO. 100 CF. OR EQUAL. FAN SHALL BE CONTROLLED BY SWITCH ON WALL AT LIGHT SWITCH. PROVIDE BACK DRAFT DAMPER.
14. PROVIDE AND INSTALL WATER PROOF GRILLE VENT ON ROOF FOR TOILET EXHAUST.
15. ALL ELECTRICAL, MECHANICAL AND PLUMBING PENETRATING FIRE PARTITIONS SHALL BE FIRE CAULKED. (PENETRATIONS THROUGH RATED CONSTRUCTION SHALL BE SEALED WITH A MATERIAL CAPABLE OF PREVENTING THE PASSAGE OF FLAMES AND HOT GASES WHEN TESTED IN ACCORDANCE WITH ASTM-E814.)

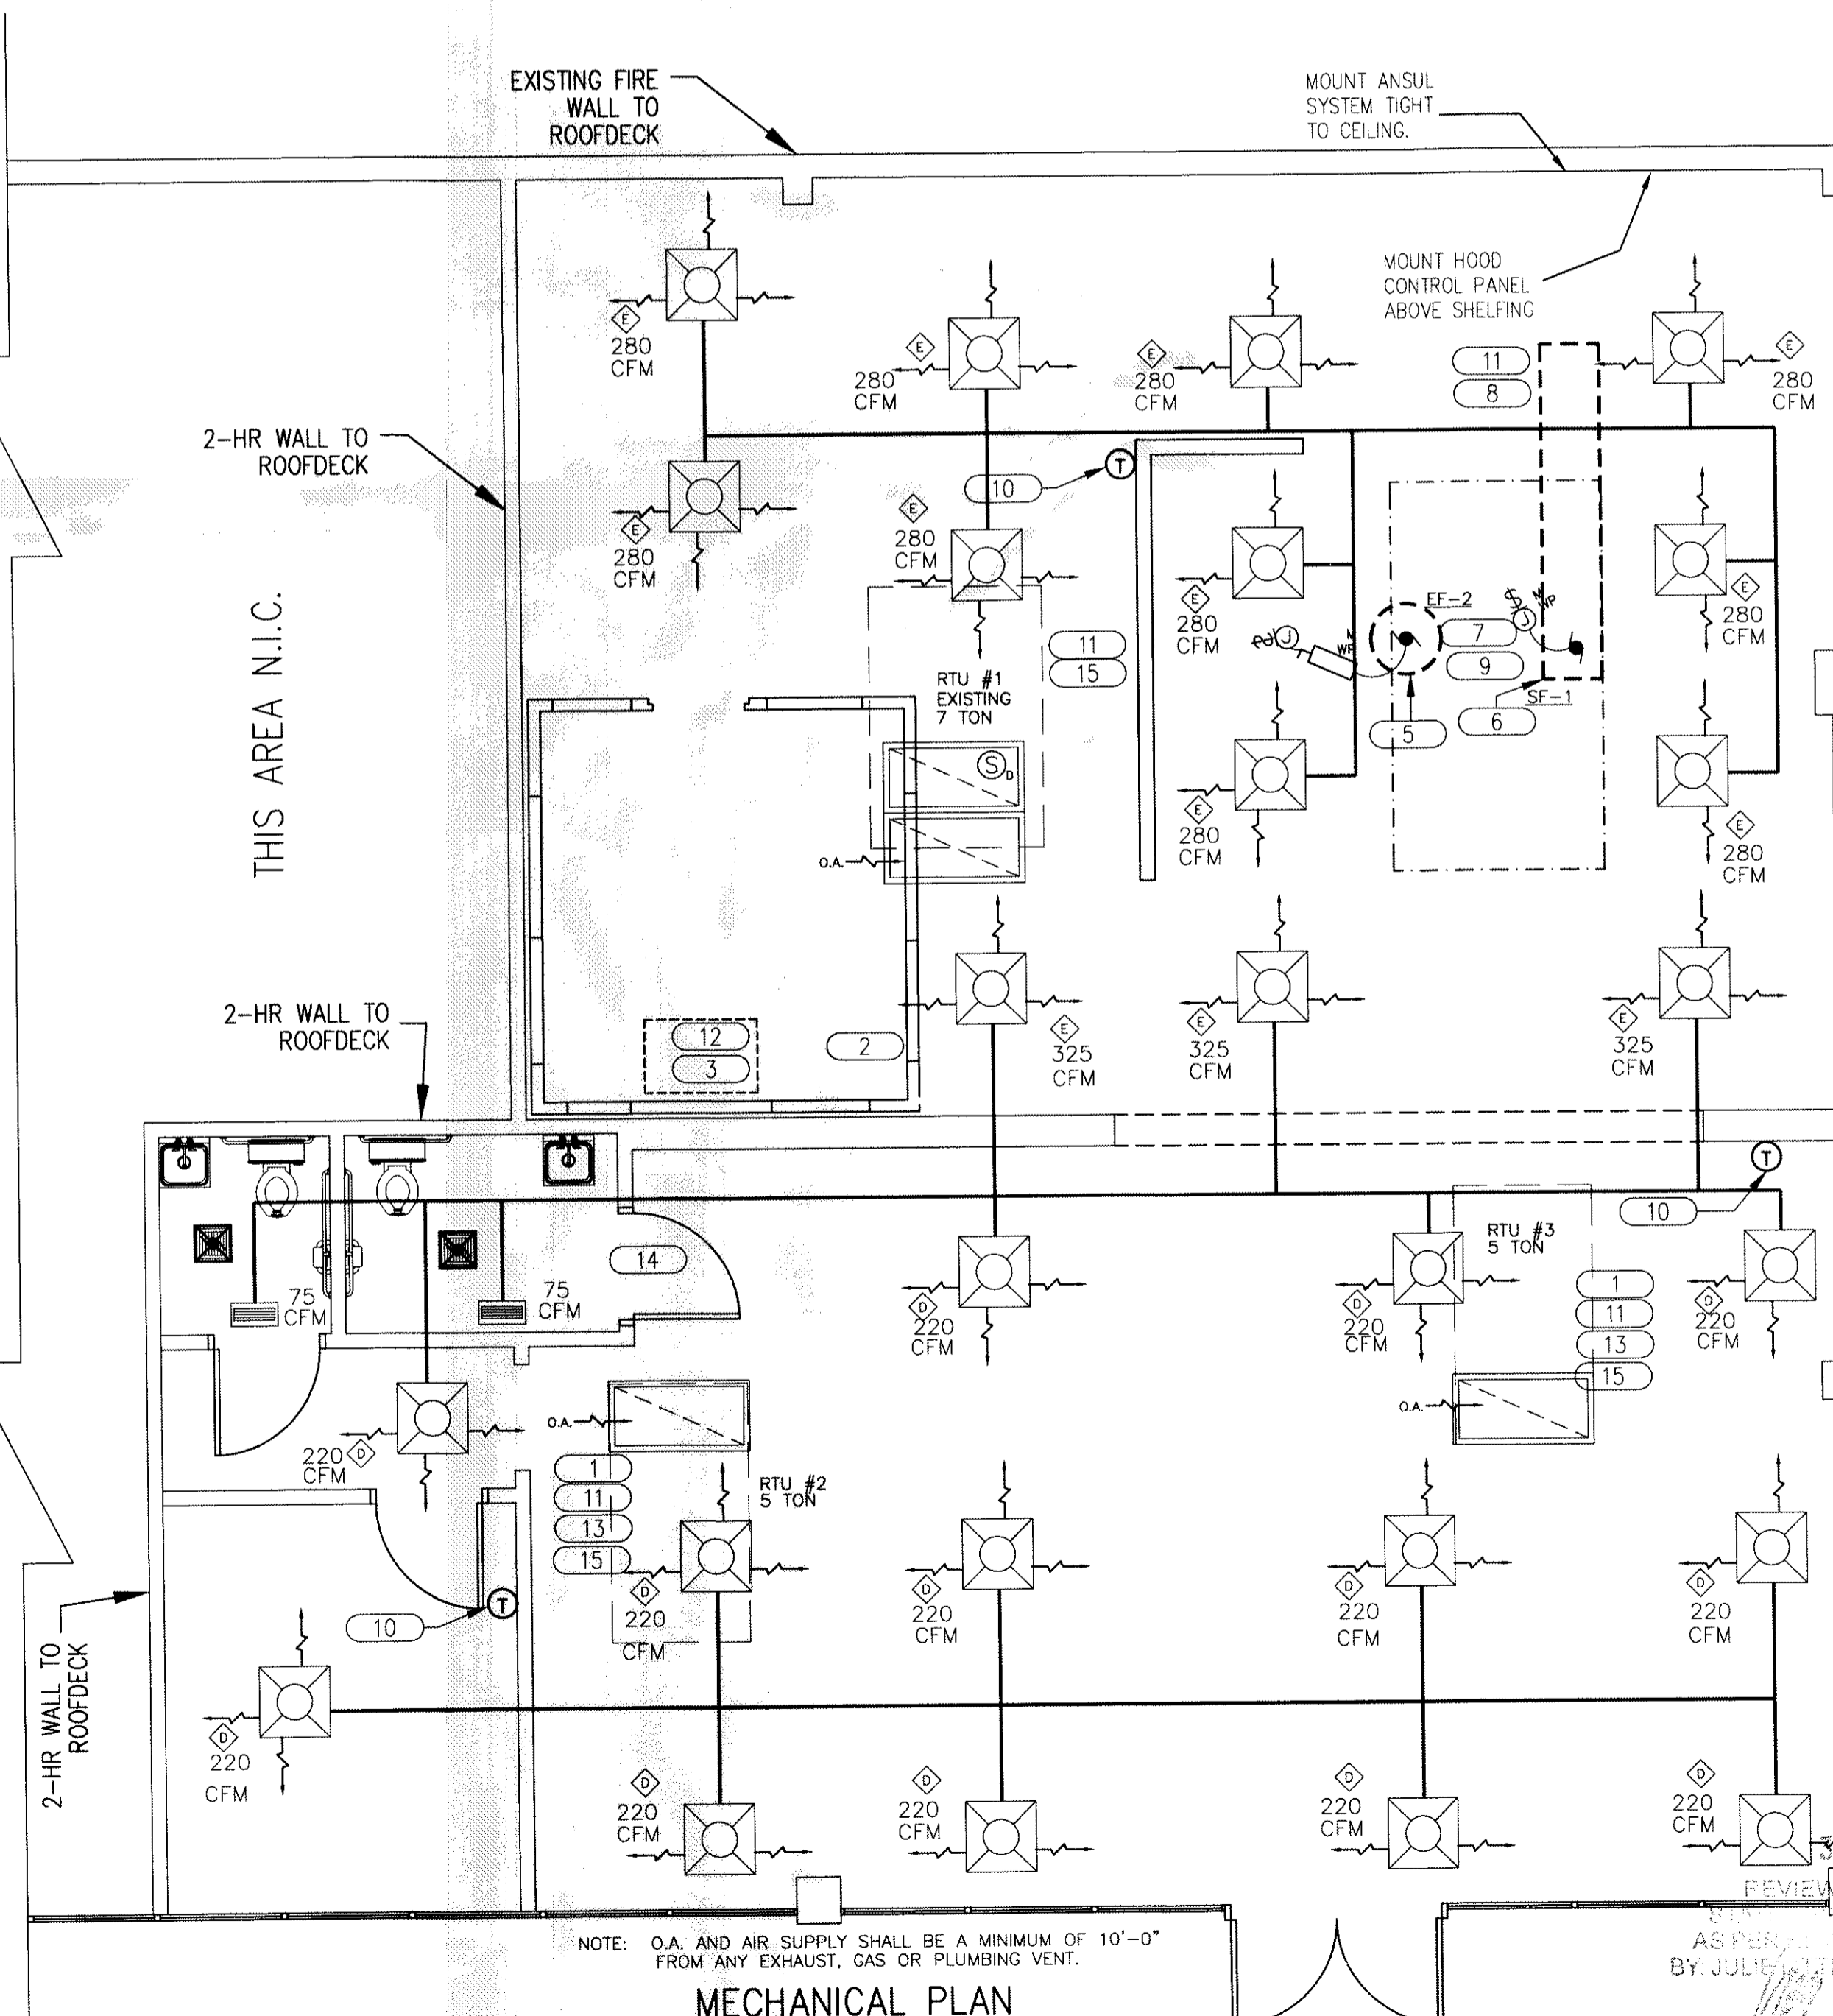

MECHANICAL PLAN SCALE: 1/4" = 1'-0"

REVIEWED FOR... AS PER... BY JULIE... 11/10/10