

PARTIAL ATTIC FLOOR PLAN
SCALE 1/8" = 1'-0"



1
A2.1

2
A2.1

3
A2.1


4
A2.1

ROOM	CARE
10	
11	
12	
13	
14	
15	

Keep 1st 4 blocks to support new beam. Each block 8"x8"

Open span = 16'-8"

REMOVE

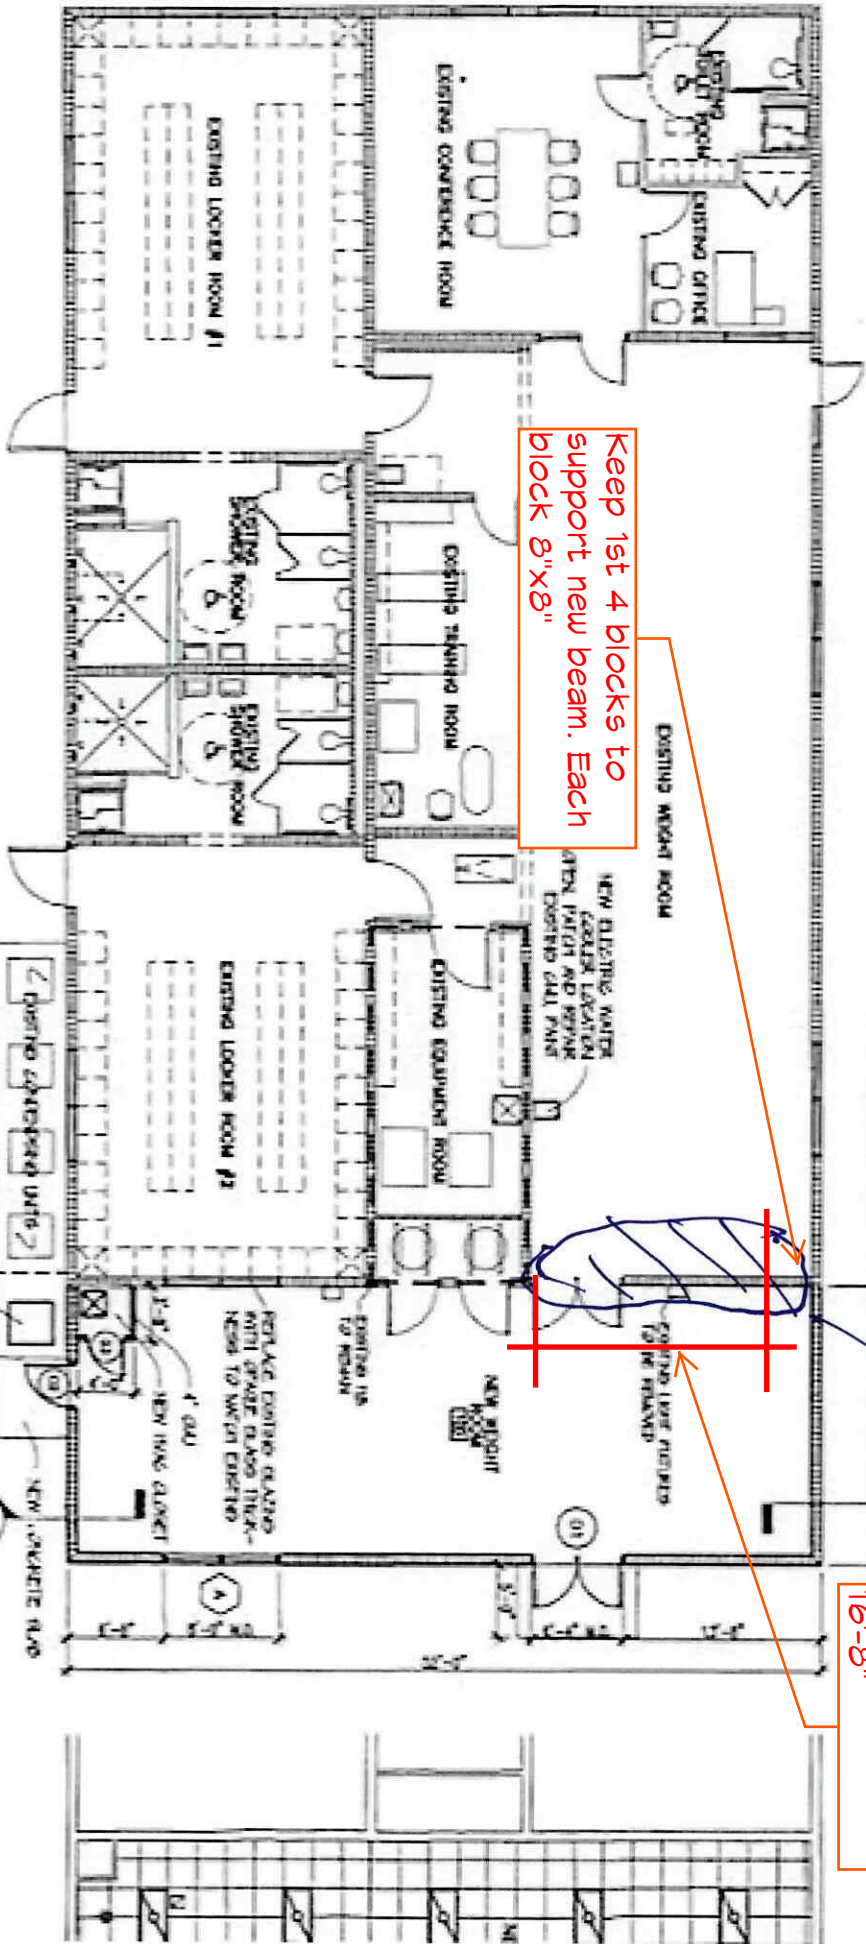

FLOOR PLAN
SCALE 1/8" = 1'-0"



1
A2.1

2
A2.1

3
A2.1


4
A2.1

5
A2.1

6
A2.1

7
A2.1

8
A2.1

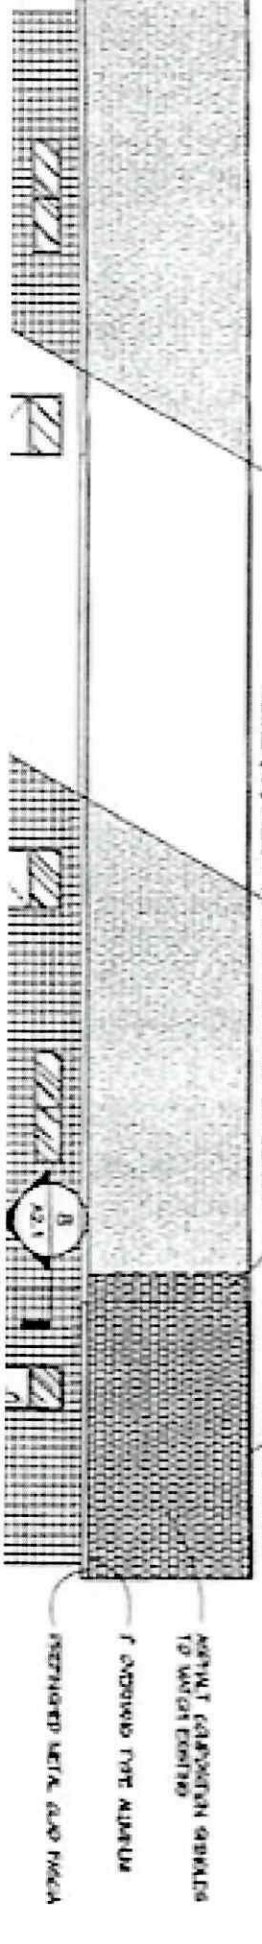

REFLECTED
SCALE 1/8" = 1'-0"



1
A2.1

2
A2.1

3
A2.1

4
A2.1

5
A2.1

6
A2.1

7
A2.1

8
A2.1