


SPECIFIC NOTES:

1 ALL DEVICES INSTALLED IN PATIENT AREAS TO BE ANTI-LIGATURE/TAMPER PROOF (TYPICAL).

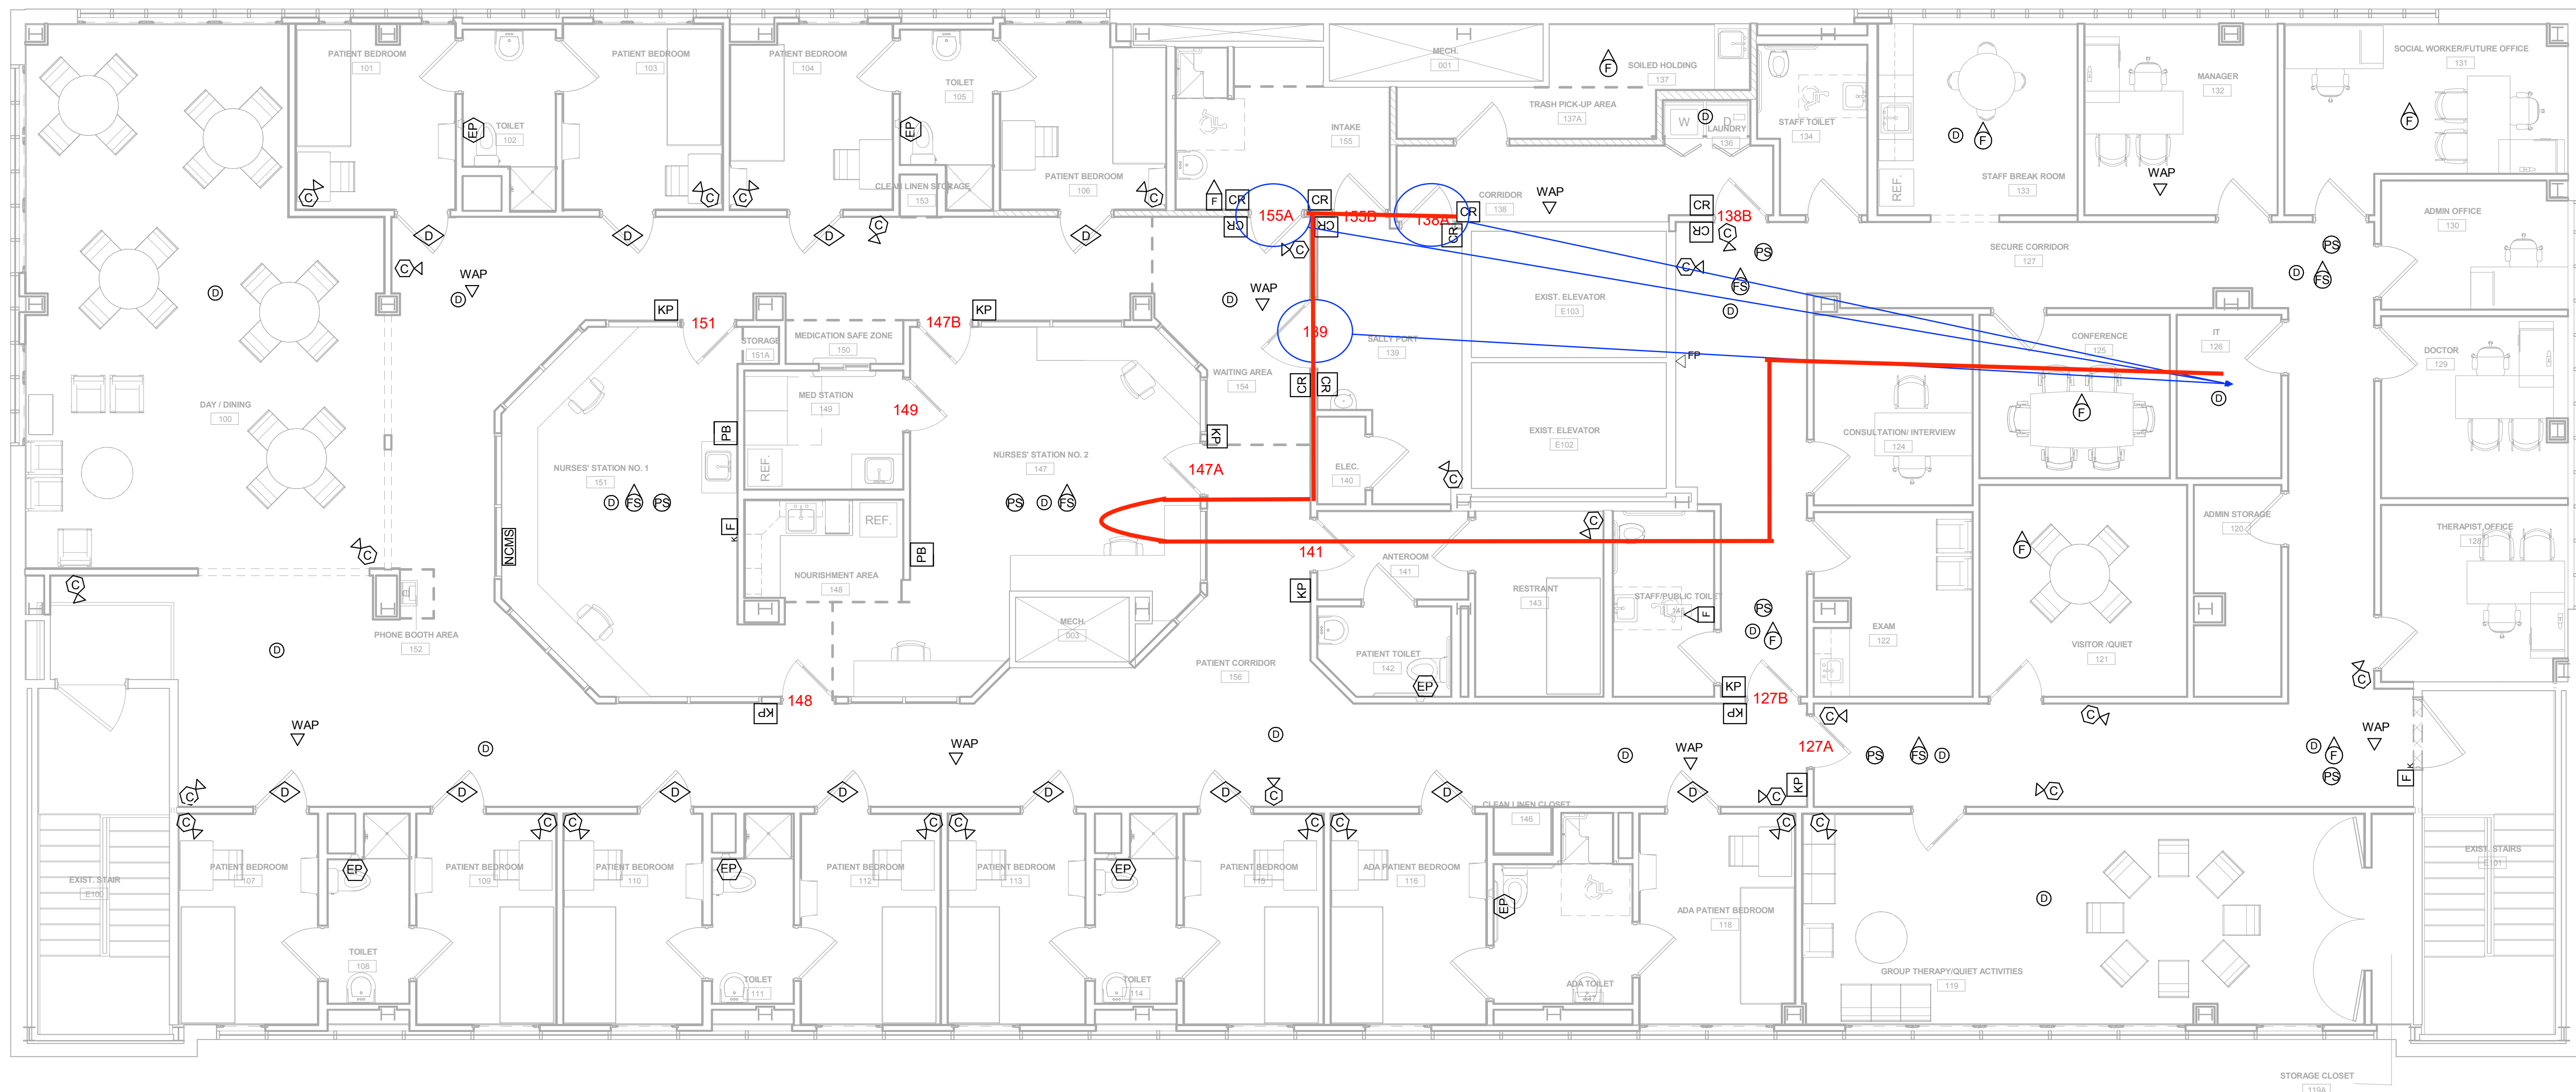

Each door as you know will have an electric strike. There are just three doors now.
All read in / read out. All are to be home run'd into the IT Closet. The RED LINE
is how the wiring is being done. there is conduit routing to the nurses station then back out.

1 THIRD FLOOR SYSTEMS PLAN
3/16" = 1'-0"

YKM Consulting LLC
YENARI • KELLY • MONTGOMERY
Mechanical • Electrical • Plumbing
3500 N. Causeway Blvd, Suite 2240, Metairie, LA 70002
ykmconsulting.com 504.284.5111

Job No: 1607301 Designed By: PJW
Drawn By: PJW Checked By: CMH

THIRD FLOOR BUILDOUT FOR

OUR LADY OF THE ANGELS HOSPITAL: BEHAVIORAL HEALTH UNIT
433 PLAZA STREET, BOGALUSA, LA



Revision No.	Date	Remarks

Sheet Name
3RD FLOOR - SYSTEMS PLAN

CONSTRUCTION SET

Job No: 216025.01	Sheet No:
Drawn by: PJW	E-501
Checked by: CMH	
Date: 02.06.2017	