


THIS OUTLET FOR RAINBIRD IRRIGATION. VERIFY LOCATION W/LANDSCAPING

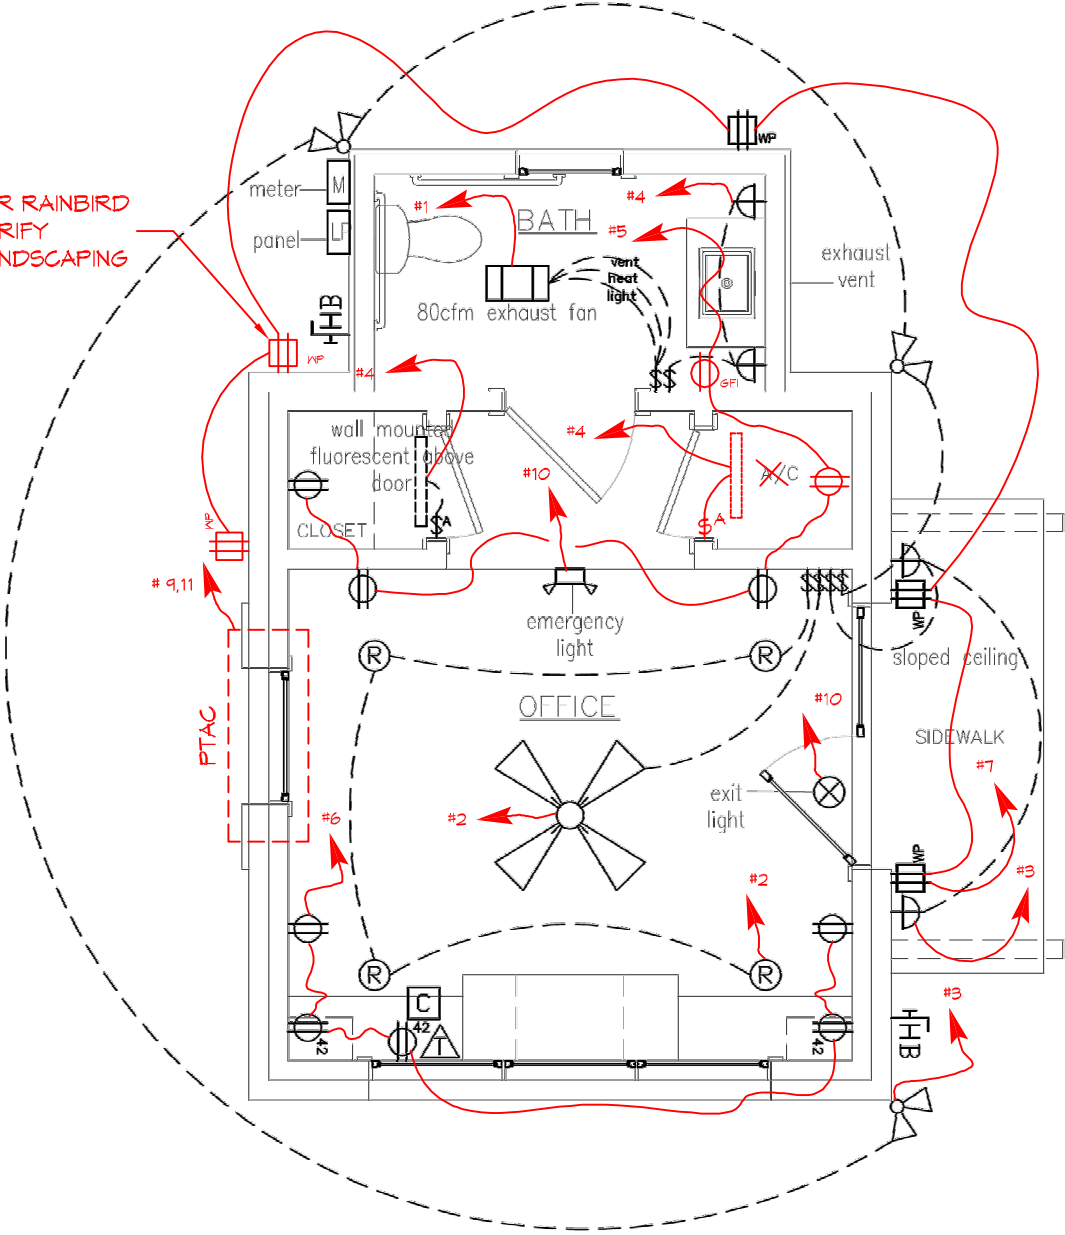

1 **ELECTRICAL** Plan
Scale: 1/4" = 1'-0"