
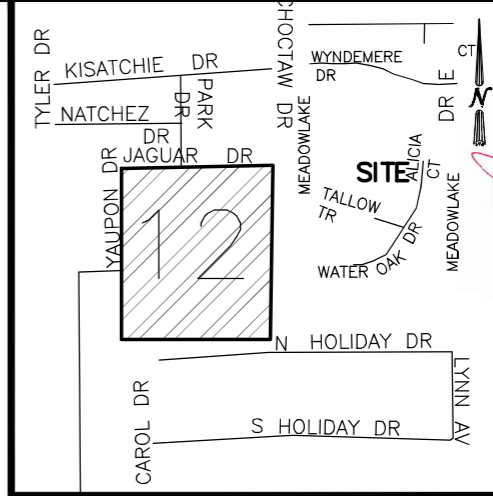
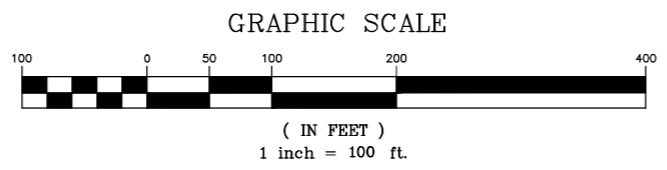


PATFILE: Z:\SURVEYING\2024\BOUNDARY SURVEY\109-R14A.SEC. 12\20240390_POPE JOHN PAUL HS_KB KAUFMAN\DAEMON DETAILS\20240390_STARING.DWG

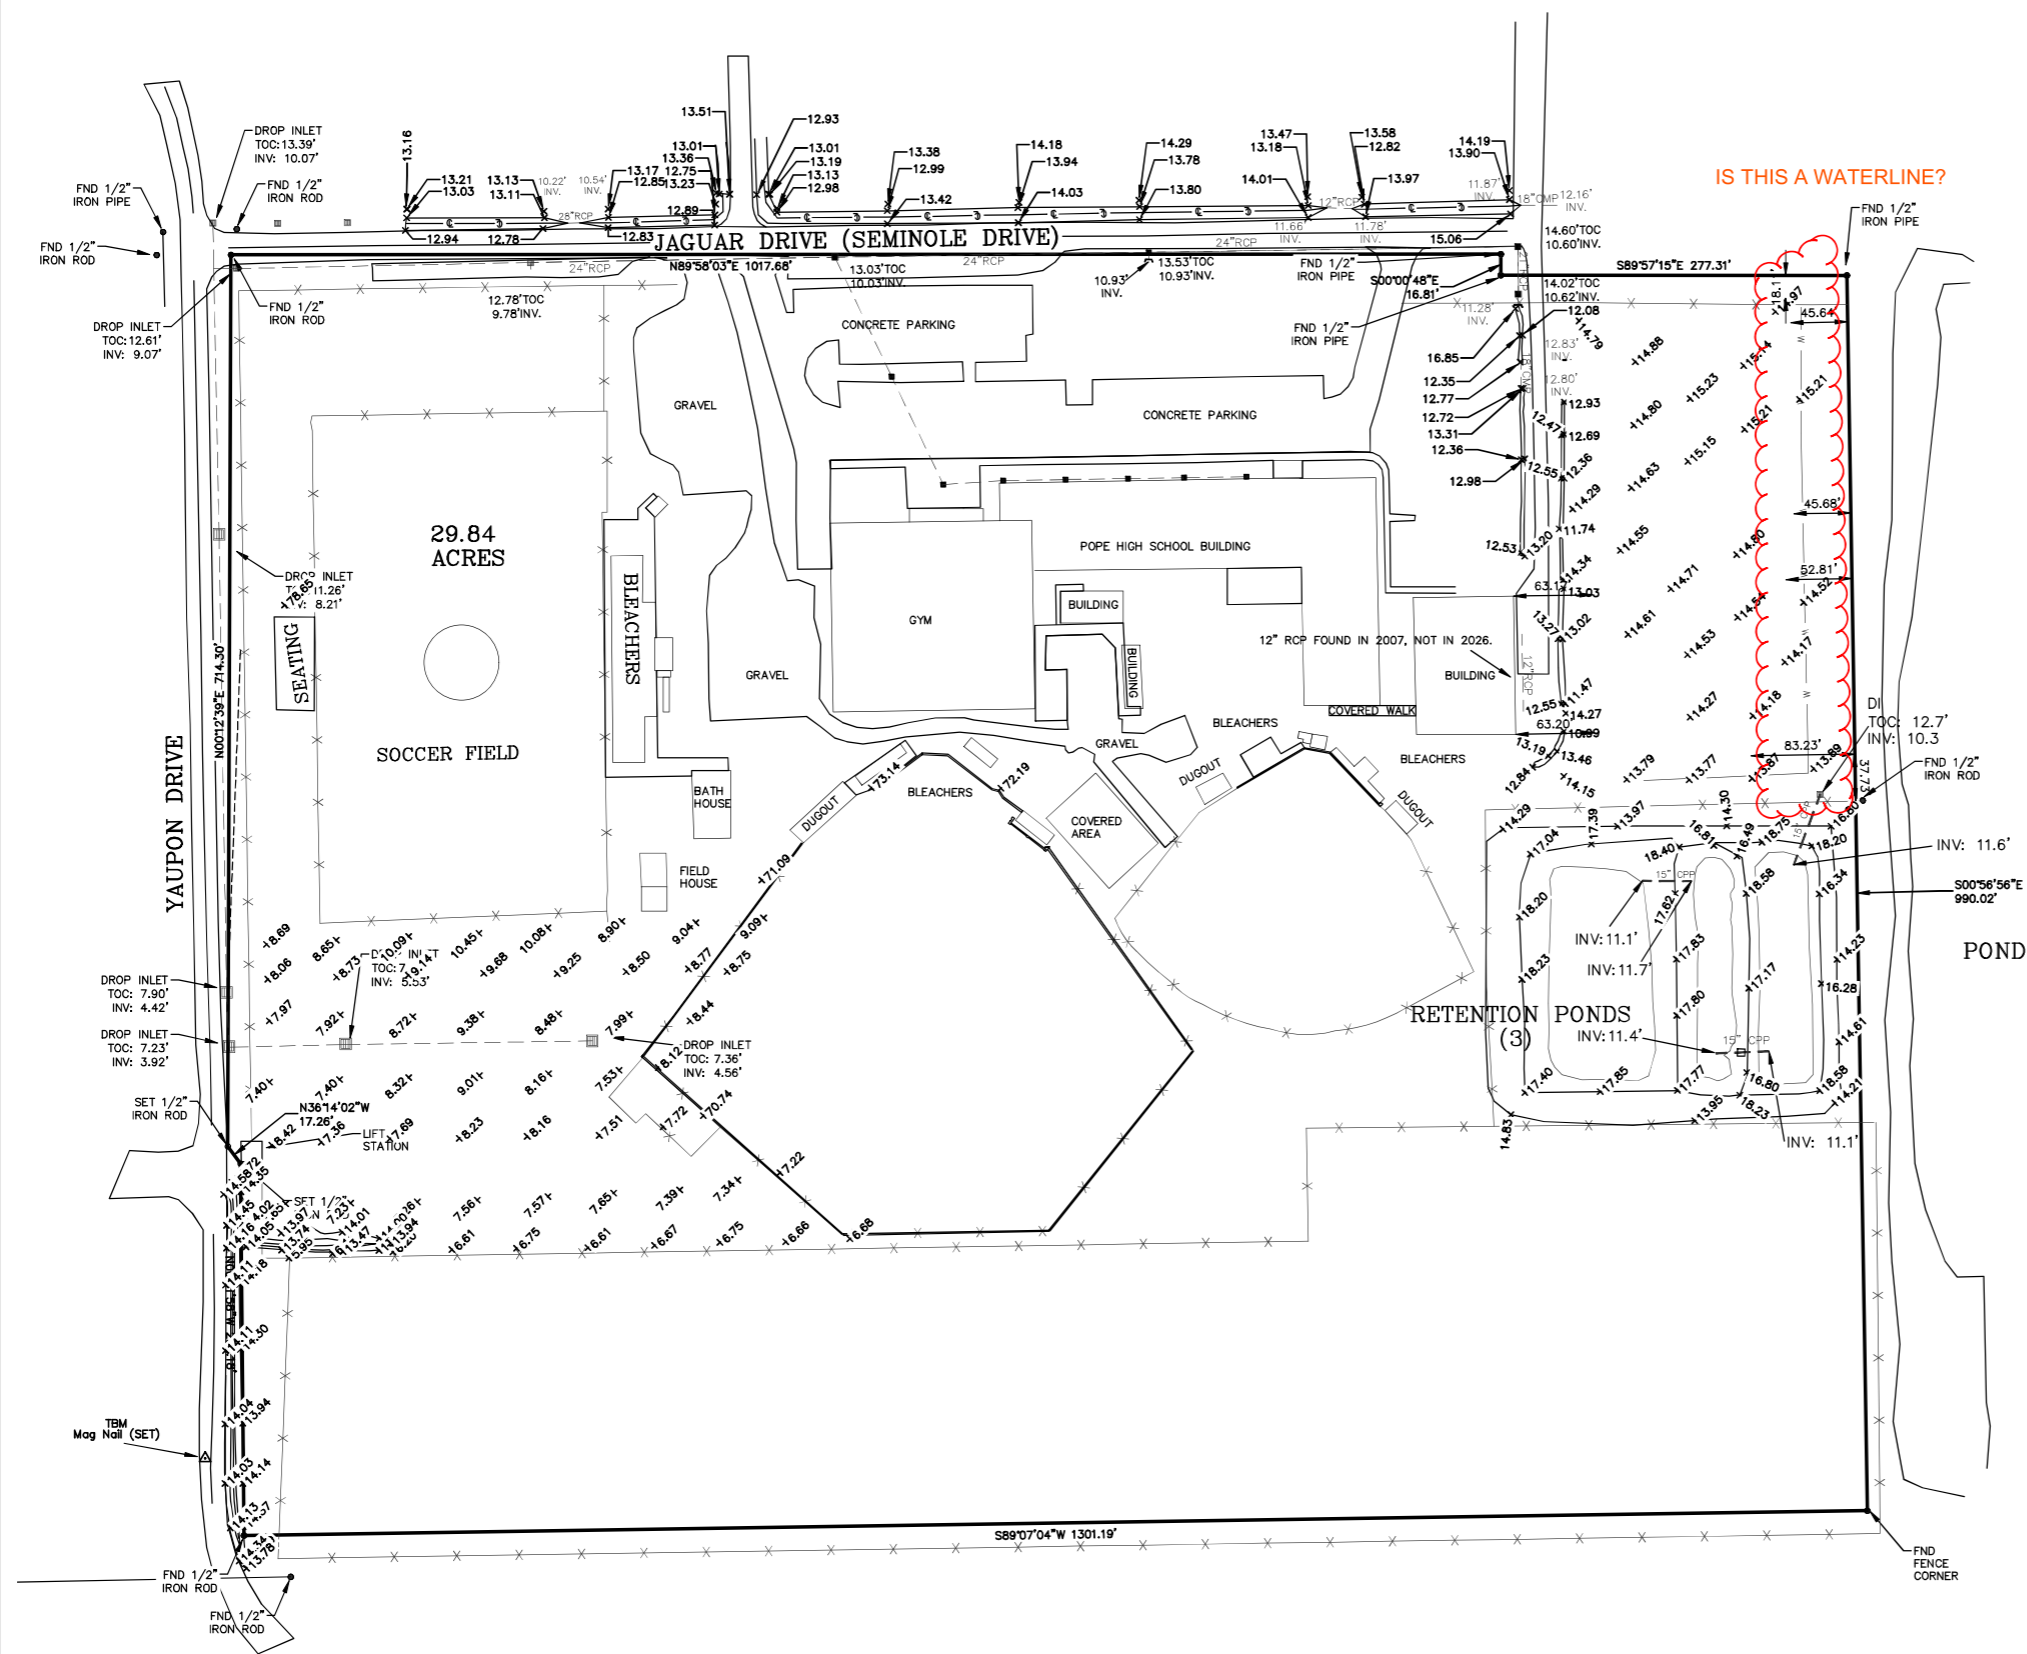

VICINITY MAP NOT TO SCALE

GENERAL NOTES: THE LOCATIONS OF UNDERGROUND UTILITIES AS SHOWN HEREON ARE BASED ON ABOVEGROUND STRUCTURES AND RECORD DRAWINGS PROVIDED THE SURVEYOR...

LEGEND table listing symbols for sewer manhole, water manhole, gas manhole, tele. manhole, drain manhole, drain inlet, power pole, elec. tower, catch basin, light standard, traffic light, etc.

2026 ELEVATION DATA



J.V. Burkes & Associates, Inc. SURVEYING ENGINEERING • ENVIRONMENTAL 1805 Shortcut Highway Slidell, Louisiana 70458

A PARTIAL TOPOGRAPHIC SURVEY PLAT OF A 29.84 ACRE PARCEL, AKA POPE JOHN PAUL HIGH SCHOOL, IN THE CITY OF SLIDELL, GLD IN ST. TAMMANY PARISH, LOUISIANA

Scale: 1" = 100', Date: 11/07/2024, Drawn by: MAC/GDB, Checked by: JDL, DWG. NO.: 20240390, SHEET 1 OF 1