


HERMAN & KITTLE
PROPERTIES, INC.
500 East 96th Street, Suite 300
Indianapolis, IN 46240
317.846.3111
www.hermankittle.com

COPYRIGHT & OWNERSHIP OF DOCUMENTS
THIS DOCUMENT IS THE PROPERTY OF HERMAN & KITTLE PROPERTIES, INC. AND IS TO BE USED ONLY FOR THE PROJECT AND SITE SPECIFICALLY IDENTIFIED HEREON. IT IS NOT TO BE REPRODUCED, COPIED, OR TRANSMITTED IN ANY FORM OR BY ANY MEANS, ELECTRONIC OR MECHANICAL, INCLUDING PHOTOCOPYING, RECORDING, OR BY ANY INFORMATION STORAGE AND RETRIEVAL SYSTEM, WITHOUT THE WRITTEN PERMISSION OF HERMAN & KITTLE PROPERTIES, INC. ANY UNAUTHORIZED USE OF THIS DOCUMENT IS PROHIBITED AND WILL BE CONSIDERED A VIOLATION OF THE COPYRIGHT LAWS OF THE UNITED STATES OF AMERICA. HERMAN & KITTLE PROPERTIES, INC. IS NOT RESPONSIBLE FOR ANY ERRORS OR OMISSIONS IN THIS DOCUMENT. THE USER OF THIS DOCUMENT SHALL BE RESPONSIBLE FOR OBTAINING ALL NECESSARY PERMITS AND APPROVALS FROM THE APPROPRIATE AGENCIES. HERMAN & KITTLE PROPERTIES, INC. IS NOT A PROFESSIONAL ENGINEER OR ARCHITECT. ANY USE OF THIS DOCUMENT FOR SUCH PURPOSES IS PROHIBITED. HERMAN & KITTLE PROPERTIES, INC. IS NOT RESPONSIBLE FOR ANY CONSTRUCTION DEFECTS OR DAMAGES TO PERSONS OR PROPERTY. HERMAN & KITTLE PROPERTIES, INC. IS NOT RESPONSIBLE FOR ANY DELAYS OR INCOMPLETION OF THE PROJECT. HERMAN & KITTLE PROPERTIES, INC. IS NOT RESPONSIBLE FOR ANY CHANGES TO THE PROJECT. HERMAN & KITTLE PROPERTIES, INC. IS NOT RESPONSIBLE FOR ANY COSTS OR FEES INCURRED BY THE USER OF THIS DOCUMENT. HERMAN & KITTLE PROPERTIES, INC. IS NOT RESPONSIBLE FOR ANY LITIGATION OR DAMAGES INCURRED BY THE USER OF THIS DOCUMENT. HERMAN & KITTLE PROPERTIES, INC. IS NOT RESPONSIBLE FOR ANY OTHER MATTERS NOT SPECIFICALLY IDENTIFIED HEREON.

SEAL

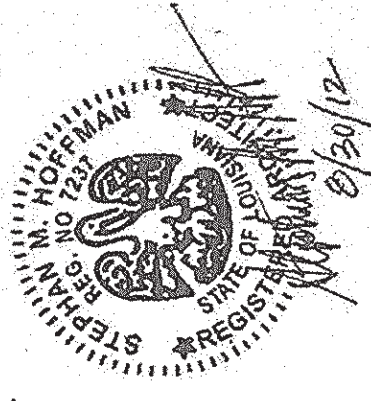

PROJECT TITLE

CANTERBURY HOUSE
APARTMENTS
SPARTAN DRIVE
SLIDELL, LOUISIANA

PHASE 2

4.71/2
+ 5.7/2
7.12
8.0
4.71/2
3.7
1.14/2
8.71/2

SHEET TITLE

BUILDING
NUMBER 8
FLOOR PLANS

ISSUED FOR: DATE
ISSUED FOR CONSTRUCTION 08-30-2012

REVISIONS
MARK DESCRIPTION DATE

DO NOT SCALE PRINTS - USE
FIGURED DIMENSIONS ONLY
JOB NO. 08-000



08-000

DATE: 08/14/12
SHEET NO.: 361

A-107

1 BLDG. NO. 8 FIRST FLOOR PLAN
A-107 SCALE: 3/32" = 1'-0"

2 BLDG. NO. 8 SECOND FLOOR PLAN
A-107 SCALE: 3/32" = 1'-0"

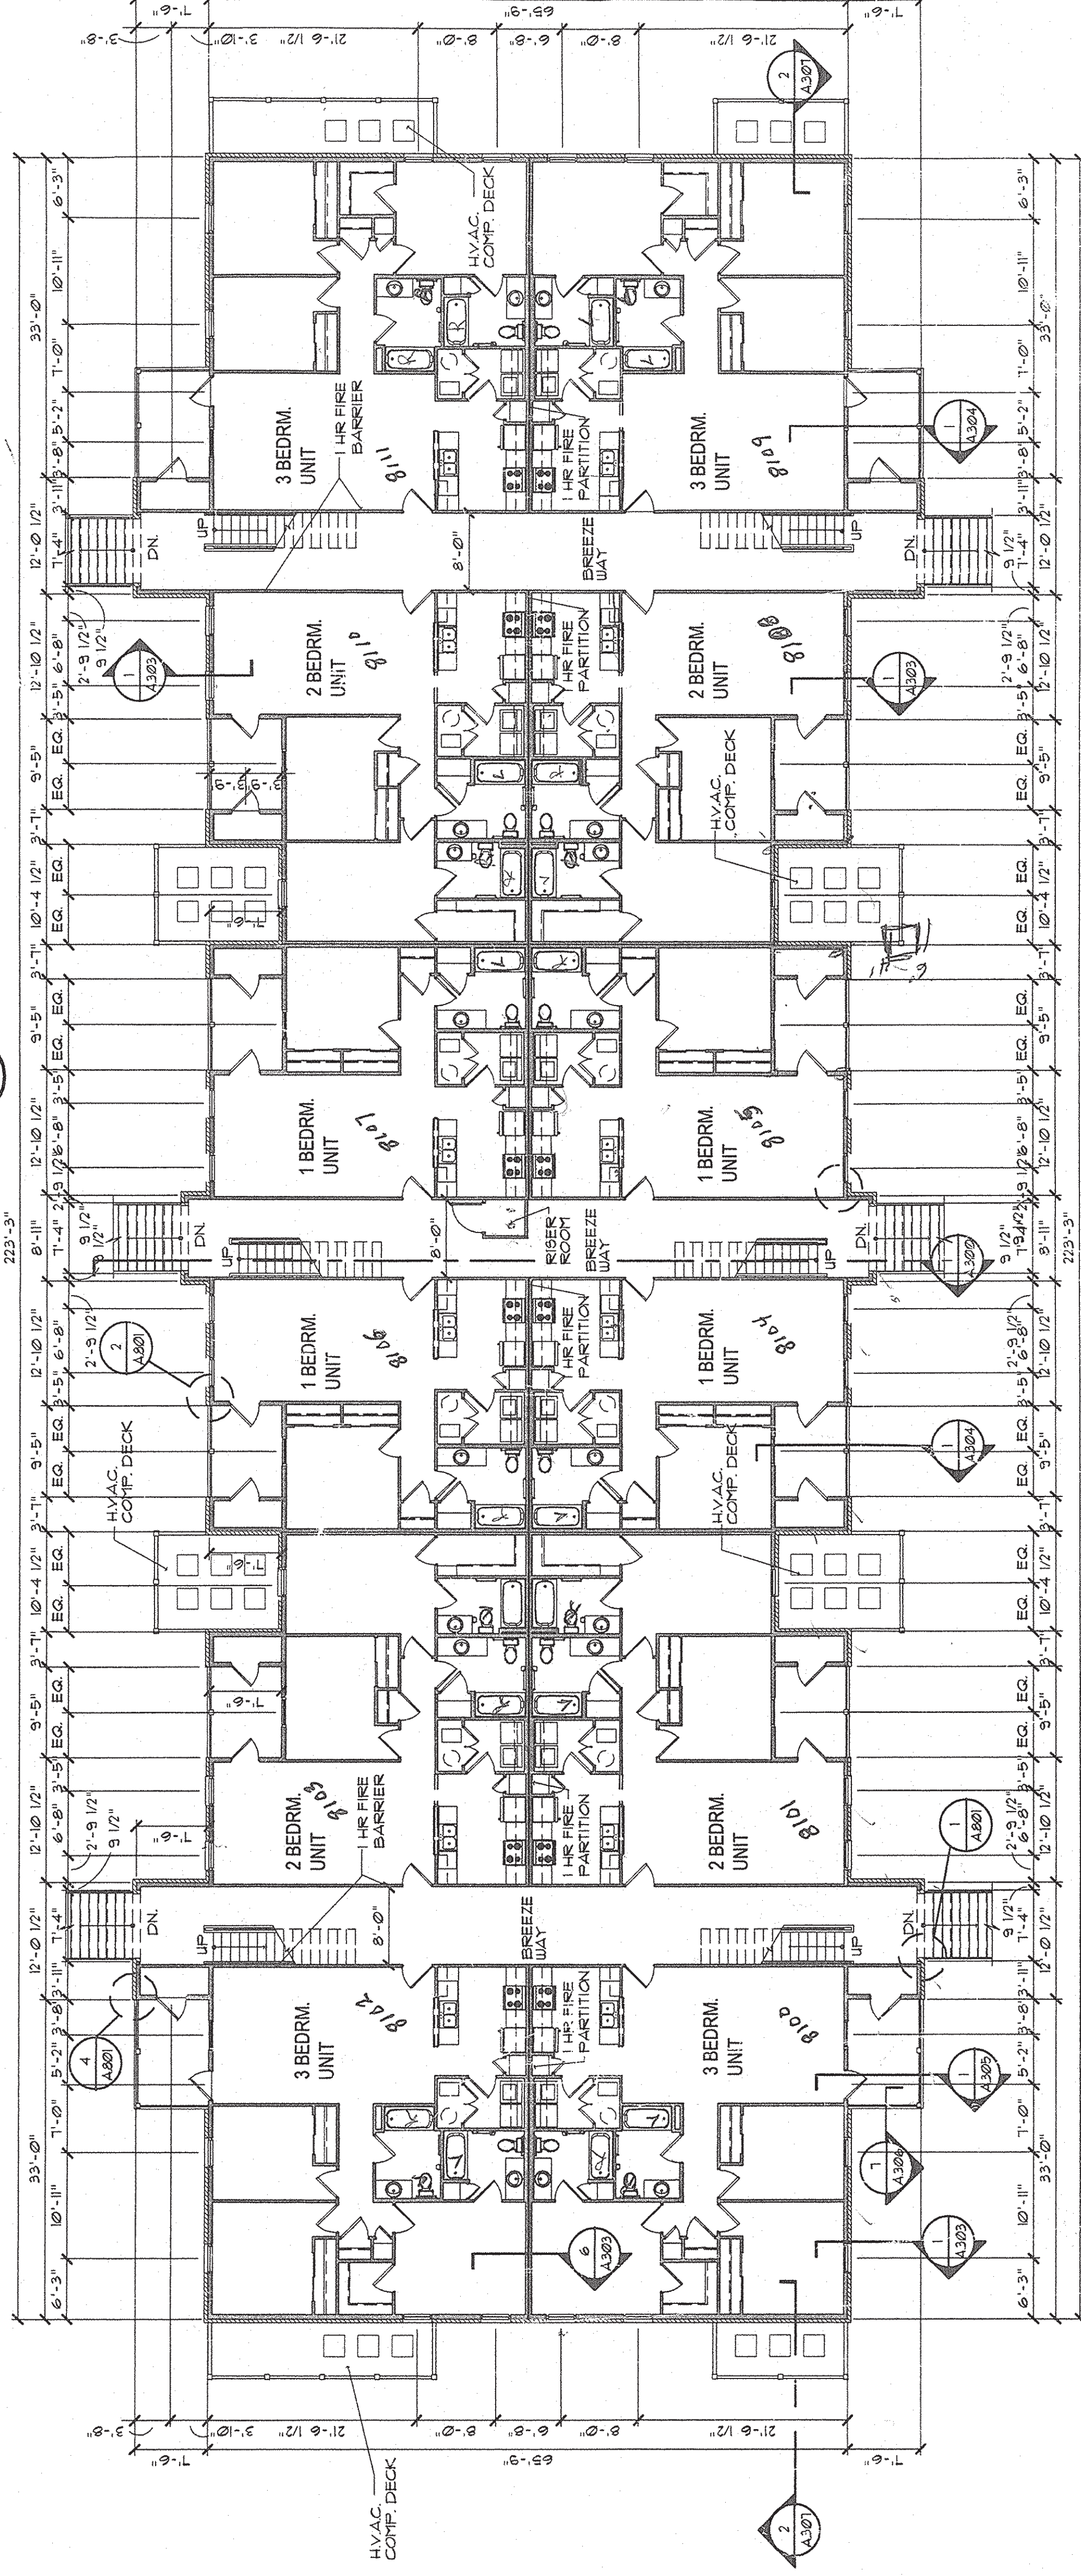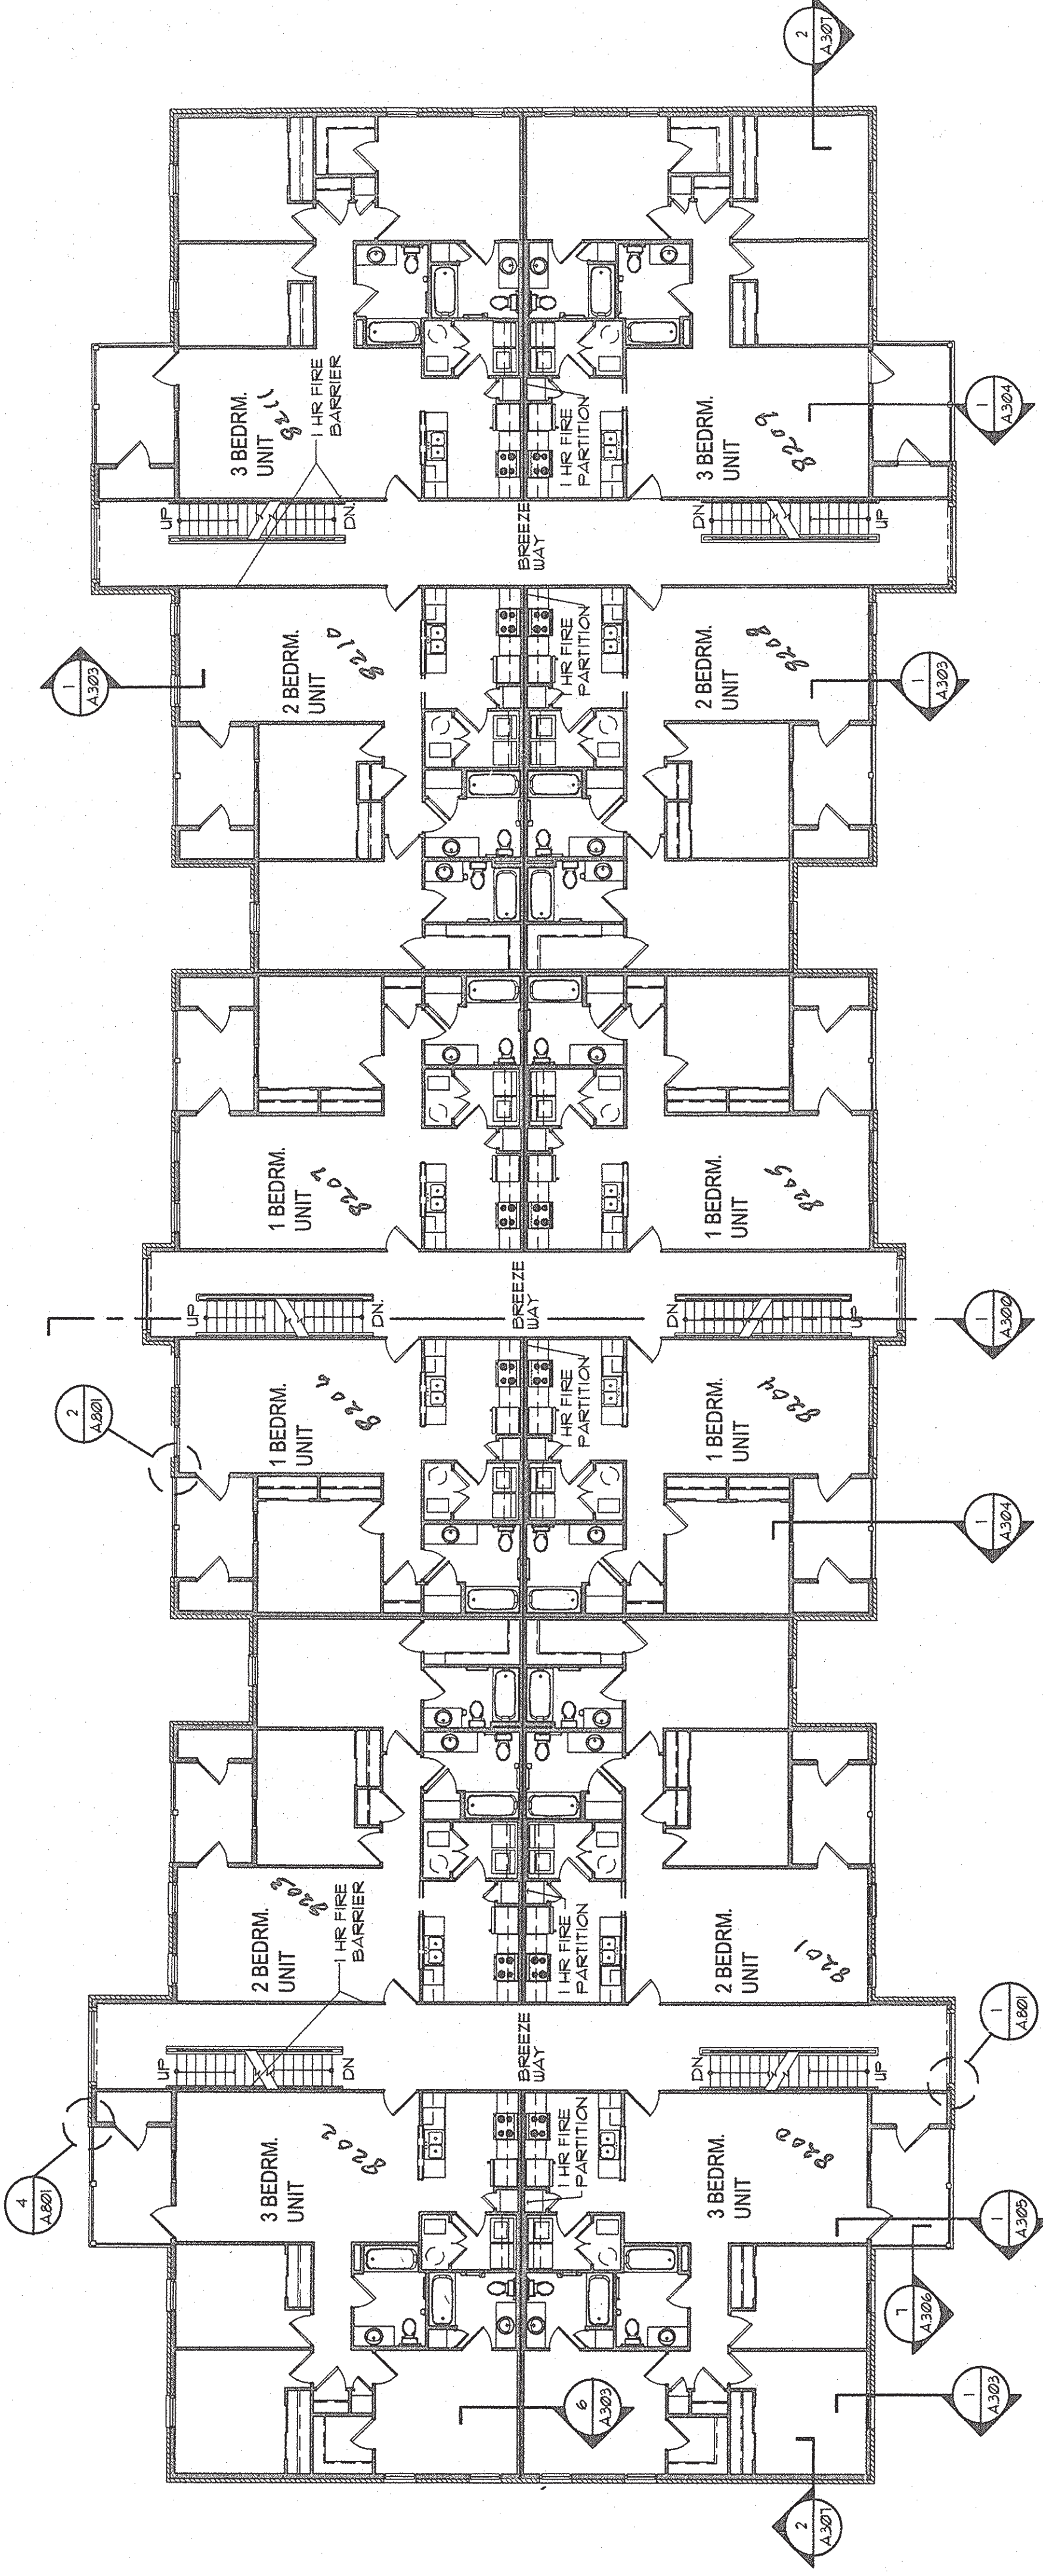

00