



**SPRINKLER PLAN**  
SCALE: 1/8"=1'-0"

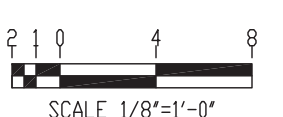


**HANGER NOTES:**

- STEEL PIPE:**
- HANGER SUPPORTING END SPRINKLER SHALL PREVENT UPWARD MOVEMENT.
  - 24" MAX. UNSUPPORTED ARMOVER
  - MAX. DISTANCE FROM END SPKR.  
 1" 36"  
 1 1/4" 48"  
 1 1/2" 60"

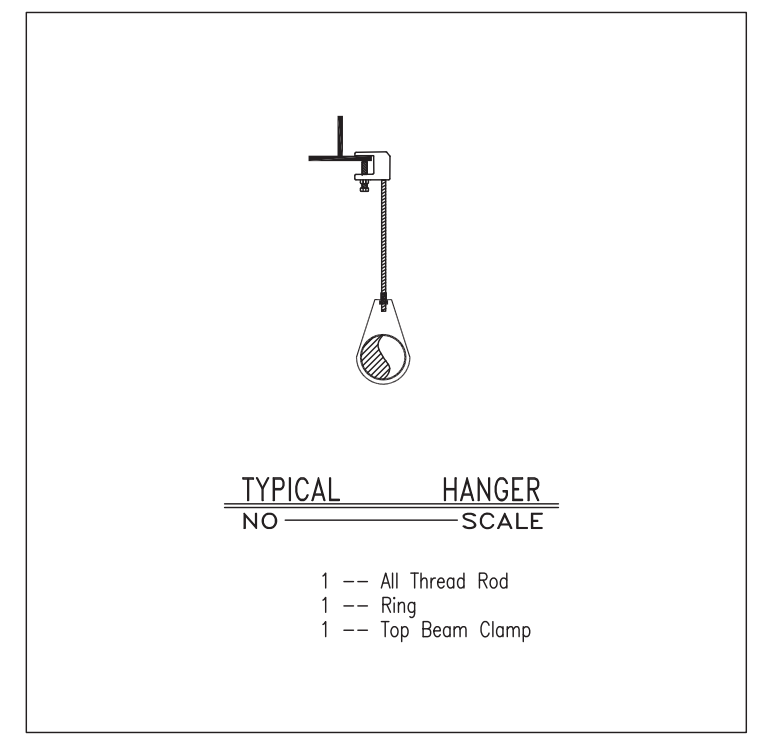


**MAXIMUM HANGER SPACING:**

SIZE	SPACING
1"	12'-0"
1 1/4"	12'-0"
1 1/2"	15'-0"
2"	15'-0"

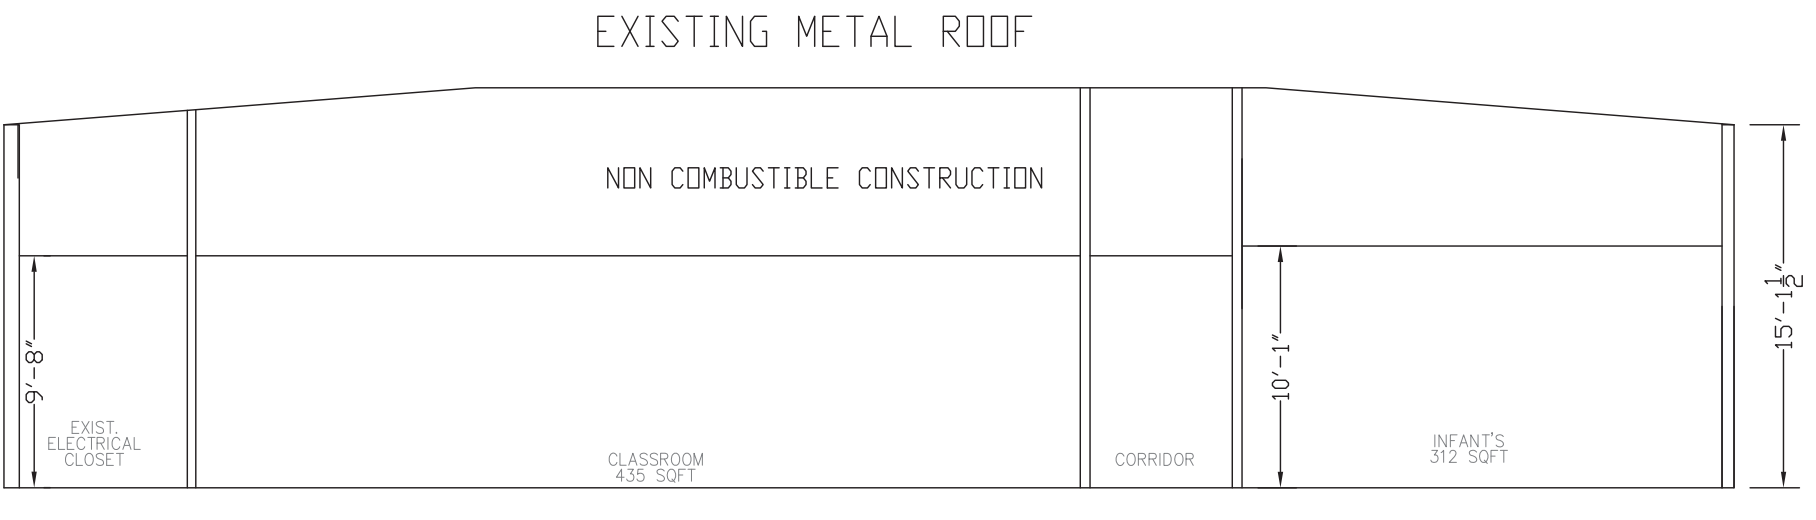

**SECTION A**  
SCALE: 1/8"=1'-0"

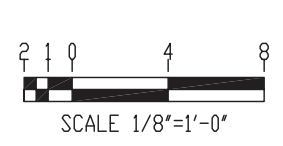

4" UNGD C900(DR18)  
+/- 3' BURY

4

160-0

4" WATTS 757DCDA

EXISTING 6" CITY CIRC MAIN

VICTAULIC FLEXIBLE HOSE CONNECTIONS AH2  
3/4" X 48"

WITH VICTAULIC STYLE AB2 BRACKETS

VICTAULIC FLEXIBLE HOSE CONNECTIONS AH2  
1/2" X 48"

WITH VICTAULIC STYLE AB2 BRACKETS

FLOW TEST DATA  
BY: JEFFERSON SPRINKLER, INC  
DATE: JANUARY 15, 2026  
TIME: 9:10 AM  
STATIC: 62 PSI  
RESIDUAL: 57 PSI  
FLOW: 950 GPM  
**ELEVATION OF TEST HYDRANT: 1'-0" AFF**

NOTE:  
SITE PLAN IS SHOWN FOR HYDRAULIC REFERENCE ONLY  
NOT TO BE USED FOR INSTALLATION OR CODE REVIEW.

HYDRAULIC - SYSTEM	
This Building is Protected by a Hydraulically Designed Automatic Sprinkler System	
Location	CLASSROOMS
No. of Sprinklers	64
Basis of Design	
1. Density	.10/ 1238 SF
2. Designed Area of Discharge	7 SPRINKLERS
System Demand	
1. Water Flow Rate	377.808 GPM
2. Residual at the Base of Riser	51.811 PSI
3. Hose Stream Allowance	100 GPM
4. Occupancy Classification	LIGHT HAZARD
5. Commodity Classification	-
6. Maximum Storage Height	-

**SHOP DRAWING / SUBMITTAL REVIEW**


APPROVED  REVIEWED AS NOTED   
 REVISE AND RESUBMIT  REJECTED

Project No. 3 peas Submittal No. \_\_\_\_\_

Corrections or comments made on the shop drawings during this review do not relieve the contractor from compliance with requirements of the drawings and specifications. This check is only for review of the general conformance with the design concept of the project and general compliance with the information given in the contract documents. This contractor is responsible for: conforming and correlating all quantities and dimensions; selecting fabrication processes and techniques of construction; coordinating his or her work with that of other trades and performing all in a safe and satisfactory manner.

By: Chuck Dammon Date: 01-03-26  
**DAMMON ENGINEERING, INC.**  
 Slidell, LA

- RISER LEGEND**
- 4" SUPPLY LINE
  - 4" BUTTERFLY VALVE
  - 4" AGF ULTIMATE RISER
  - MAIN DRAIN
  - 4" TO SPRINKLER SYSTEM
  - TO INSPECTORS TEST CONNECTION
  - TO FDC & 2 1/2" HOSE VALVE TO TEST BACKFLOW PREVENTER


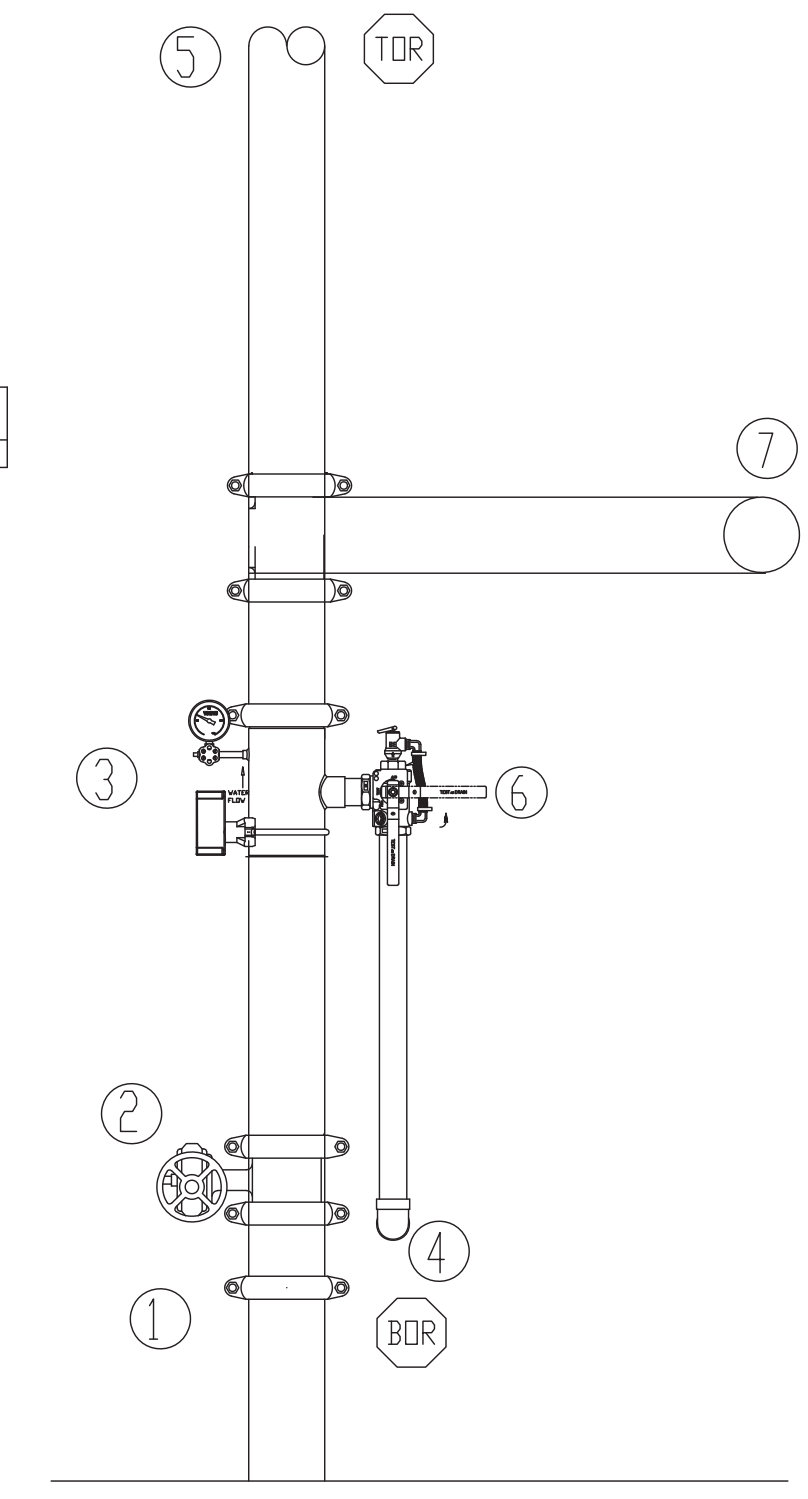


**RISER DETAIL**

**NOTES:**

- ELECTRIC BELL SHALL BE PROVIDED AS AN AUDIBLE ALARM
- RISER ROOM TO BE HEATED (BY OTHERS)

- GENERAL NOTES**
- Jefferson Sprinkler, Inc has a contract with KB Kaufmann to provide a new wet sprinkler system at Three Peas in a Pod Learning Center.
  - The occupancy of the building is Institutional, 7503 sf.
  - The sprinkler system is designed in accordance with NFPA 13, 2016 Edition.
  - It is the building owners responsibility to provide adequate heat for all areas in the building protected by wet sprinkler systems and for all water filled supply pipes, valves and system risers in all dry pipe sprinkler systems.
  - All new piping is to be hydrostatically tested at not less than 200 psi for 2 hours, or at 50 psi in excess of the maximum pressure, NFPA 13, maximum pressure to be maintained is in excess of 150 psi.
  - Whether or not indicated on drawings, the following items are to be provided:
    - Spare head cabinet with wrench (NFPA 13)
    - Provisions for flushing connections and draining of all pipe.
    - Inspectors test connection shall be provided for each system
    - Water flow on all wet systems and zones.
    - 2) For wet pipe systems (see NFPA 13)
    - Tamper switches on all indicating control valves.
    - Monitoring of all signal devices by approved means.
    - Air vent.
  - All pipe 1" and smaller shall be schedule 40 steel with cast iron screwed or malleable fittings.
  - All pipe 1 1/4" - 4" shall be schedule 10 steel with grooved couplings and grooved mechanical fittings or equivalent, with welded branch outlets.
  - All sprinklers are listed quick response unless noted otherwise.
  - All hangers are to be field located for compliance with NFPA 13.
  - All devices are to be listed or approved for use in fire protection systems.
  - Building is a conditioned space that will be maintained at 40F or above.
  - Light hazard occupancy, except Jan Closets, Closets, Mechanical and Electrical rooms.
  - Ceiling height is 9'-8" UNG.
  - Air relief valve shall be installed.

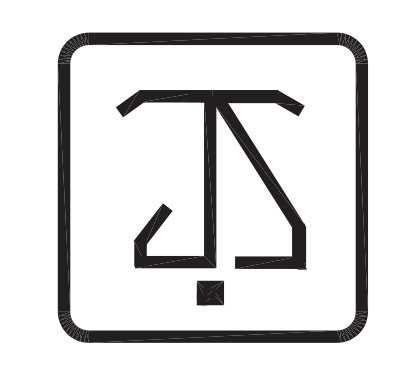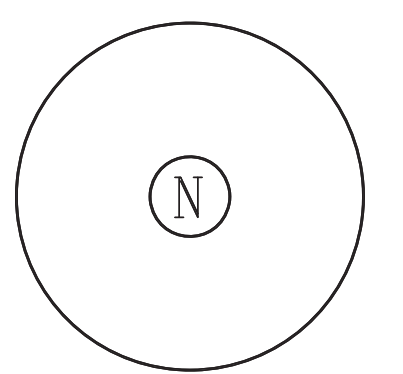

**JEFFERSON SPRINKLER, INC.**  
 "Fire Protection Specialist"

1903 Hancock St. P.O. Box 129 Gretna, La. 70053  
 Phone 504-393-7699 Fax 504-367-0216

- General Notes**
- All Pipe Locations are to be Field Measured Prior to Fabrication and Installation by Sprinkler Contractor.
  - All Dimensions Shown are Center to Center.
  - High Temperature Heads are to be Field Located Where Required.
  - All Pipes and Hangers are to be Installed per NFPA #13.
  - Hangers are to be U.L. Listed and F.M. Approved.

Symbols		Number of Sprinklers	
Symbol	Description	Total This Sheet	Total This Job
○	Hydraulic Reference Points	64	64
[18 m]	Elev. Below Top of Steel	26 (1/2"x5.6175F) VIKING VK3021 QR PD WH	
[+4]	Elev. Above Finished Floor	38 (1/2"x5.6175F) VIKING VK3021 QR PD WH	
+ (TS 20-0)	Elev. of Top of Steel	38 (1/2"x5.6175F) VIKING VK3021 QR PD WH	
⊕	Ceiling Height		
⊖	Denotes Hanger Location		
○	Rise up or down		

Drawing SPRINKLER PLAN	
Contract No.	20312
Revisions:	
Drawn By	S. ENCLADE
Scale	1/8"=1'-0"
Date	2/3/26
Approval By	SFM

Job: THREE PEAS IN A POD EARLY LEARNING CTR  
 2965 GAUSE BLVD  
 SLIDELL, LA 70461

Contractor:  
 KB KAUFMANN  
 3173 E TERRACE AVENUE  
 SLIDELL, LA 70458