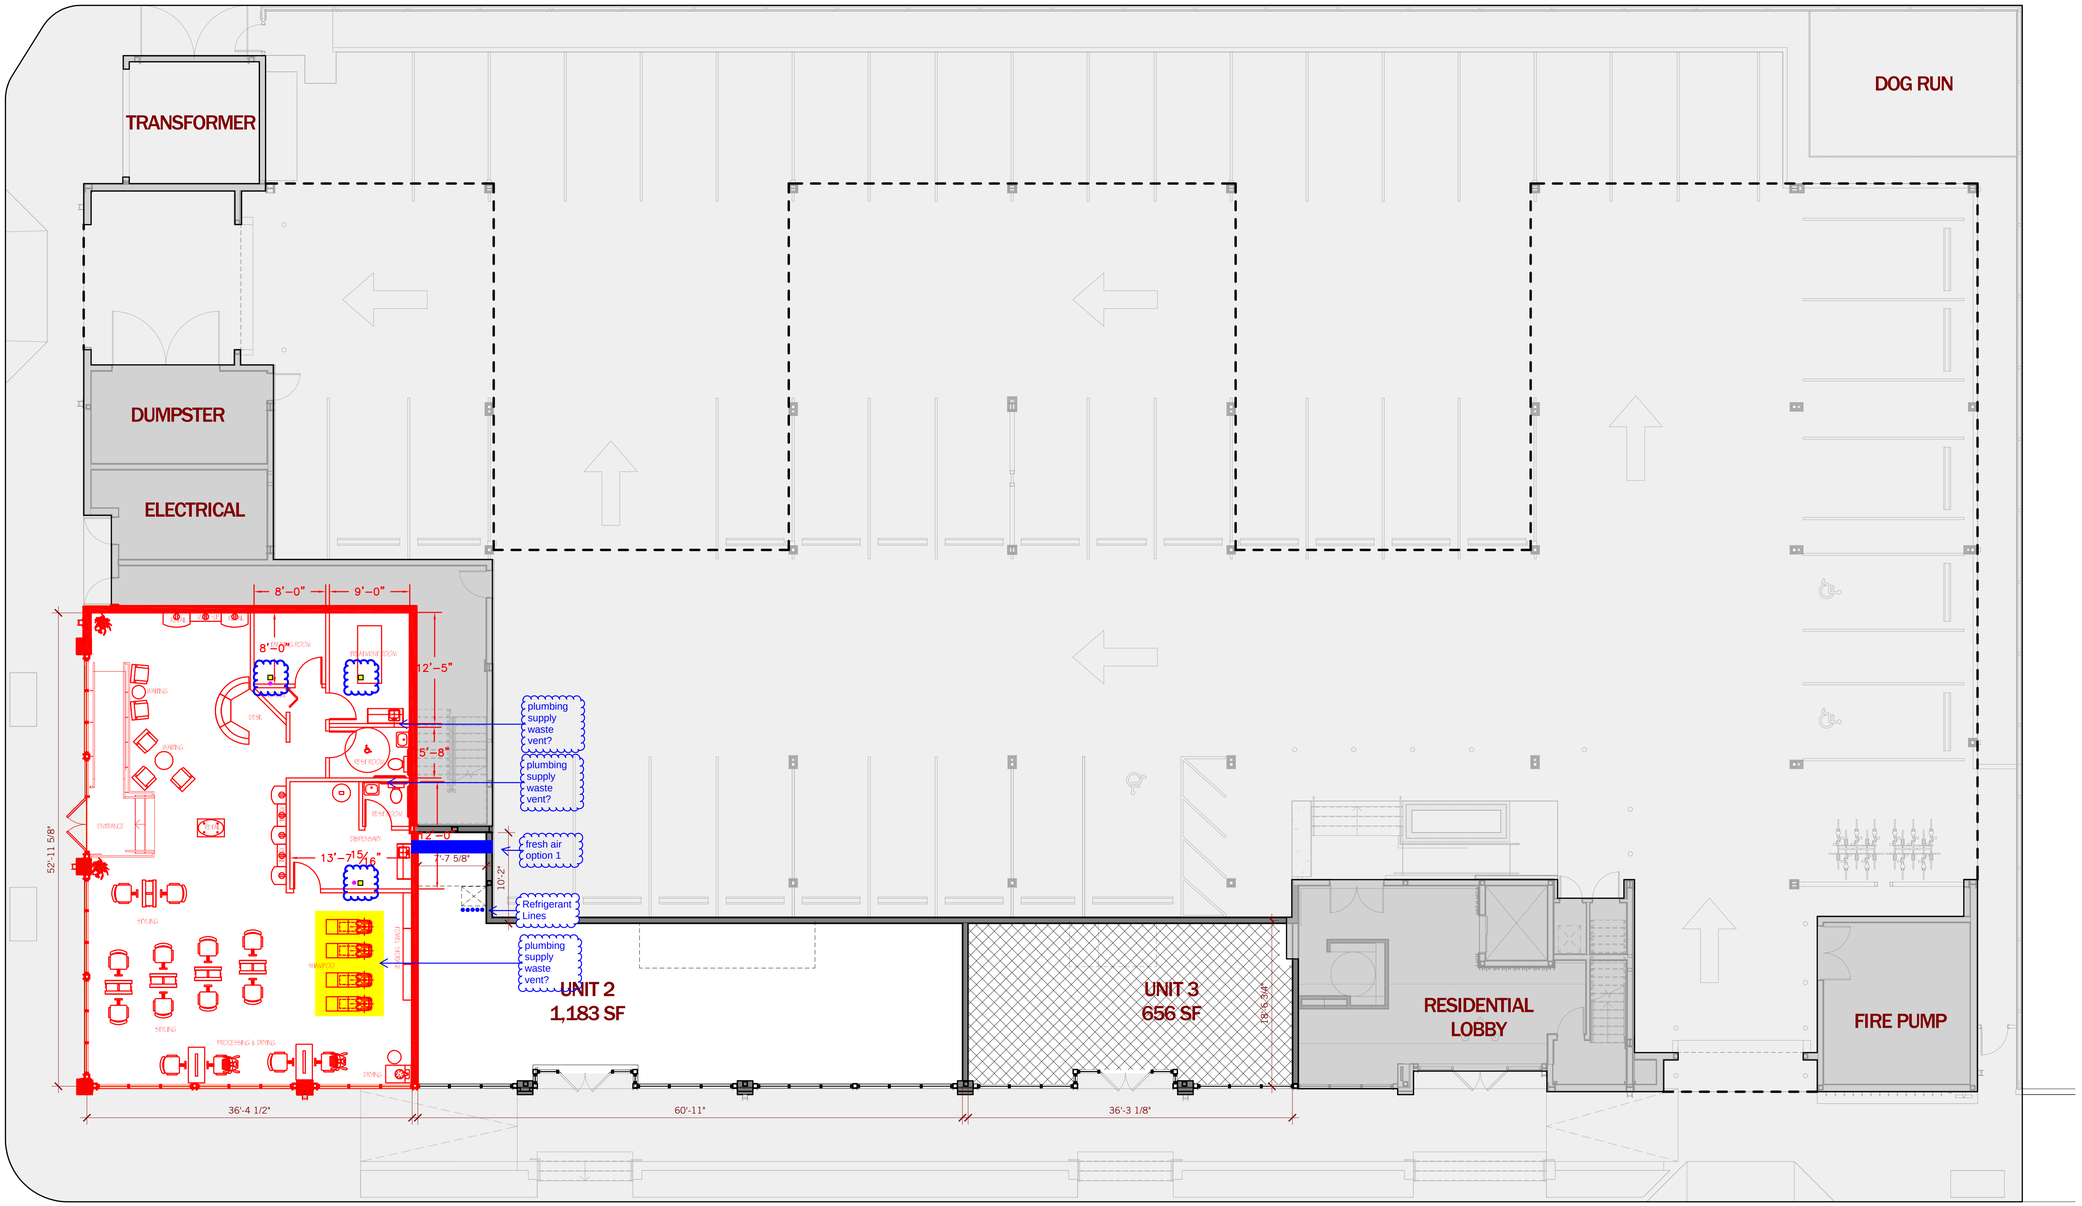

1 RETAIL - MULTI TENANT
R-3 scale: 1/8" = 1'-0"

STUDIO WTA
architecture + planning + interiors
1119 Tchoupitoulas Street
New Orleans, LA 70130
504.593.9004
www.studiowta.com

1581 MAGAZINE STREET
New Orleans, Louisiana 70130

Date:
Issue Purpose:
Revisions:

RETAIL - MULTI TENANT

11/24/15

R-3

© 2016 studioWTA