



#1127

FKSI DISTRICT
New Orleans

DAVID DAMMON
Tues 9am
CARONDELET ST. SIDE

POYDRAS ST. SIDE

LAFAYETTE ST.

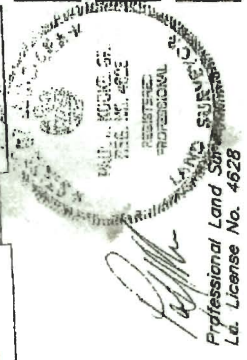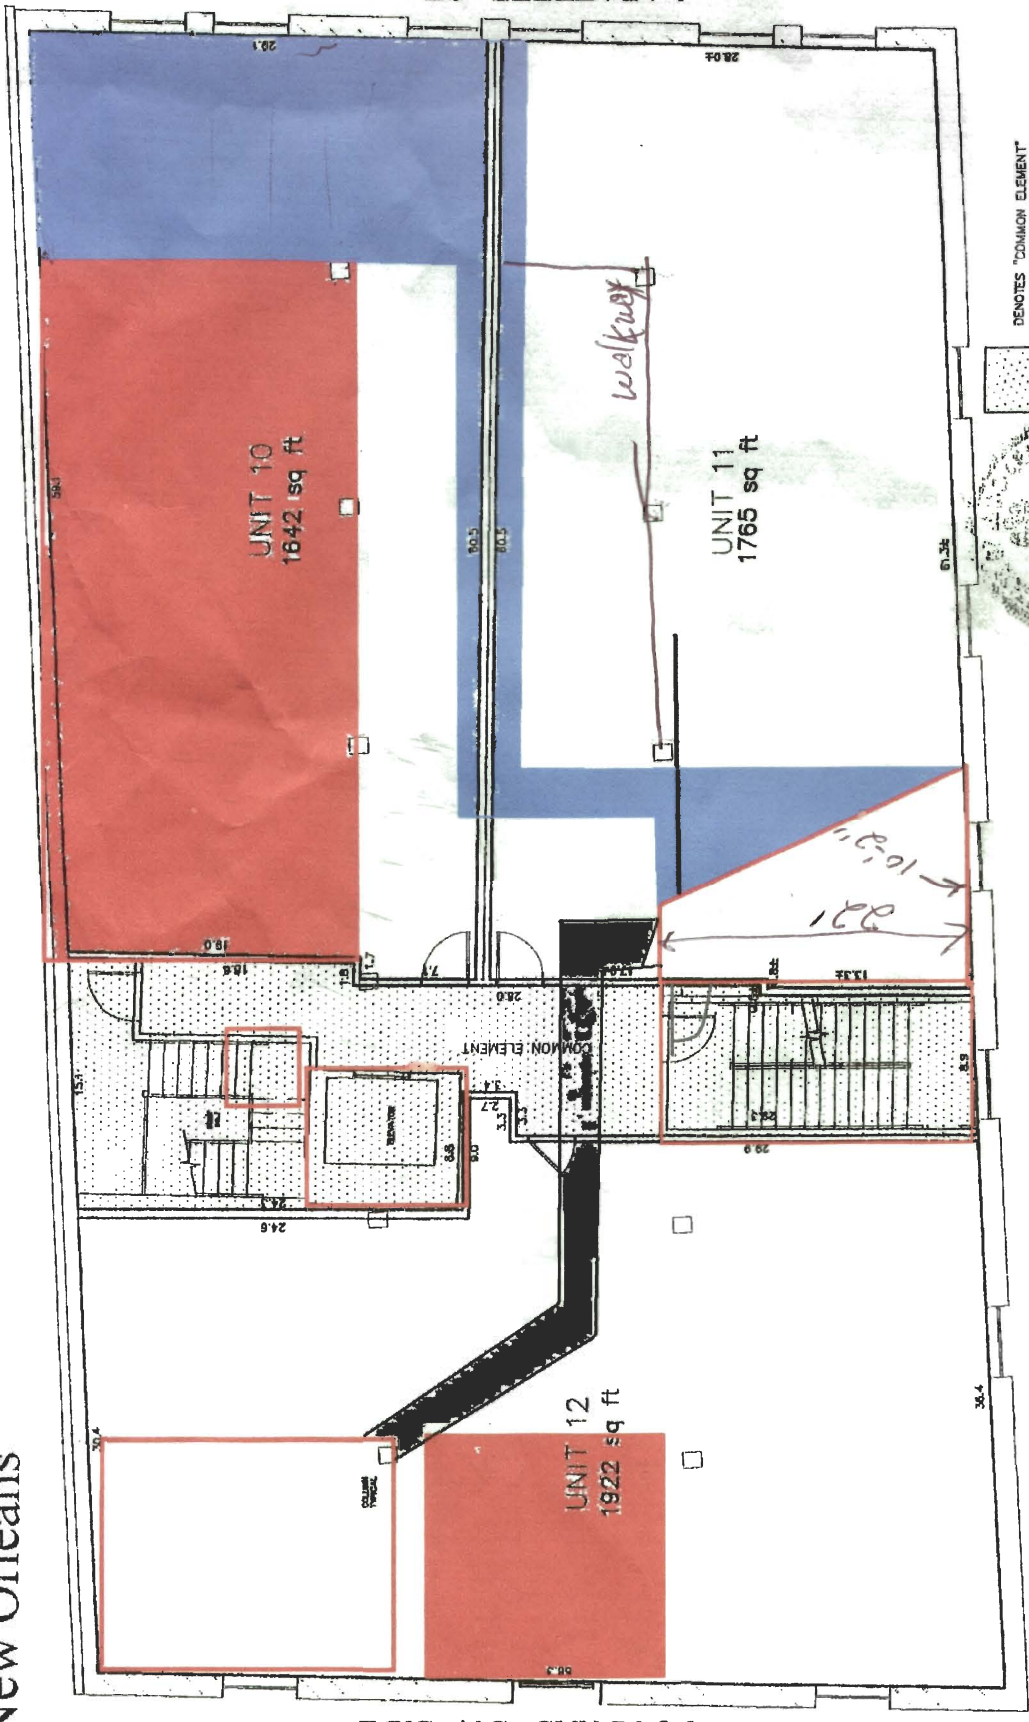

DENOTES "COMMON ELEMENT"
 DENOTES "SPECIAL LIMITED COMMON ELEMENT"
 DENOTES "LIMITED COMMON ELEMENT"

BARONNE ST. SIDE

Elevations shown hereon are based on
NGS Benchmark C-149 Elev. 9.39 NAVD'88.

FIFTH FLOOR
ELEV. 57.0

SCALE 1"=8'

825 LAFAYETTE
CONDOMINIUMS

May 19, 20
SHEET 5 OF 5
570-3431
LAFAYETTE ST.
NEW ORLEANS, LA 70112

628-0463