
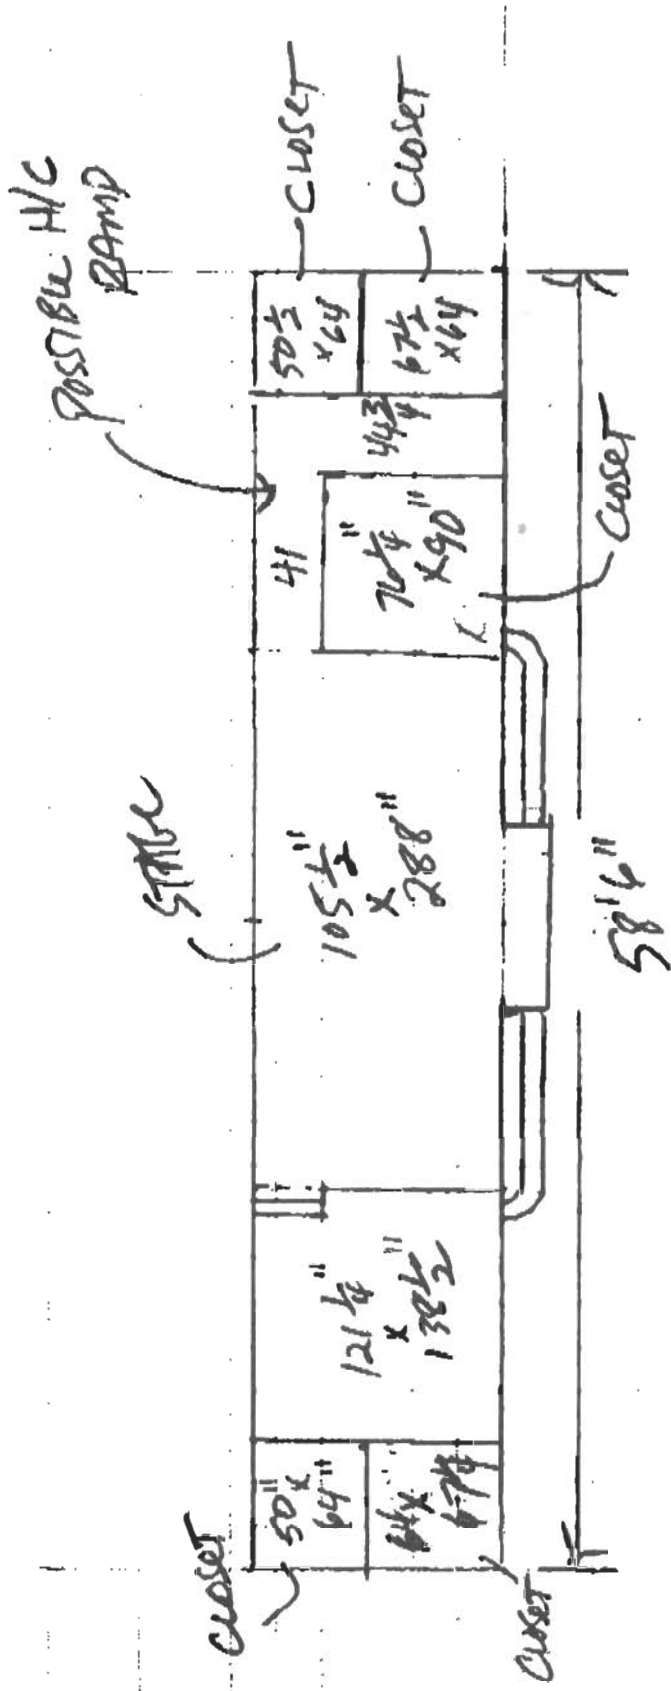


2nd Floor Section

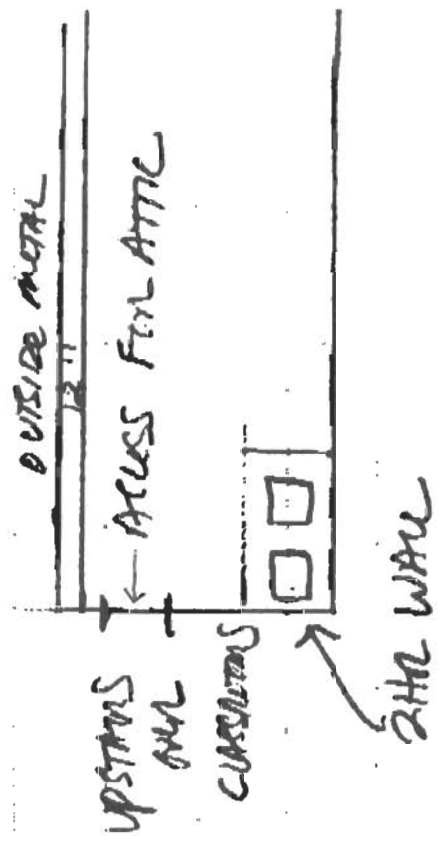

New 1st Floor PLAN FOR SANCTUARY