



240.00'
 COPY OF SURVEY
 SCALE: 1"=10'

GUZMAN STREET

432476
 REVIEWED FOR
 STATE FIRE MARSHAL
 AS PER REVIEW LETTER
 BY: WILLIAM D. JONES, ARCHITECT, CBO
William D. Jones

DAMMON
 ENGINEERING, INC.
 Architects & Engineers


dammonengineering.com
 dammoneng@bellsouth.net
 PHONE: 905-649-5032
 FAX: 905-641-5950

CHIEF ENGINEER: RIMMETT DAMMON, P.E.
 CHIEF ARCHITECT: KEVIN KINCHEN
 554 OLD SPANISH TRAIL
 SUIDELL, LA 70456

TABERNACLE BAPTIST CHURCH
 NEW FELLOWSHIP HALL
 2445 FOURTH STREET
 SUIDELL, LA 70456

JOB No: 2171 DATE: 04-30-2013
 DRAWN BY: JCT CHECKED BY: CD

#	DESCRIPTION	DATE

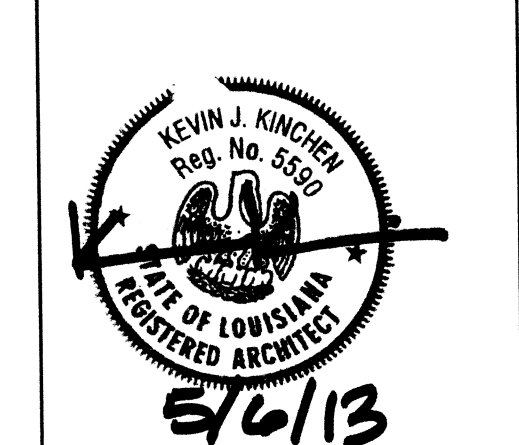

COPY OF SURVEY
 SHEET No: 3 OF 13
 C-1