




BUILDING SECTION D
SCALE 3/16" = 1"

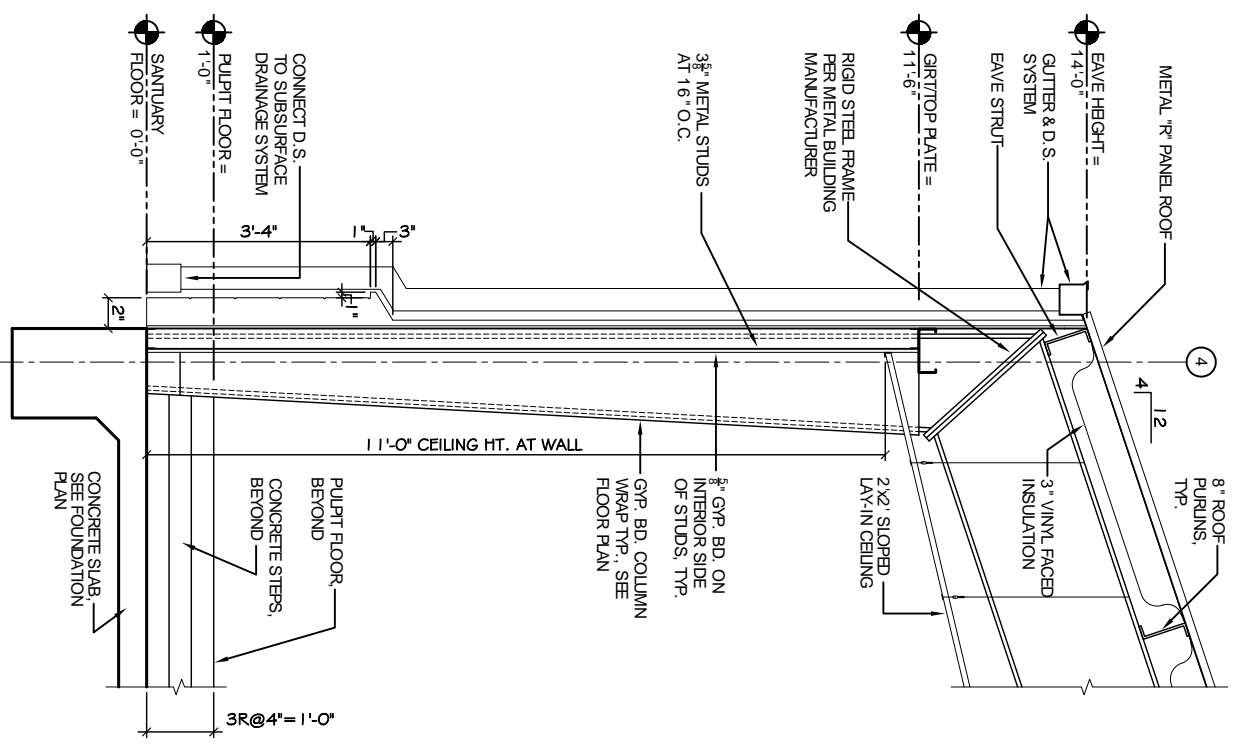


WALL SECTION G
SCALE 3/4" = 1"

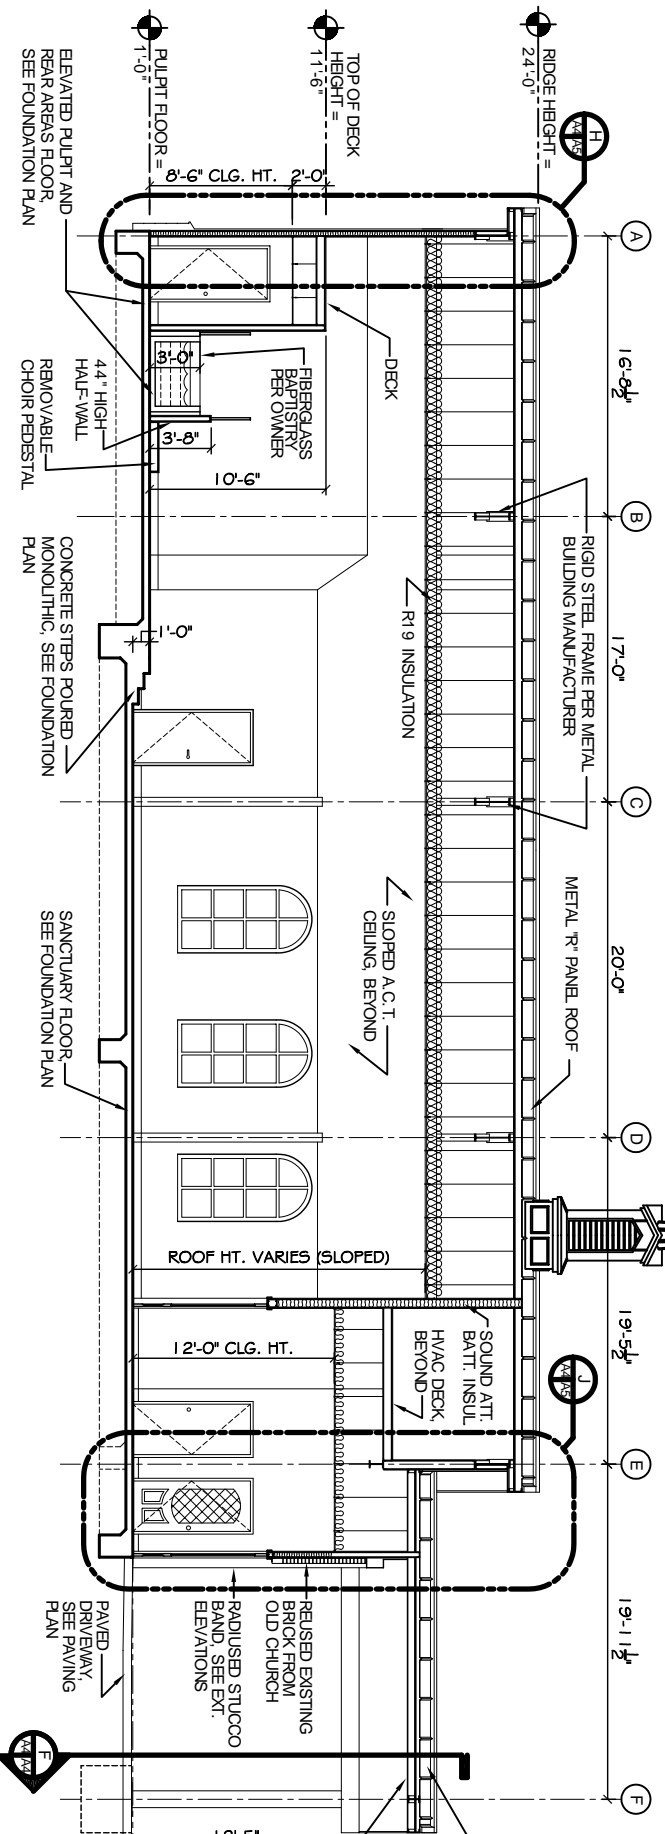

BUILDING SECTION E
SCALE 3/16" = 1"

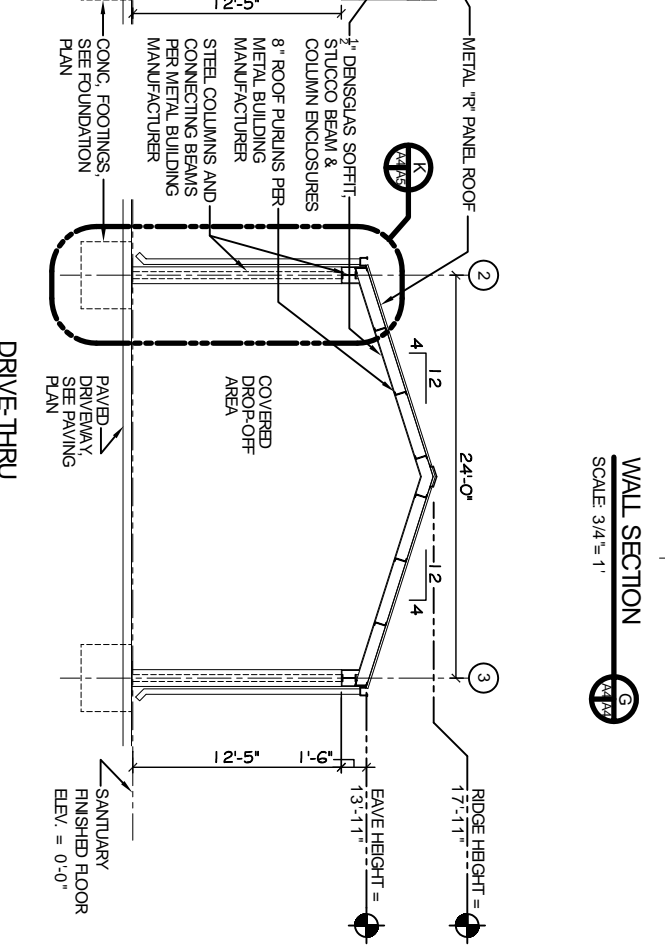

DRIVE-THRU CANOPY SECTION F
SCALE 3/16" = 1"

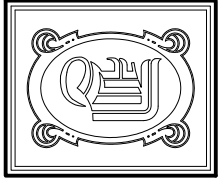

DAMMON
ENGINEERING, INC.

CHIEF ENGINEER
EMMETT DAMMON, P.E.

CHIEF ARCHITECT
ROBERT WILTSE

1095 FLORIDA AVENUE
SUDDLE, LA. 70459
OFFICE: 985-649-5832
FAX: 985-641-5950

WWW.DAMMONENGINEERING.COM
EMAIL: DAMMONENG@PELSOUTH.NET

ARCHITECTURE
ENGINEERING
STUDIES
PLANNING
INVESTIGATION
EXPERT WITNESS

NEW
CHURCH

TABERNACLE
BAPTIST
CHURCH

2445 FOURTH ST.
SUDDLE, LA

BUILDING
AND
WALL
SECTIONS

REV:
SCALE AS NOTED
JOB#: 2050
DATE: 2-8-10
SHEET 15

A-4