GENERAL NOTES:

1. CONTRACTOR SHALL EMPLOY A LICENSED SPRINKLER COMPANY AND FIRE ALARM COMPANY.
2. INSULATION AND INSULATION ASSEMBLIES SHALL MEET THE REQUIREMENTS OF SECTION 719, INTERNATIONAL BUILDING CODE, 2006.
   A. CONCEALED INSULATION SHALL HAVE A FLAME SPREAD INDEX OF NOT MORE THAN 25 AND A SMOKE DEVELOPED INDEX OF NOT MORE THAN 450.
   B. FACING SHALL COMPLY WITH IBC 719.2.1.
3. DIMENSIONS ARE TO CENTER LINE OR FACE OF STUDS, CENTER LINES OF COLUMNS.
4. CONTRACTOR TO VERIFY ALL SITE CONDITIONS AND ALL DIMENSIONS PRIOR TO CONSTRUCTION.
5. MATERIALS SHALL BE NEW AND U.L. LISTED.
6. NO WORK SHALL BE CONCEALED UNTIL APPROVED BY LOCAL INSPECTORS.
7. CONSTRUCTION SHALL COMPLY WITH ALL CITY, STATE AND LOCAL CODES.
8. CONTRACTOR TO GUARANTEE WORK FOR ONE YEAR.
9. CONTRACTOR SHALL FURNISH WATER AND POWER FROM EXISTING SOURCES.
10. PAINT GRADE TO BE SHERWIN–WILLIAMS OR EQUIVALENT. ALL WORK TO RECEIVE 2 COATS.
11. PROVIDE CLEANUP ON A REGULAR BASIS. NO TRASH STORED IN BUILDING.
12. ALL BATT INSULATION SHALL HAVE A CLASS "A" (0–25) FLAME SPREAD IN COMPLIANCE WITH APPLICABLE CODE.
13. USE 6" STUDS AT ALL PLUMBING WALLS.
14. PROVIDE GALV. METAL PAN WITH DRAIN AT WATER HEATER LOCATION.
15. LOCKS ON DOORS IN MEANS OF EGRESS SHALL NOT REQUIRE THE USE OF A KEY (INTERIOR SIDE), SPECIAL DEVICE OR SPECIAL KNOWLEDGE TO OPEN IN THE DIRECTION OF EGRESS. ALL DOORS SHALL HAVE LEVER TYPE HANDLES.
16. INTERIOR WALLS AND CEILINGS SHALL HAVE A FLAME SPREAD OF 0–25 AND A SMOKE DEVELOPMENT RATING OF 0–450.
17. ALL WORK SHALL COMPLY WITH THE LATEST EDITION OF ALL LOCAL, STATE AND NATIONAL CODES THAT COVER THE SECTION OF WORK BEING PERFORMED.
18. PROVIDE PORTABLE FIRE EXTINGUISHERS IN ACCORDANCE WITH NFPA 10. SEE APPENDIX "E" OF NFPA 10 FOR DISTRIBUTION OF EXTINGUISHERS.
19. ALL DESIGNATED FIRE PARTITIONS SHALL EXTEND TIGHT TO ROOF SHEATHING & SEALED WITH APPROVED FIRE CAULK. CONTRACTOR TO VERIFY.
20. ALL ELECTRICAL, MECHANICAL & PLUMBING PENETRATING FIRE PARTITIONS SHALL BE FIRE CAULKED. (PENETRATIONS THROUGH RATED CONSTRUCTION SHALL BE SEALED WITH A MATERIAL CAPABLE OF PREVENTING THE PASSAGE OF FLAMES AND HOT GASES WHEN TESTED IN ACCORDANCE WITH ASTM–E814.)

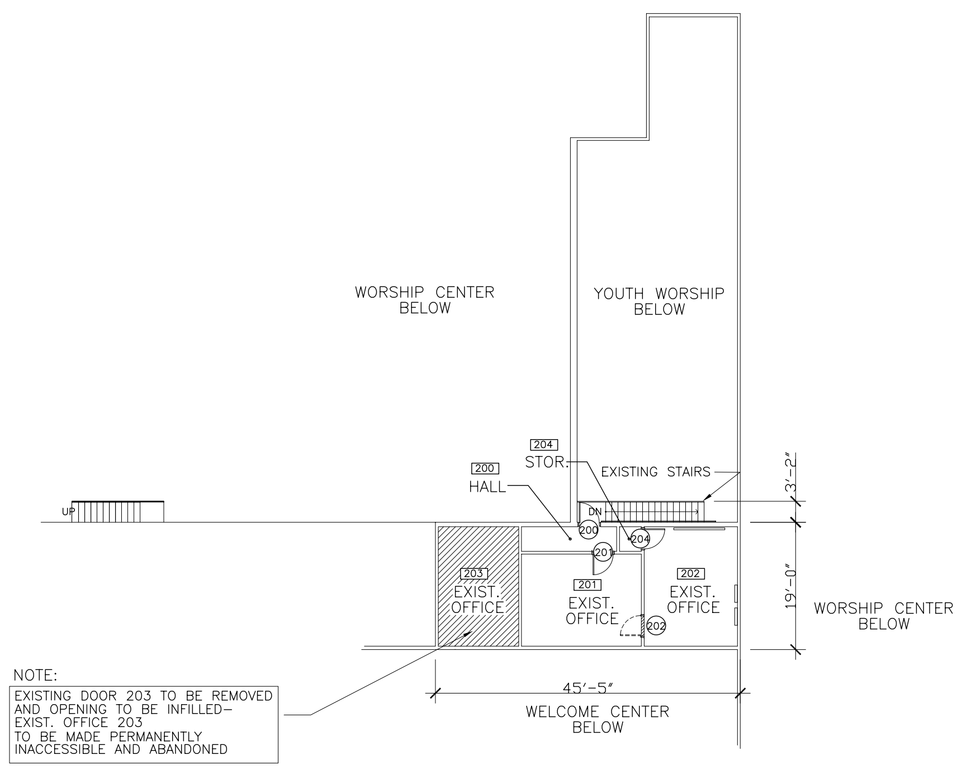

NOTE:
EXISTING DOOR 203 TO BE REMOVED AND OPENING TO BE INFILLED–EXIST. OFFICE 203 TO BE MADE PERMANENTLY INACCESSIBLE AND ABANDONED

EXISTING OFFICE MEZZANINE PLAN

SCALE 1/16"=1'–0"

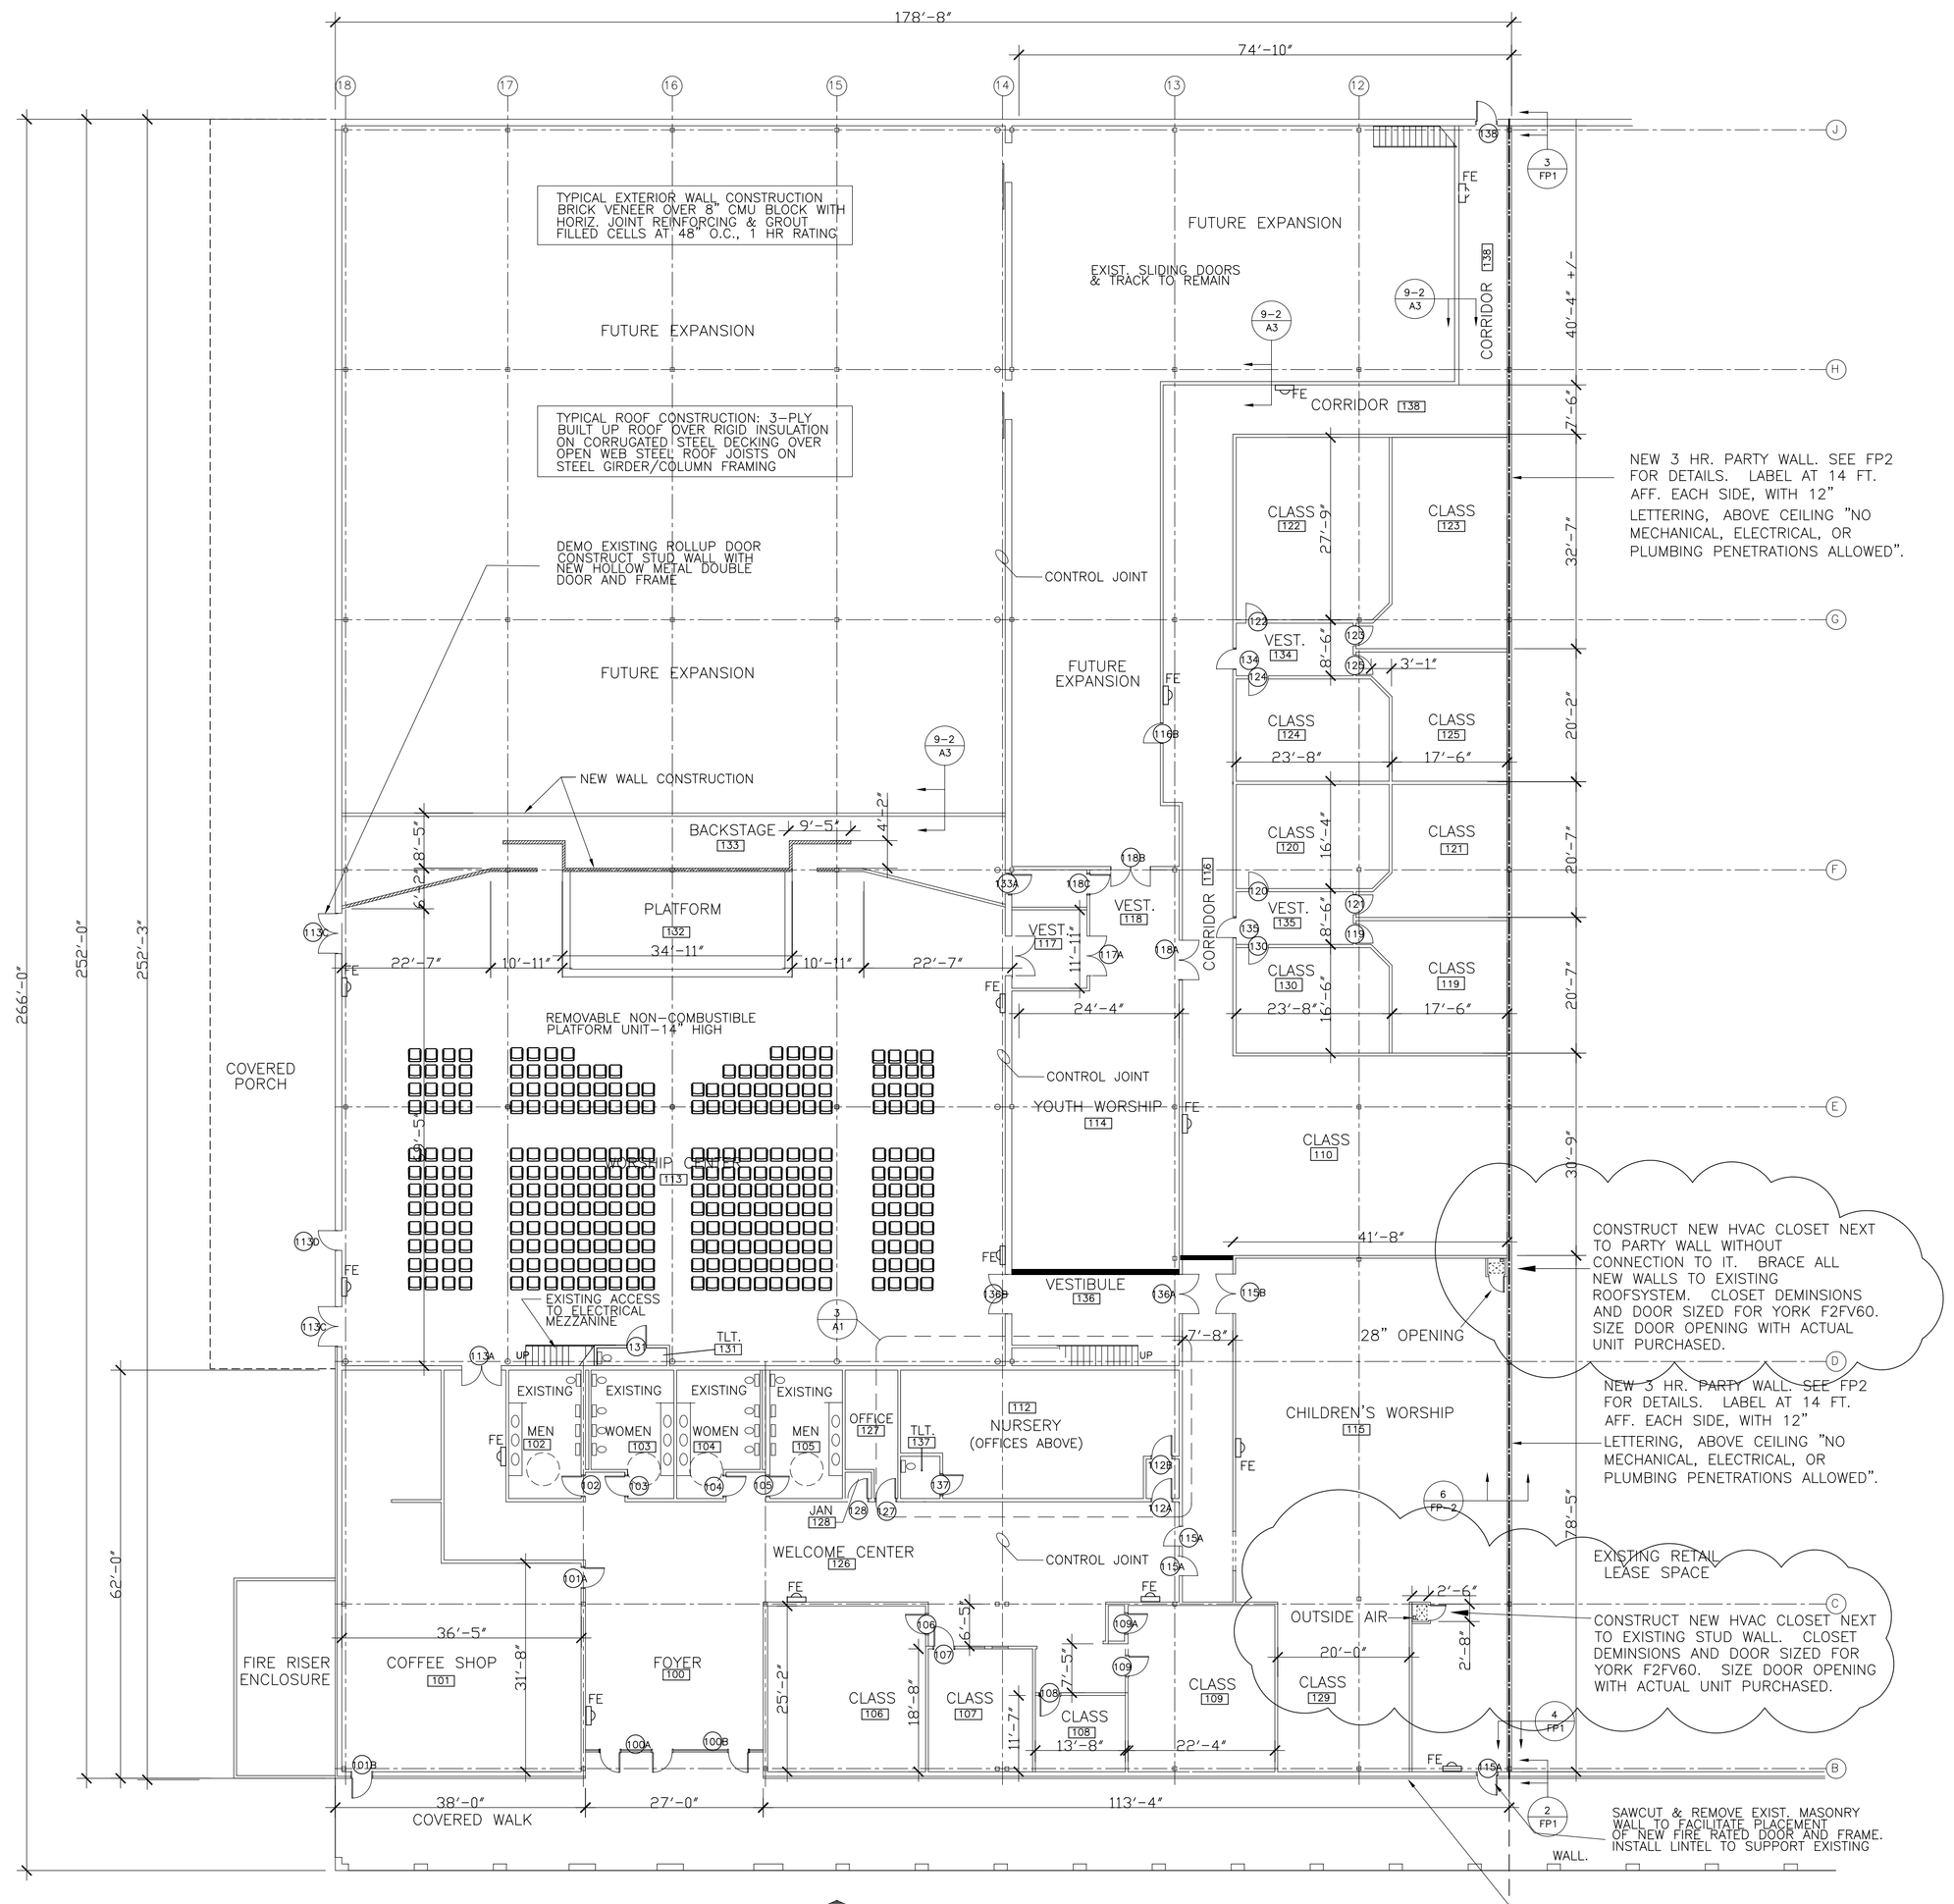

PLAN NORTH

FLOOR PLAN

SCALE 1/16"=1'–0"

AREA OF RENOVATIONS | EXISTING SEPARATED BUILDING

FE — FIRE EXTINGUISHER & CABINET–10 LB MULTI–USE

3 HOUR FIRE PARTITION–1 LAYER 9/16" DRAGONBOARD EA. SIDE OF 6" STEEL STUDS AT 24" O.C.–FILL CAVITY WITH ROCKWOOL AND EXTEND WALL TO UNDERSIDE OF EXISTING ROOF DECK–SEAL ALL PENETRATIONS UL DESIGN NUMBER U055; RE. SHEET A2, WALL TYPE 1

5/8" GYP. BD. EACH SIDE OF 2X4 STUDS AT 16" O.C. TO 6" ABOVE CEILING; BRACE AS REQUIRED. RE: SHEET A2, WALL TYPE 2

EXISTING INTERIOR PARTITION – 5/8" GYP. BOARD EACH SIDE OF 3 5/8" METAL STUDS AT 16" O.C. – FULL HEIGHT PARTITION
EXISTING EXTERIOR PARTITION – BRICK VENEER OVER 8" CMU BLOCK BACKUP WITH HORIZ. JOINT REINF. AT 16" O.C. VERT.

DAMMON ENGINEERING, INC.

CHIEF ENGINEER
EMMETT
DAMMON, P.E.

CHIEF ARCHITECT
ROBERT
WILTSE

1095 FLORIDA AVENUE
SLIDELL, LA. 70458
OFFICE: 985-649-5832
FAX: 985-641-5950

WEBSITE:
WWW.DAMMONENGINEERING.COM

EMAIL:
DAMMONENG@BELLSOUTH.NET

ARCHITECTURE

ENGINEERING

STUDIES

PLANNING

INVESTIGATION

EXPERT WITNESS

NORTHSHORE CHURCH
KENSINGTON DR.
SLIDELL, LA

FLOOR PLAN

REV: #3 11-2-09

SCALE: AS NOTED

JOB#: 1988

DATE: 09-30-08

SHEET

A–1

OF