# GENERAL RCP NOTES

ALL CEILING HEIGHTS INDICATED ARE APPROXIMATE. ACTUAL CEILING HEIGHT TO BE DETERMINED BY STRUCTURE ELEVATION AND CEILING ASSEMBLY THICKNESS; HOWEVER OCCUPIABLE SPACES SHALL NOT HAVE A CEILING HEIGHT LESS THAN 7'-6" (PER IBC 1208.2).

# RCP LEGEND

| SYMBOL | DESCRIPTION |
|---|---|
| | 2x4' SUSPENDED FLUORESCENT LIGHT FIXTURE |
| | 2x2' SUSPENDED FLUORESCENT LIGHT FIXTURE |
| | DIRECTIONAL FLOOD LIGHT FIXTURE |
| | SURFACE MOUNTED FLUORESCENT STRIP LIGHT FIXURE |
| | PENDANT LIGHT FIXTURE |
| | RECESSED CAN LIGHT FIXTURE |
| | SURFACE MOUNTED LIGHT FIXTURE |
| | EXHAUST FAN |
| | HVAC SUPPLY AIR DIFFUSER |
| | CHANDELIER |

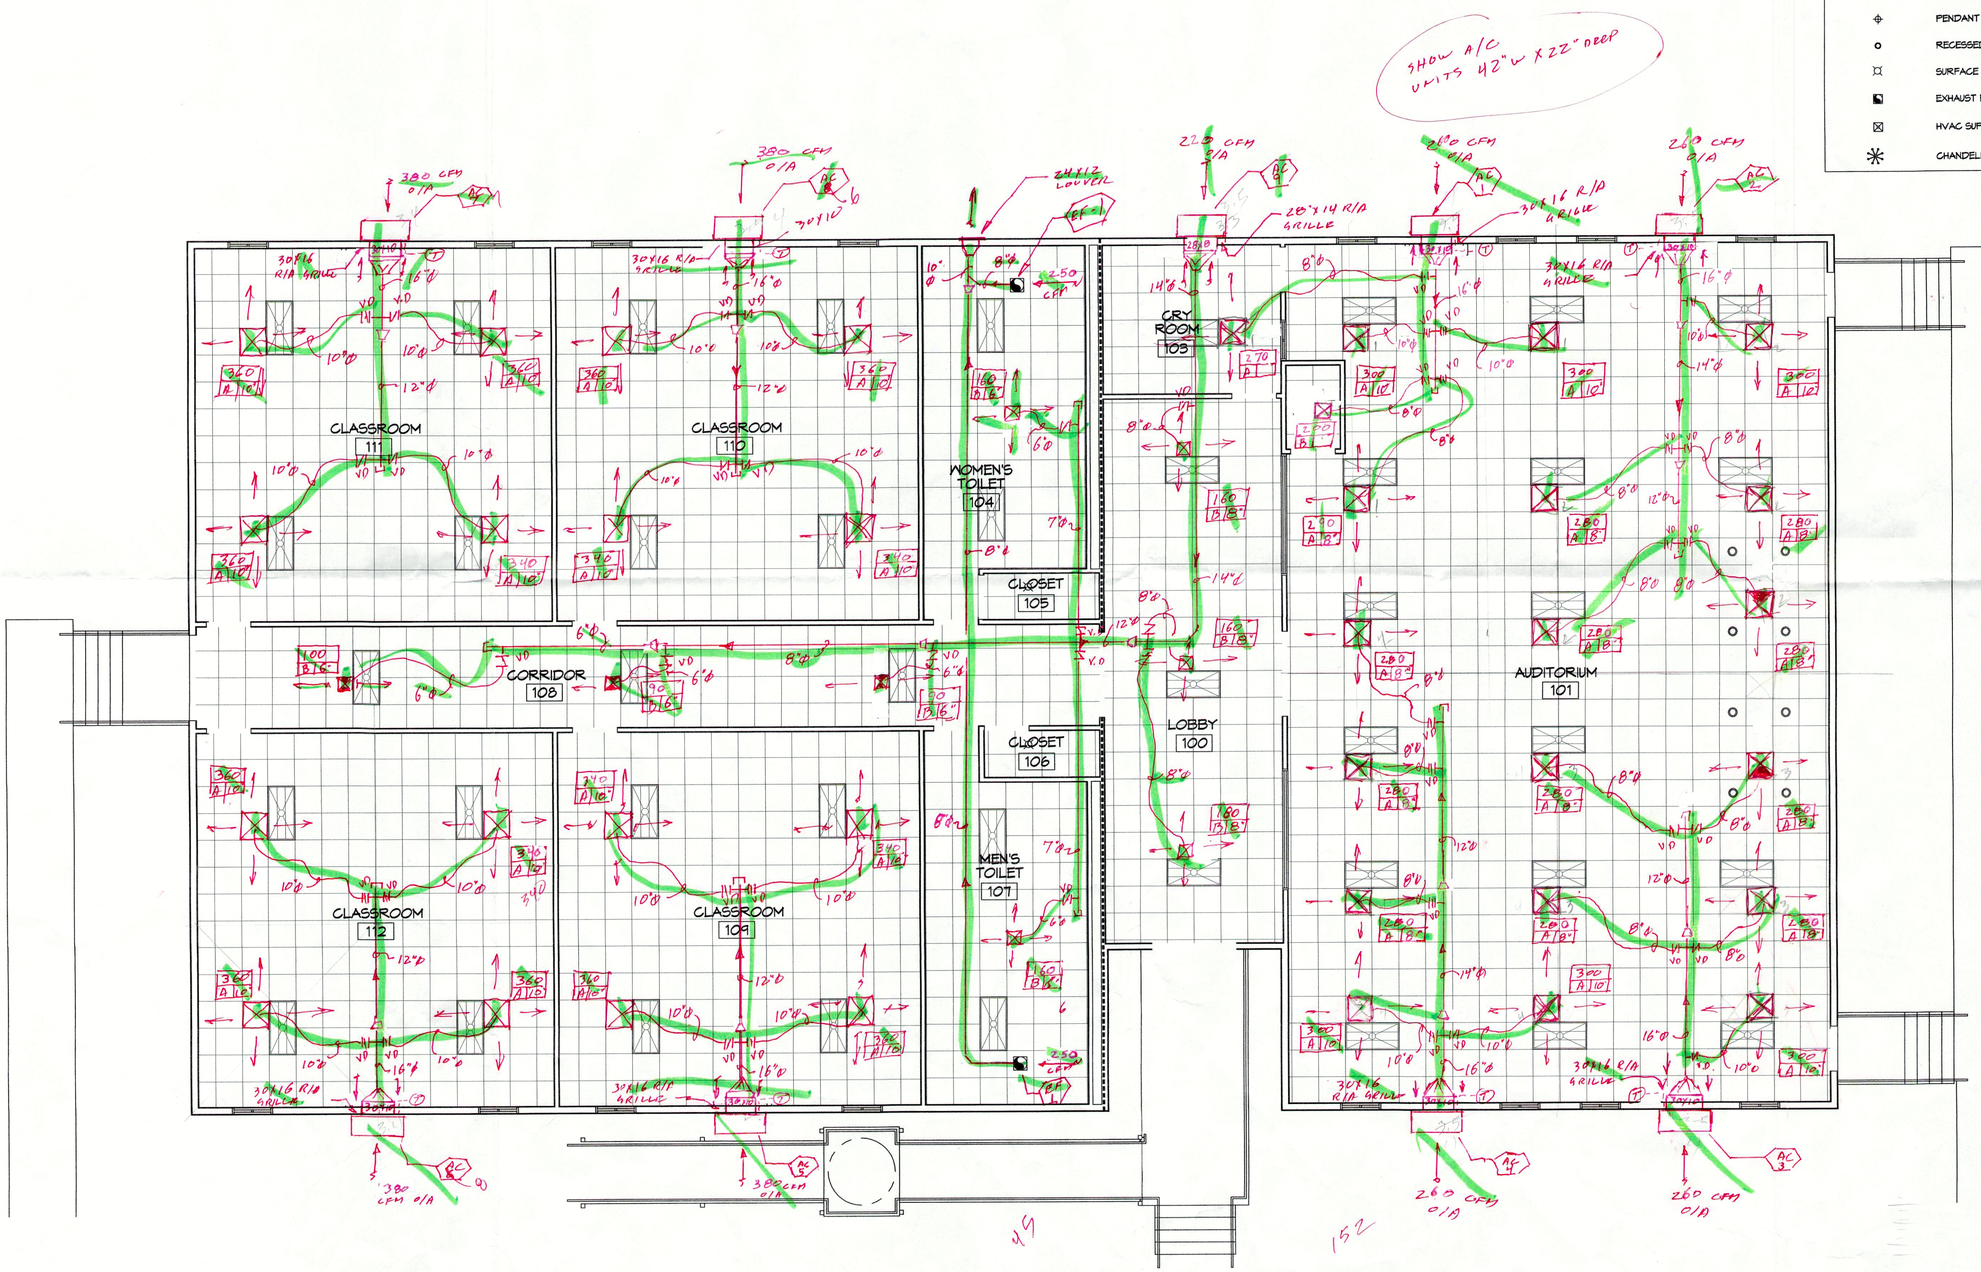


1 REFLECTED CEILING PLAN
SCALE: 3/16"=1'-0"


DAMMON ENGINEERING, INC.
LOUISIANA & MISSISSIPPI
www.dammonengineering.com
Sales@dammonengineering.com
PH: 985.649.5832 F: 985.641.5950
Chief Engineer: Brian Mistich, PE
1000 Dove Street, Ste 1-A
Slidell, LA 70458


| # | DESCRIPTION | DATE |
|---|---|---|
| | | |

REVISIONS

THE CROSSING

4-H RED RIVER CV.
PEARL RIVER, LA 70452

| | |
|---|---|
| JOB No: | 2394 |
| DATE: | 9/15/2017 |
| DRAWN BY: | MKW |
| CHECKED BY: | JMS |


THIS DRAWING AND ANY DOCUMENTS, PLANS, OR SPECIFICATIONS PREPARED FOR THIS PROJECT BY DAMMON ENGINEERING, INC. ARE INSTRUMENTS OF SERVICE THROUGH EXECUTION OF THE PROJECT. THE ARCHITECT/ENGINEER SHALL RETAIN OWNERSHIP AND PROPERTY RIGHTS IN THESE DOCUMENTS, WHETHER THE PROJECT IS EXECUTED OR NOT. THE OWNER MAY MAKE AND RETAIN COPIES FOR INFORMATION AND REFERENCE IN CONNECTION WITH THE OWNER'S USE AND OCCUPANCY OF THE PROJECT. THE DOCUMENTS MAY NOT BE USED BY THE OWNER OR OTHERS ON OTHER PROJECTS OR EXTENSIONS TO THIS PROJECT, EXCEPT BY AGREEMENT IN WRITING AND WITH APPROPRIATE COMPENSATION TO THE ARCHITECT/ENGINEER.


SHEET TITLE:
REFLECTED CEILING PLAN

DRAWING NUMBER:
A104

SHEET No: 10 of 15