


ZONED C-6

PLAT OF SURVEY OF 24.6635 ACRES WHICH IS LOT 2A IN SLIDELL FACTORY OUTLETS SVD SECTION 23 - T. 9 S. - R. 14 E. CITY OF SLIDELL ST. TAMMANY PARISH, LOUISIANA

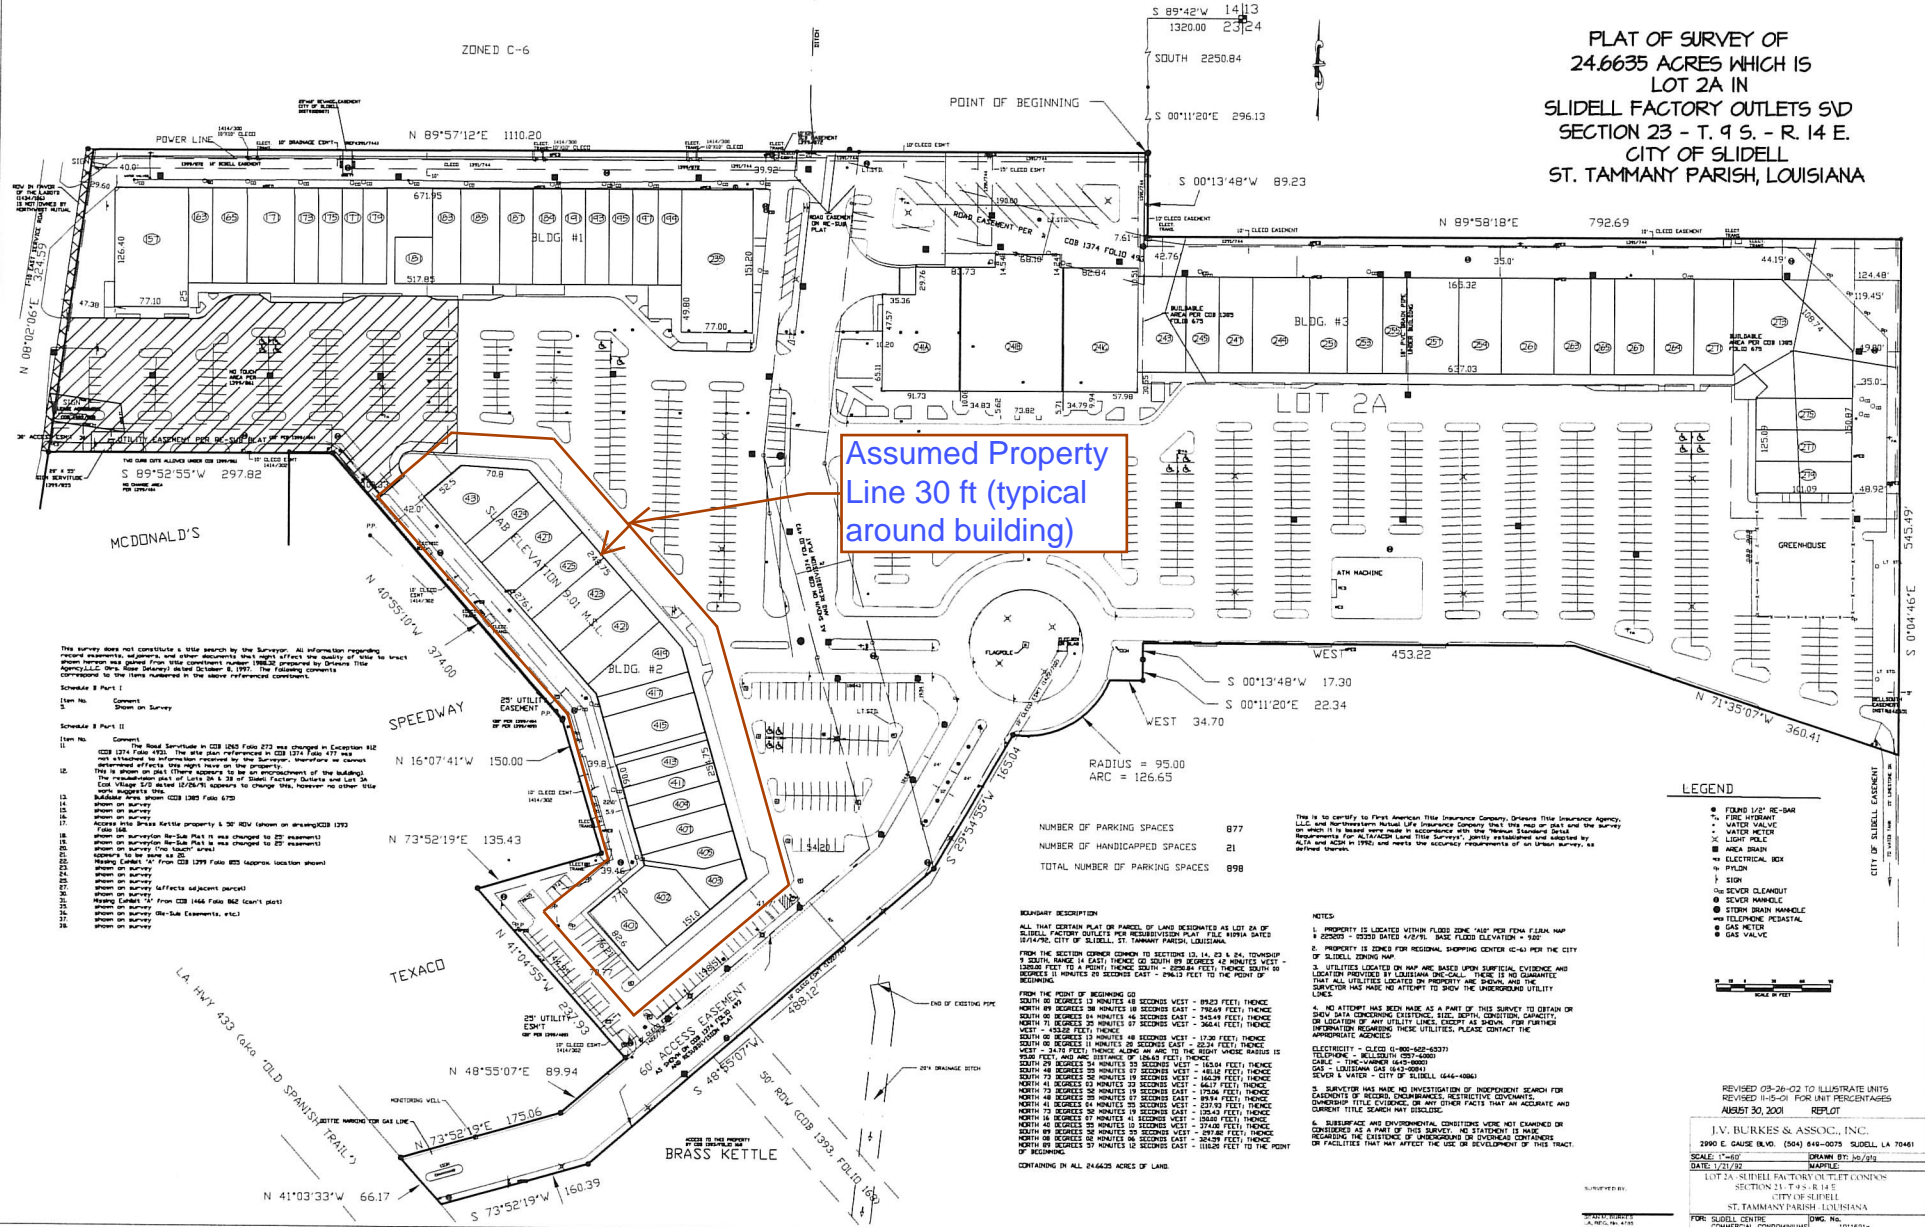

Assumed Property Line 30 ft (typical around building)



NUMBER OF PARKING SPACES 877
NUMBER OF HANDICAPPED SPACES 21
TOTAL NUMBER OF PARKING SPACES 898



- LEGEND
* FOUND 1/2" OR BEAR
* UTILITY
* WATER METER
* FENCE
* AREA DRAIN
* ELECTRICAL BOX
* SIGN
* SEVER CLEARED
* SEVER HAZARDOUS
* STEEP DRAIN HAZARDOUS
* GAS METER
* GAS VALVE



REVISION 03-26-02 TO ILLUSTRATE UNITS
J.V. BURKES & ASSOC., INC.
DATE: 1/21/02 DRAWN BY: JVB/BJB
LOT 2A, SLIDELL FACTORY OUTLETS SVD
SECTION 23, T. 9 S., R. 14 E.
CITY OF SLIDELL
ST. TAMMANY PARISH, LOUISIANA
FOR: SLIDELL CENTRE DWG. NO.
COMMERCIAL DEVELOPMENT 1016718