


PARKING REQUIREMENTS:

1 SPACE PER 350 SQ.FT. OF OFFICE SPACE
1 SPACE PER 750 SQ.F.T. OF WAREHOUSE SPACE
TOTAL REQUIRED=160
TOTAL PROVIDED=174

LEGEND:

- - - - - PROPERTY LINE
- - - - - SETBACK LINE
- NEW BUILDING
- CLASS "A" TREE—MINIMUM OF 10' TO 12' HIGH, CALIPER OF 2-1/2" MEASURED AT 1-1/2 FT ABOVE THE GROUND
- CLASS "B" TREE—MINIMUM OF 8' TO 10' HIGH, CALIPER OF 1-1/2" MEASURED AT 1-1/2 FT ABOVE THE GROUND
- SHRUB

U.S. INTERSTATE HWY. 12

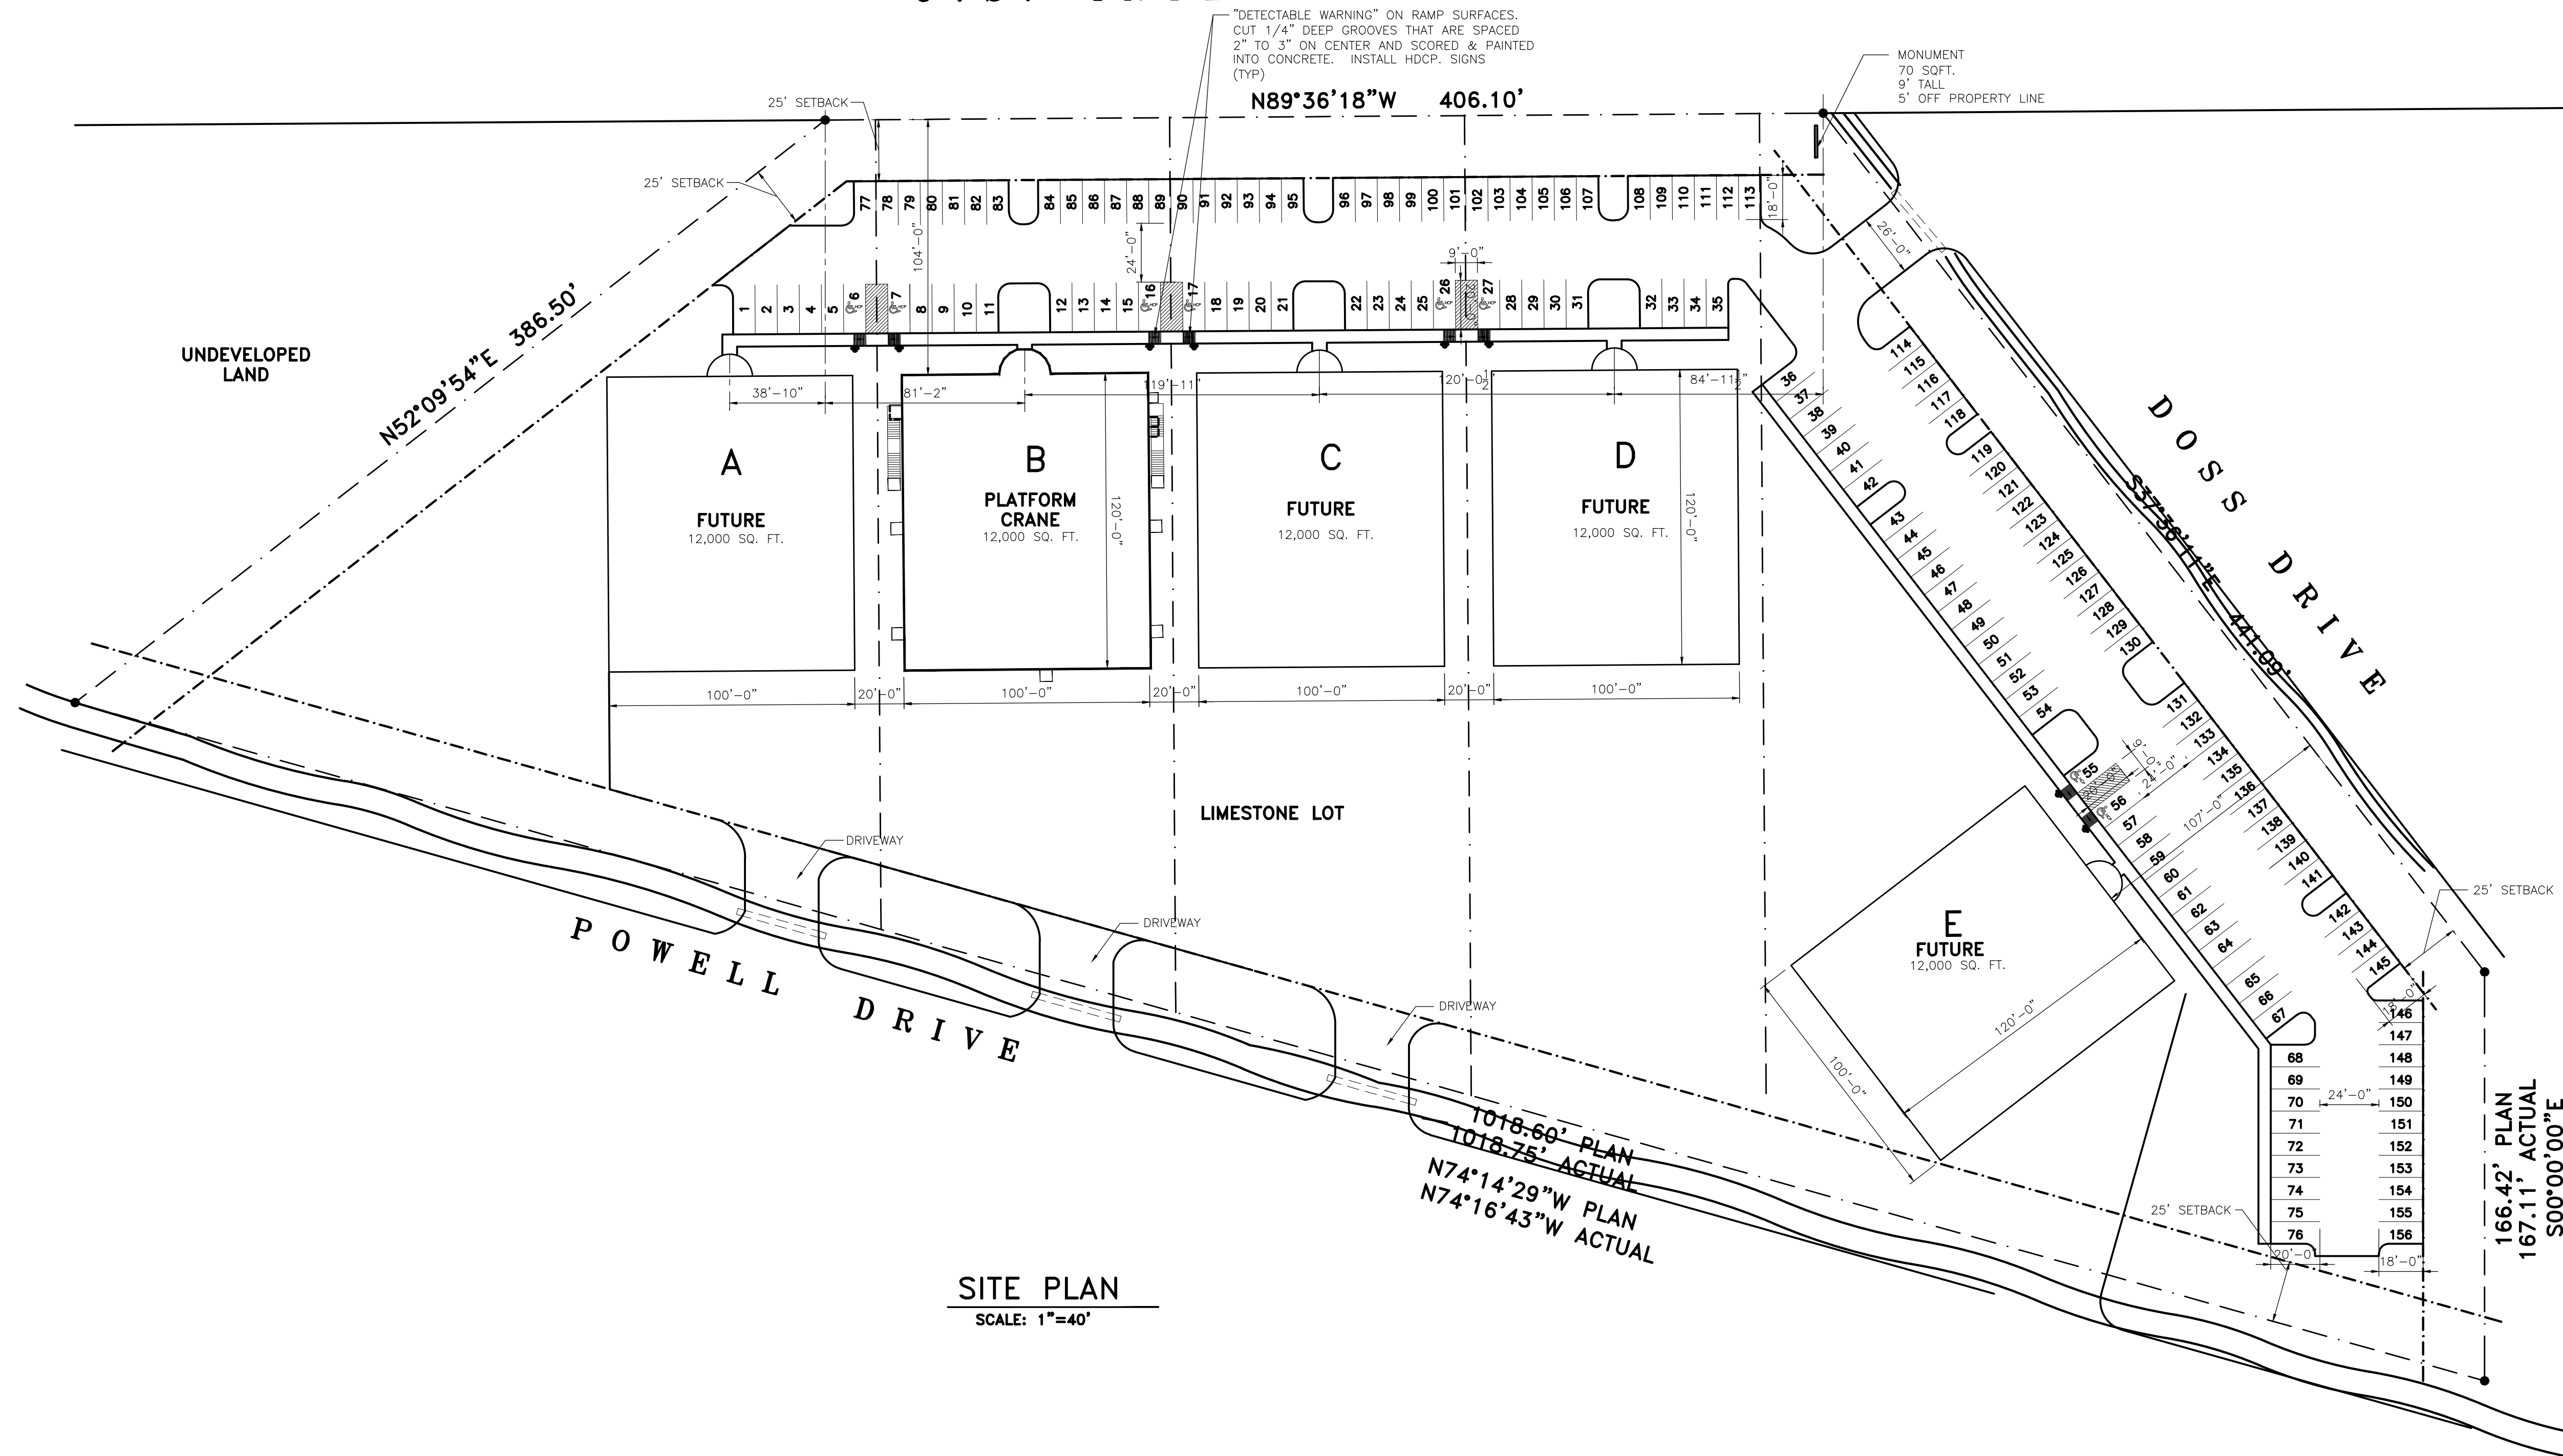

SITE PLAN
SCALE: 1"=40'

SITE PLAN

PLATFORM CRANE SERVICE
DOSS DRIVE
SLIDELL, LOUISIANA

OFFICE/WAREHOUSE

DAMMON ENGINEERING, INC.
1095 FLORIDA AVENUE 985-649-5832 SLIDELL, LA. 70458
DAMMONENGINEERING.COM

SCALE: AS NOTED

FILE:

JOB NO. 1655

DATE: 04-07-05

SHEET

C-2

OF