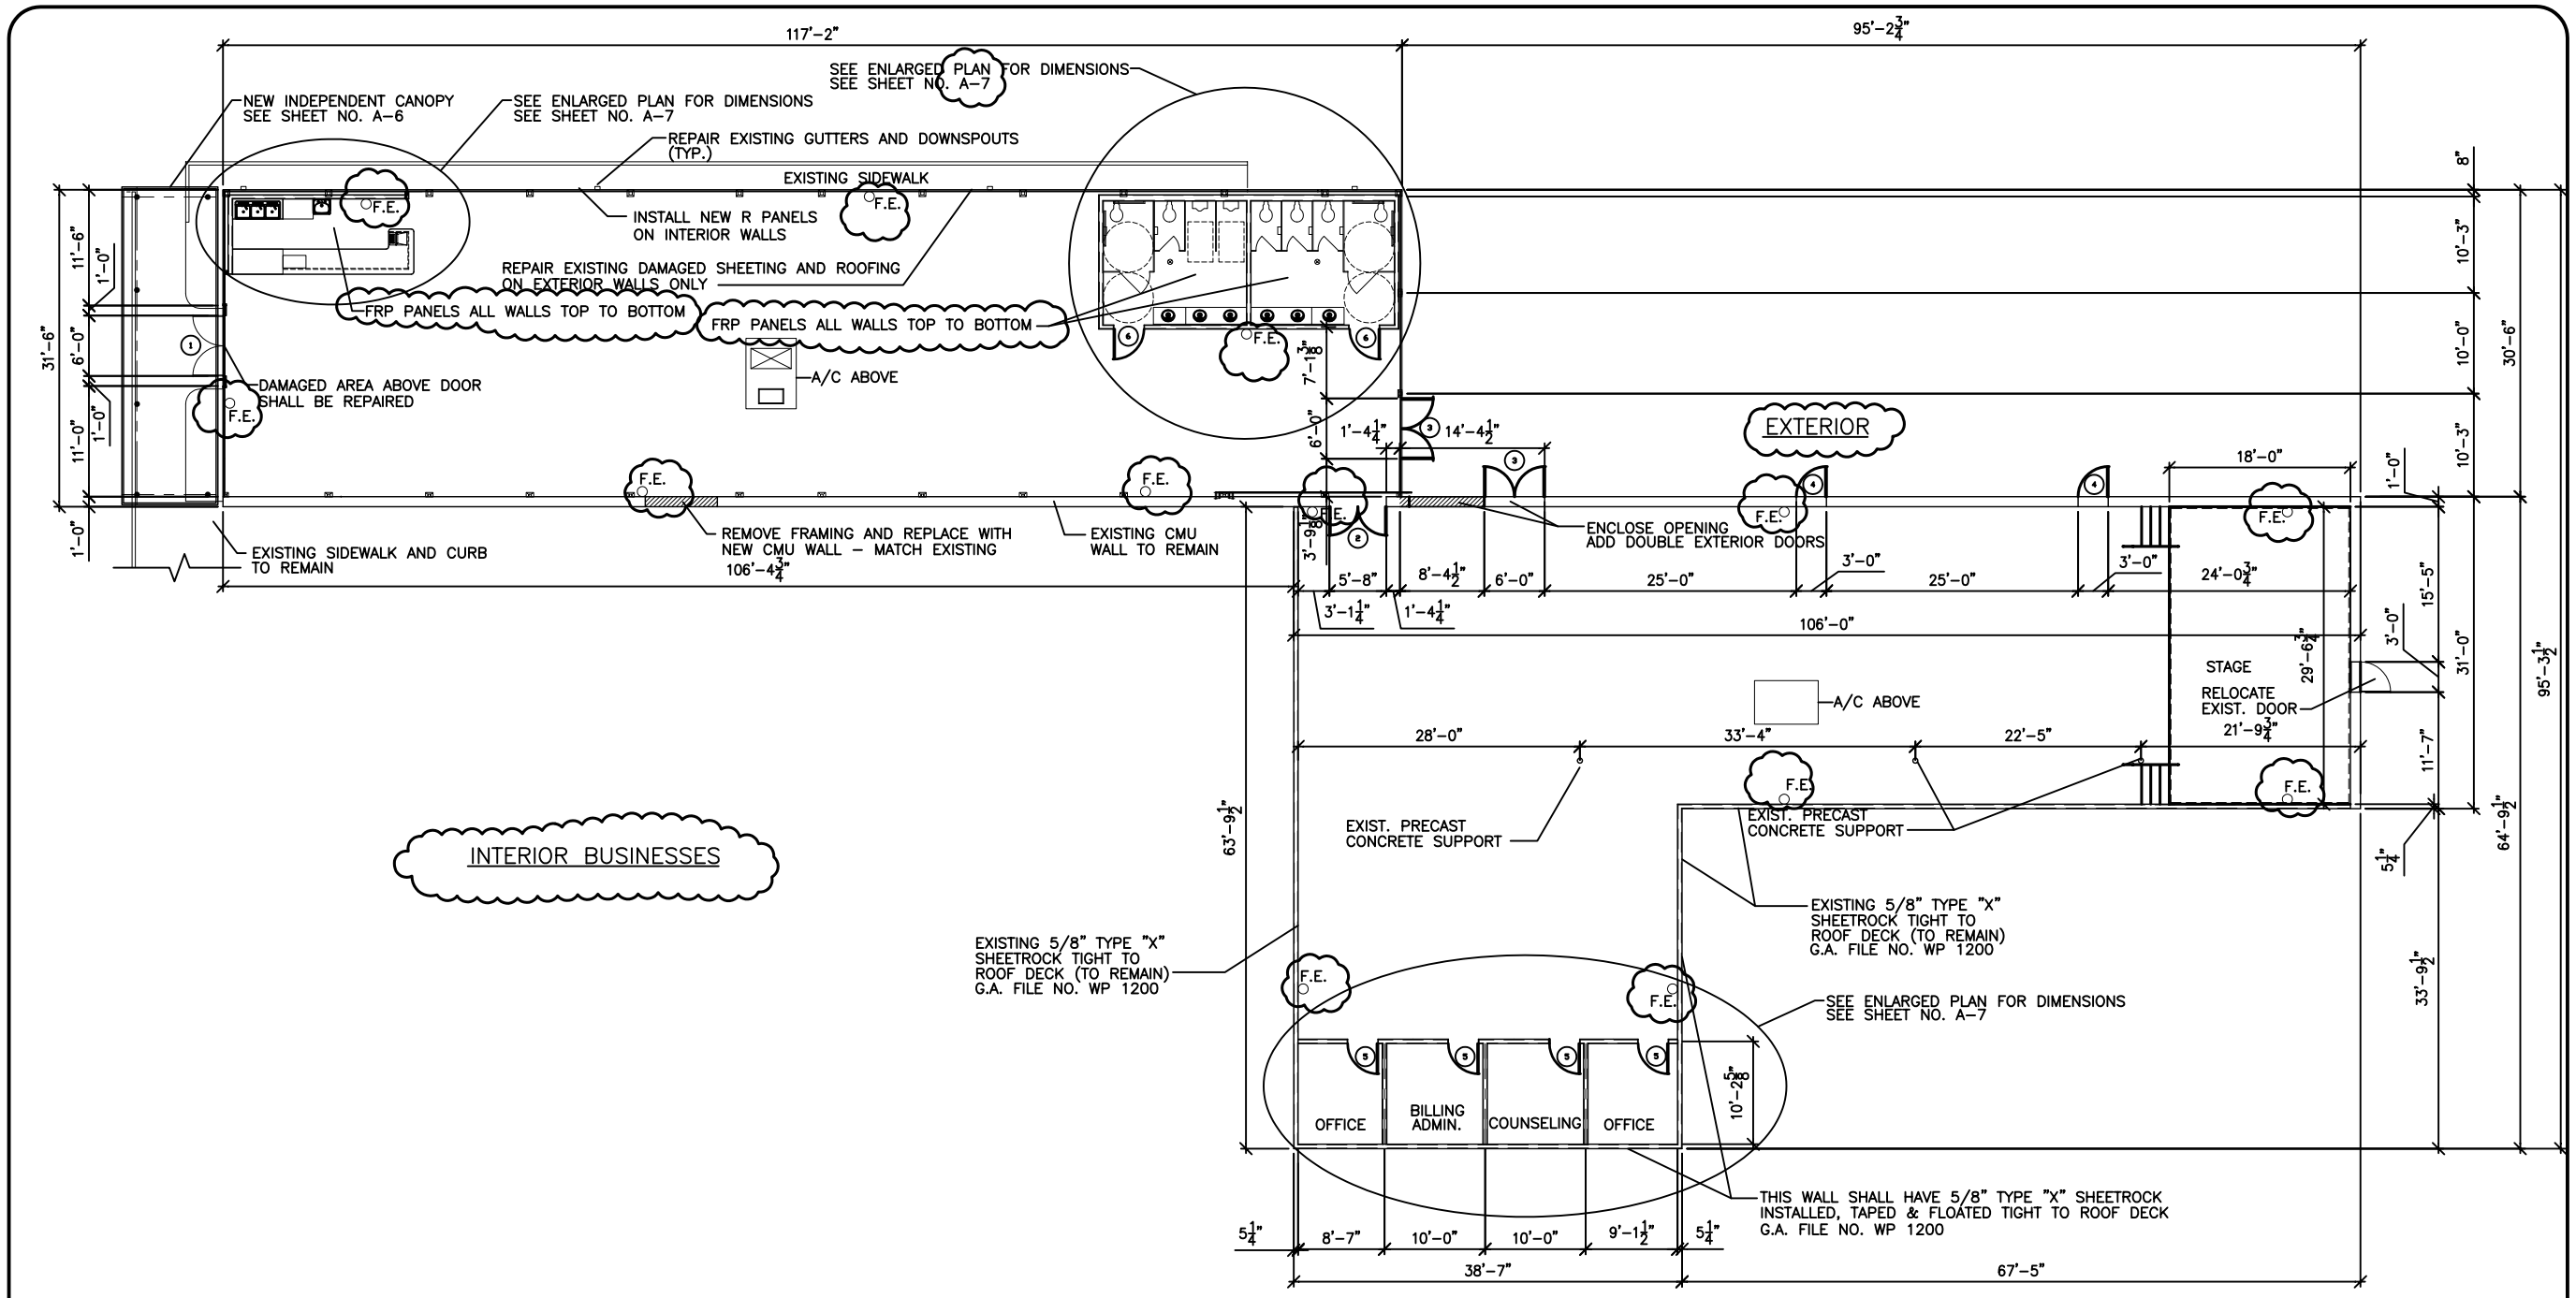

FLOOR PLAN

SCALE: 1/8" = 1'-0"

DOOR & HARDWARE SCHEDULE

	DOOR	TYPE: HOLLOW WOOD	TYPE: HOLLOW METAL	TYPE: ALUM/GLASS	TYPE: STOREFRONT	FRAME: STEEL	FRAME: ALUMINUM	FRAME: WOOD	HINGE: DBL SWING	HINGE: BUTT	HINGE: BURGLERPRF	HINGE: NONE	LOCK: PASSAGE	LOCK: PRIVACY	LOCK: DEADBOLT	LOCK: KEYED HANDLE	LOCK: PUSH PULL	ACCESSORIES: PANIC BAR	ACCESSORIES: THRESHOLD	ACCESSORIES: WEATHERSTRIP	ACCESSORIES: DOOR STOP	ACCESSORIES: ALARM	ACCESSORIES: CLOSURE	ACCESSORIES: FULL GLASS	REMARKS
1	(2)-3/0x7/0x1 3/4"		●				●			●						●			●	●				●	EXISTING
2	(2)2/8x6/8x1 3/4		●			●				●								●							45 MIN. RATED
3	(2)3/0x6/8x1 3/4		●			●				●								●	●	●		●	●		
4	3/0x6/8x1 3/4		●			●				●								●	●	●		●	●		
5	3/0x6/8x1 3/4		●			●				●				●		●					●				
6	3/0x6/8x1 3/4		●			●				●			●										●		

NOTES:

THIS BUILDING HAS AN EXISTING SPRINKLER SYSTEM. CONTRACTOR SHALL HIRE A SPRINKLER COMPANY TO CHECK AND RELOCATE SPRINKLER SYSTEM TO FIT ITS NEW REQUIREMENTS. ALL SUBMITTTALS MUST BE APPROVED THROUGH THE MARSHALL.

REVISION DATE: 01/19/07

FLOOR PLAN

CLUB E
YOUTH CENTER RENOVATION
1321 GAUSE BLVD. SUITE 3
SLIDELL, LOUISIANA 70458

CLUB E

DAMMON ENGINEERING, INC.
1095 FLORIDA AVENUE 985-649-5892 SLIDELL, LA. 70458
DAMMONENGINEERING.COM

SCALE:AS NOTED
FILE:
JOB NO. 1805
DATE:11/15/06
SHEET
A-1
OF