


HIGHWAY DRIVE

154'-10 5/8"

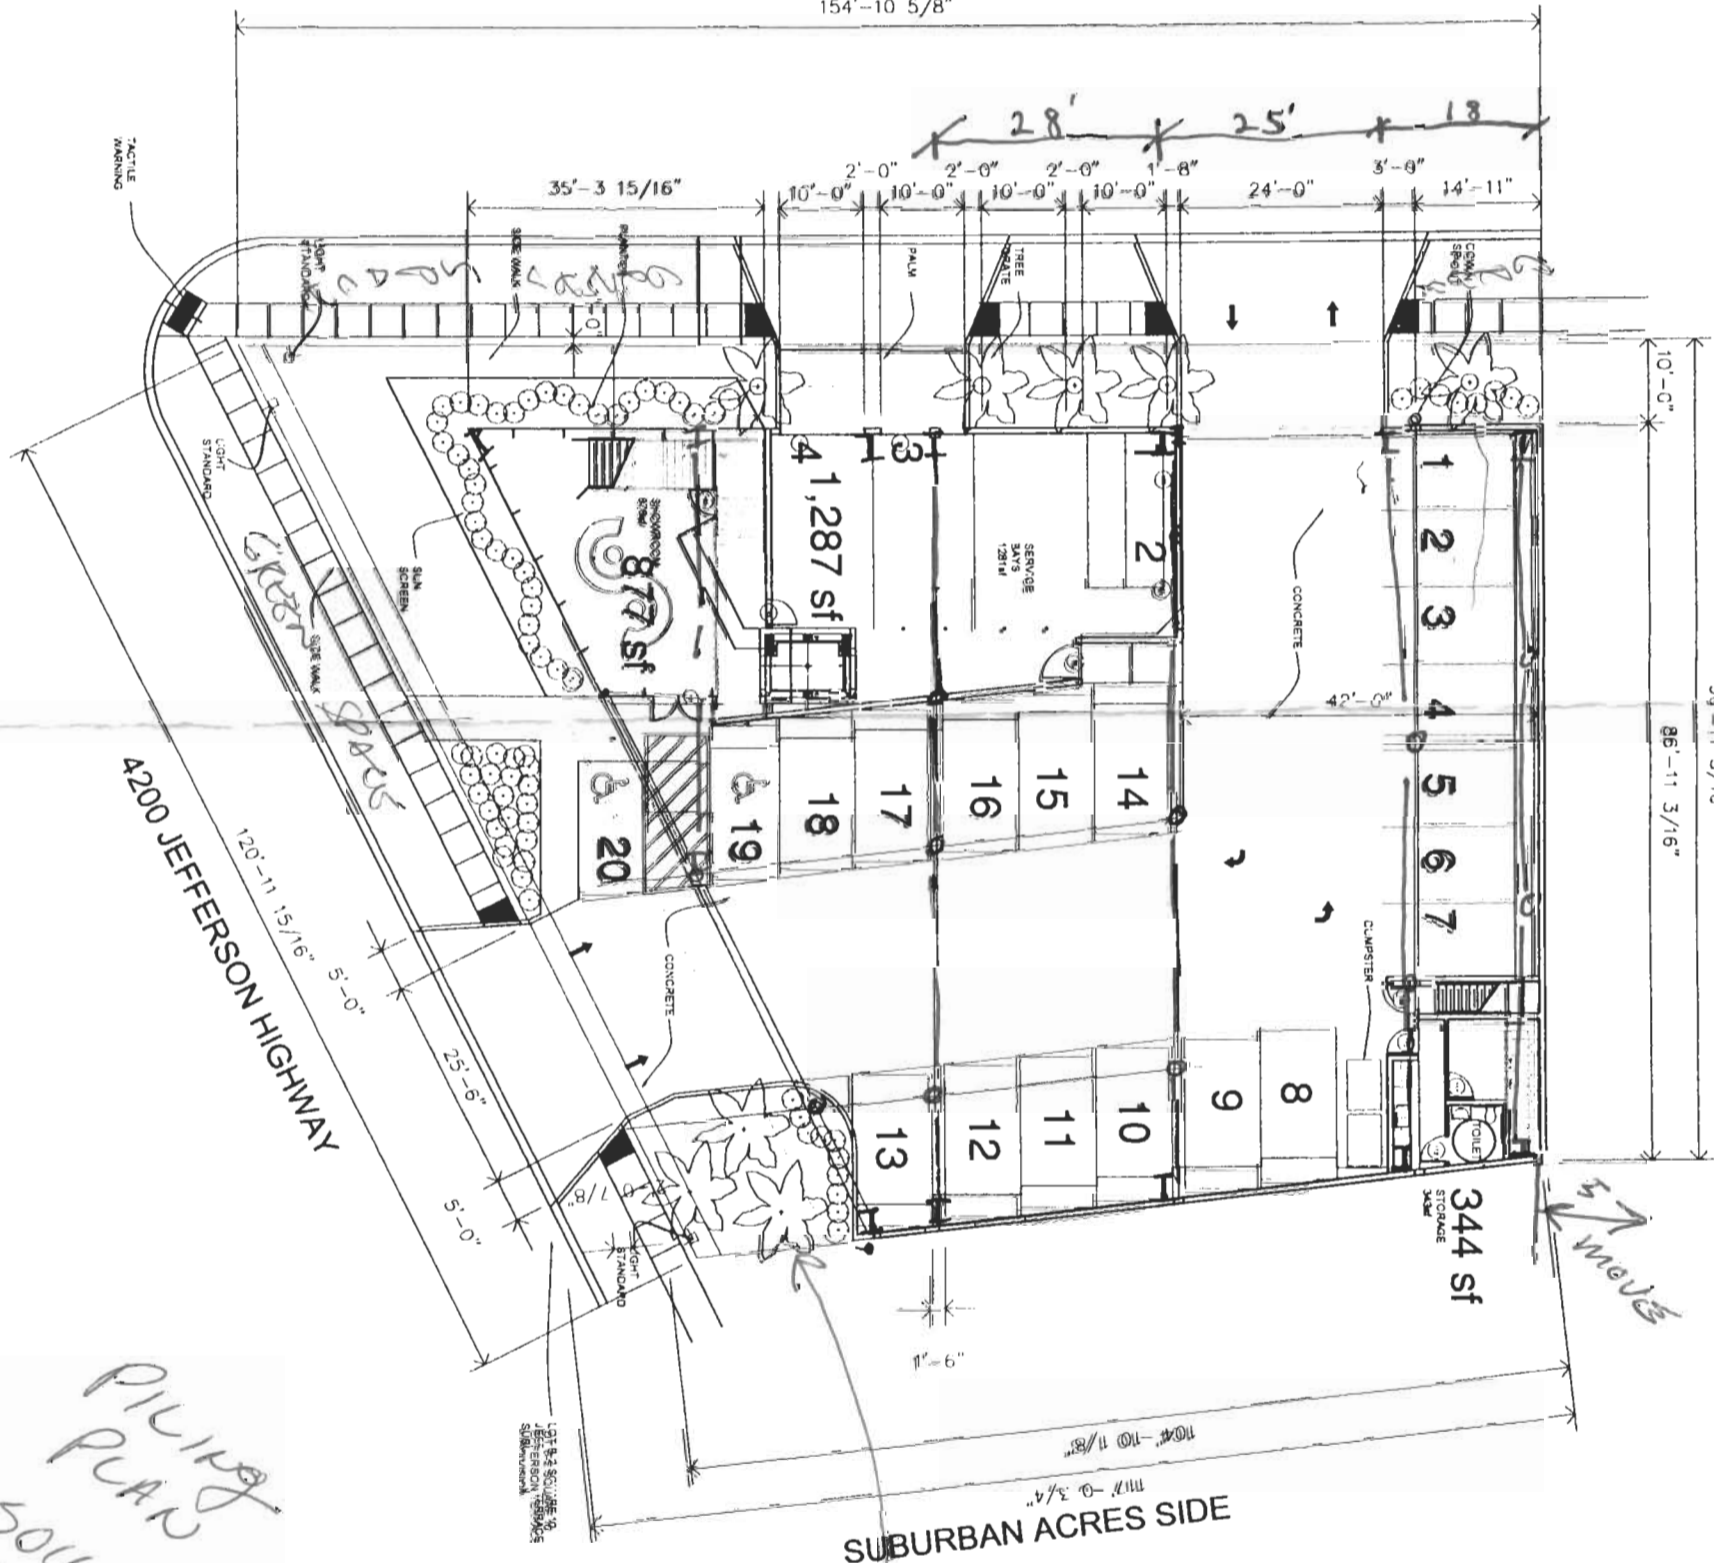

1 Site Plan



*PILING PLAN  
SOIL ANALYSIS*

SUBURBAN ACRES SIDE

*Dumpster  
Location*

*GO. FR. TO PICK UP  
50. MAIL PRESS*

*LEONARD FAUSTER  
504-736-6957  
Benny AB  
504-736-6380*

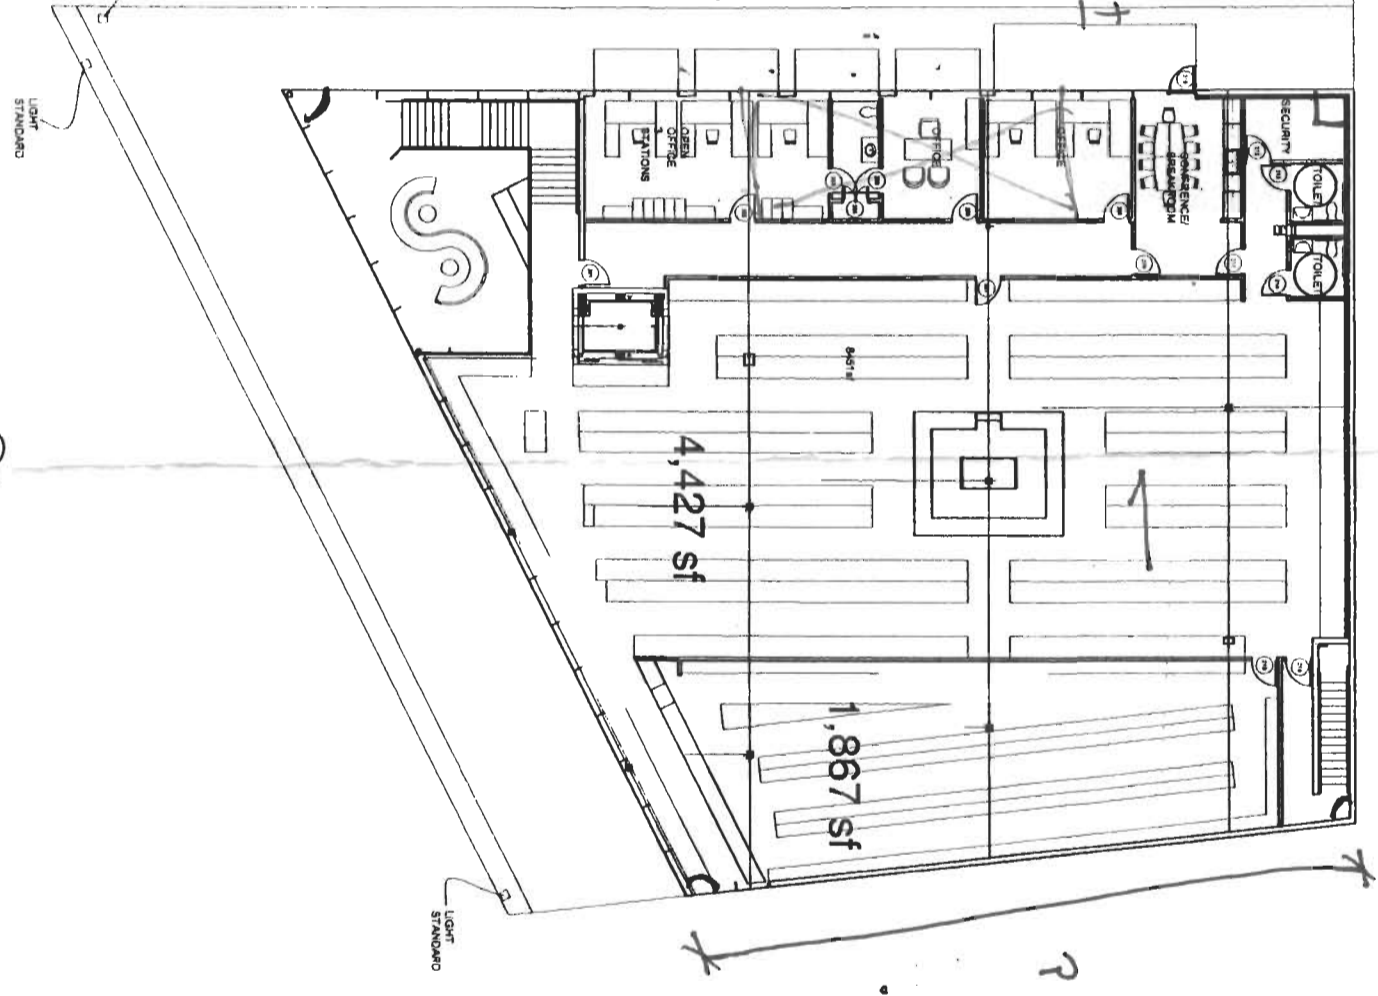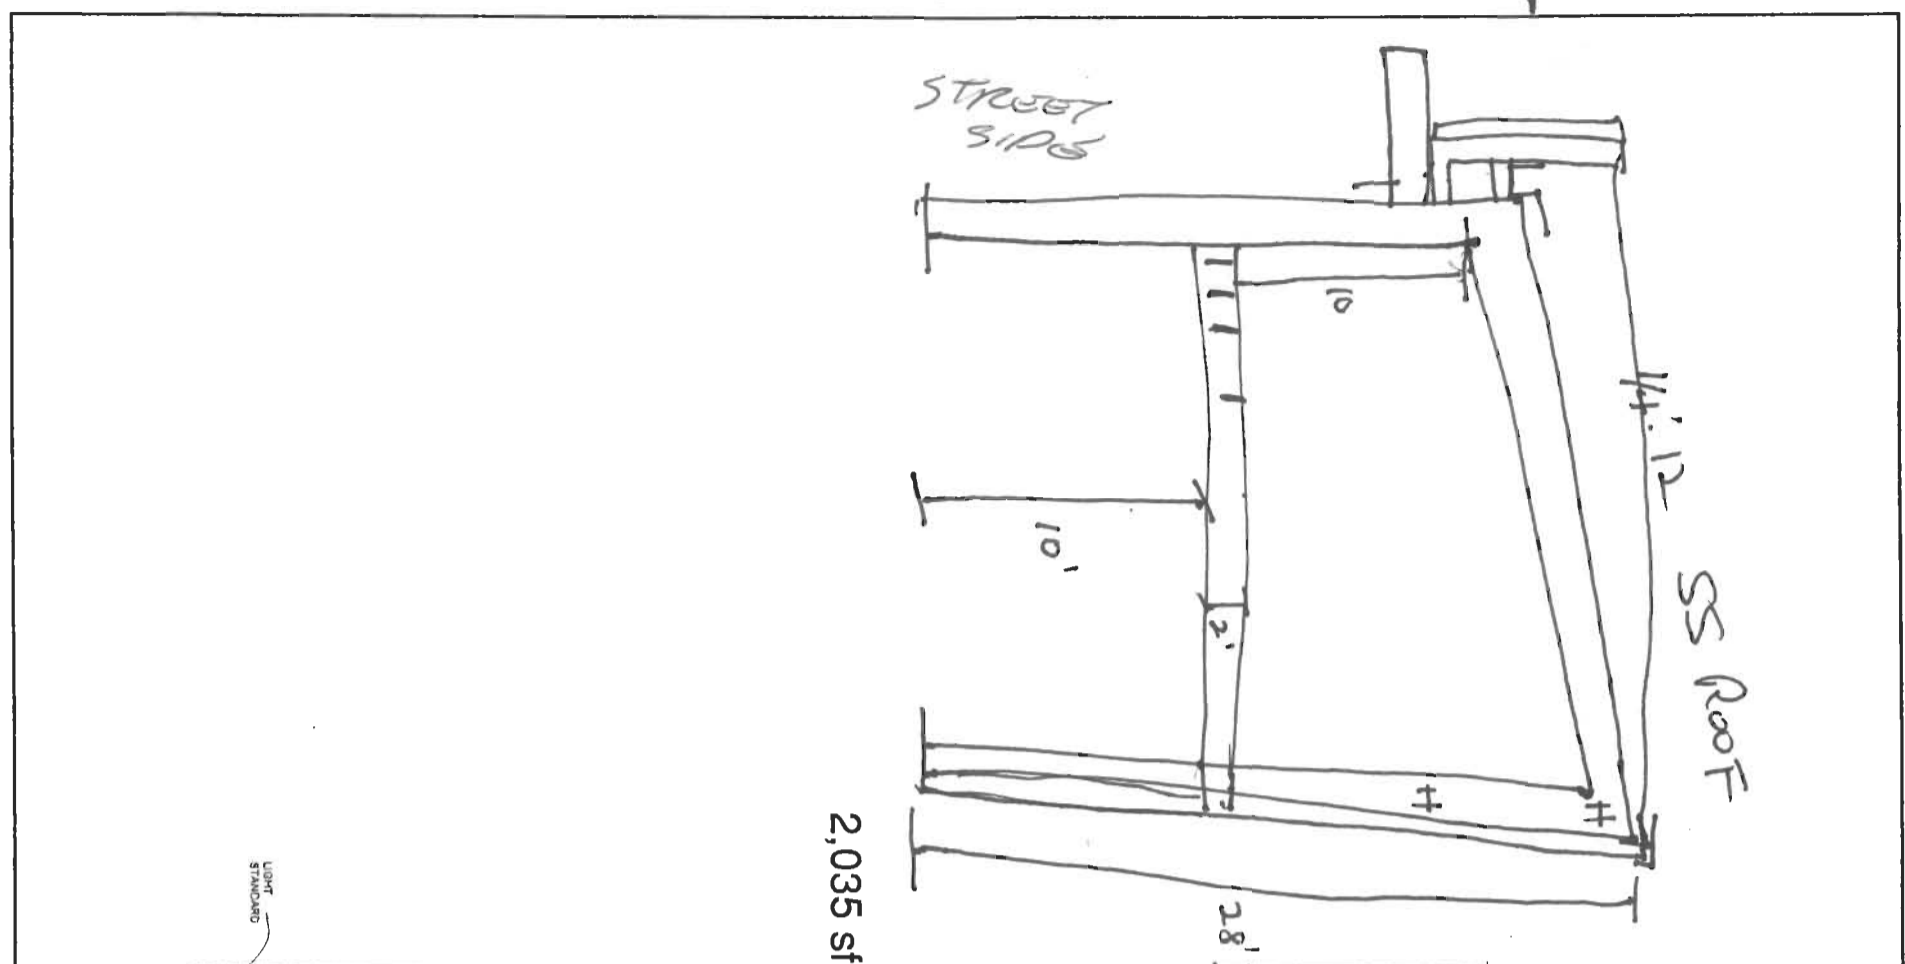

10,837 sq. ft.

1 Second Floor Plan



PROJECT	DATE	SCALE	BY	CHECKED
Hubcap, Tire & Wheel, Inc.	1/28	1/8" = 1'-0"		
4200 Jefferson Hwy., Jefferson, Louisiana 70121				

Hubcap, Tire & Wheel, Inc.  
4200 Jefferson Hwy., Jefferson, Louisiana 70121

A101