


Carpet World  
8833 W. Judge  
Paras

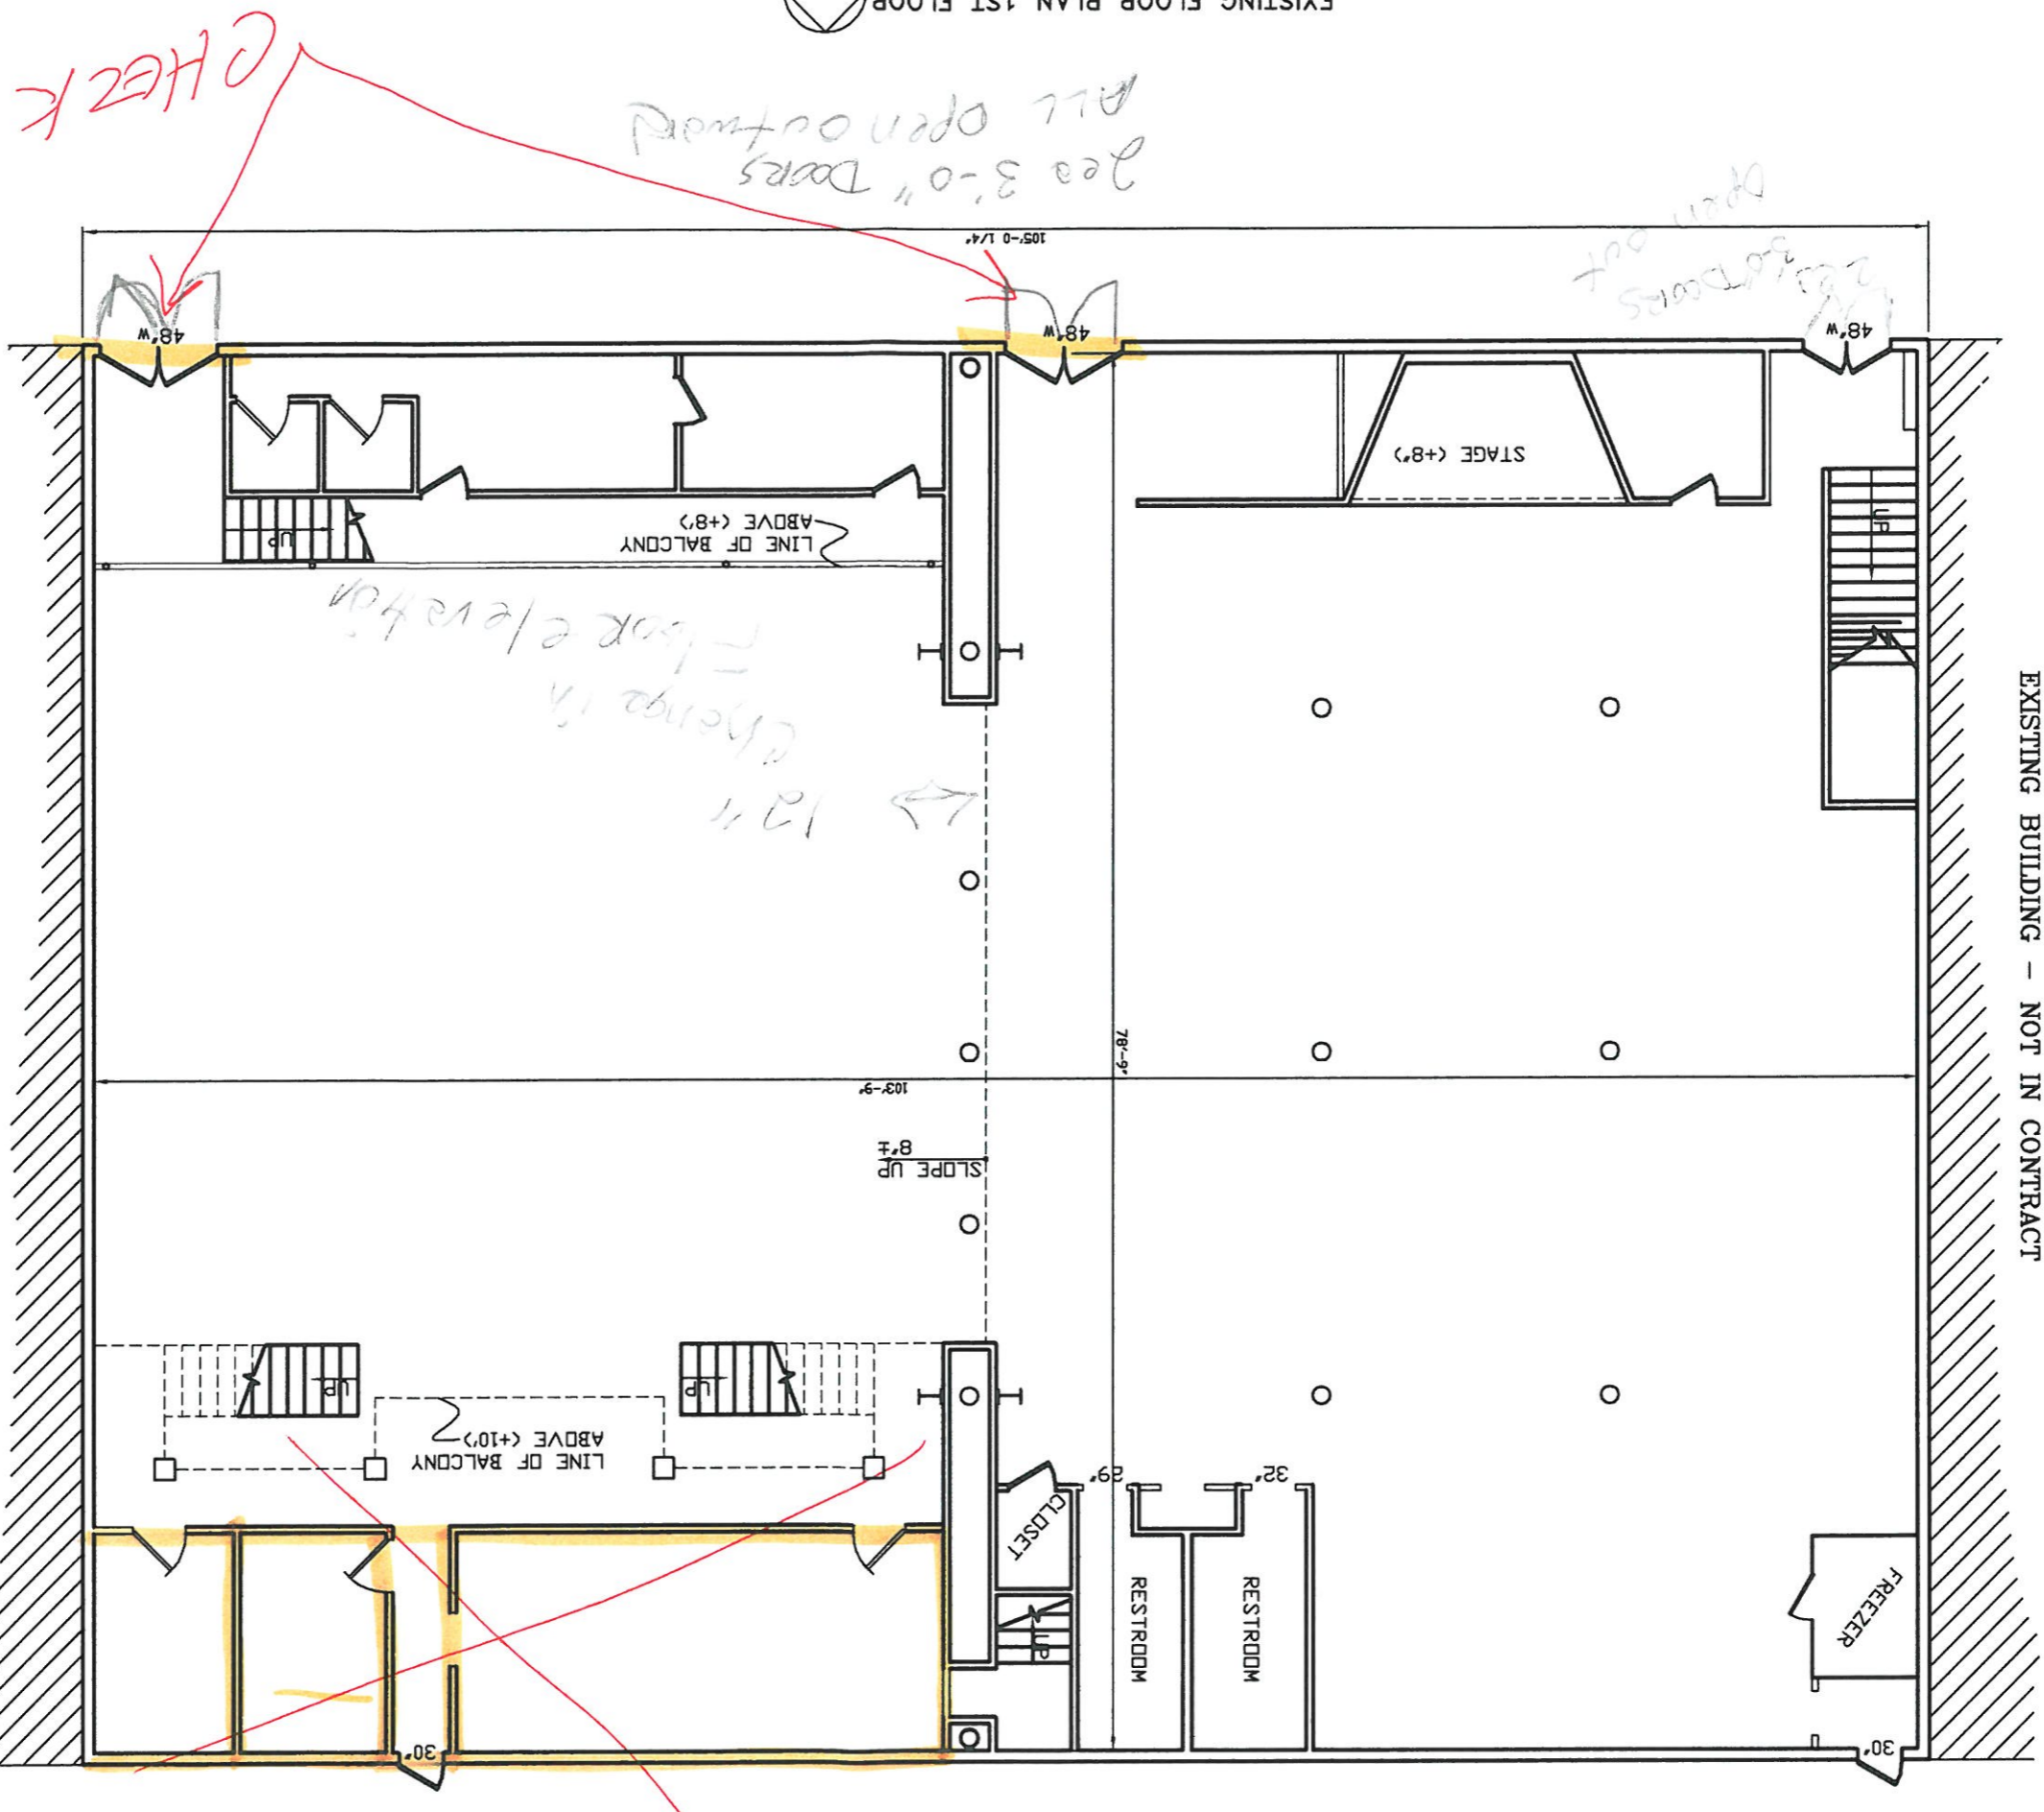

EXISTING FLOOR PLAN 1ST FLOOR  
SCALE: 3/16"=1'-0"



EXISTING BUILDING - NOT IN CONTRACT

EXISTING BUILDING - NOT IN CONTRACT