


SITE REMOVAL NOTES

- 1 REMOVE EXISTING CONCRETE PARKING LOT AND ADJACENT SIDEWALK. DO NOT DAMAGE SUB-SURFACE DRAINAGE SYSTEM. RETAIN CATCH BASIN COVERS FOR RE-USE.
- 2 REMOVE EXISTING SIDEWALK.
- 3 REMOVE EXISTING PLAYGROUND EQUIPMENT. DISASSEMBLE AND STORE AT OWNER'S DIRECTION.
- 4 REMOVE EXISTING TREES AND STUMPS TO INDICATED. ALSO, SEE SITE PLAN.
- 5 REMOVE EXISTING FENCING. SALVAGE FOR RE-USE BY OWNER. THE CONTRACTOR SHALL NOT BE REQUIRED TO REMOVE EXISTING CONCRETE FROM FENCE POST.
- 6 REMOVE EXISTING PEDESTAL MAIL BOXES. STORE FOR RE-USE.
- 7 REMOVE EXISTING CONCRETE WALK AND PADS AT ENDS OF BUILDINGS. PROVIDE TOPSOIL AND LANDSCAPE.
- 8 REMOVE EXISTING CONCRETE PADS AT REAR OF UNITS FOR CONSTRUCTION OF PATIO AREAS. PADS PROVIDING A MINIMUM OF 6" IN GRADE CHANGE BETWEEN INTERIOR SLAB AND EXTERIOR PAD MAY REMAIN. REMOVE PORTIONS WHICH INTERFERE WITH NEW PATIO SLABS, BOARD FENCE FOOTINGS OR WHICH EXTEND BEYOND EDGE OF PATIO SLABS.
- 9 REMOVE ALL CLOTHES LINE SUPPORTS AND WIRING AND STORE FOR RE-INSTALLATION. INSTALL ADDITIONAL WIRING AT EYELETS. REMOVE EXISTING CONCRETE FROM CLOTHES LINE POLE. SET POLE IN 8" ROUND POST HOLE AND FILL WITH CONCRETE AFTER COMPLETION OF OTHER WORK REQUIRED AT THIS AREA.

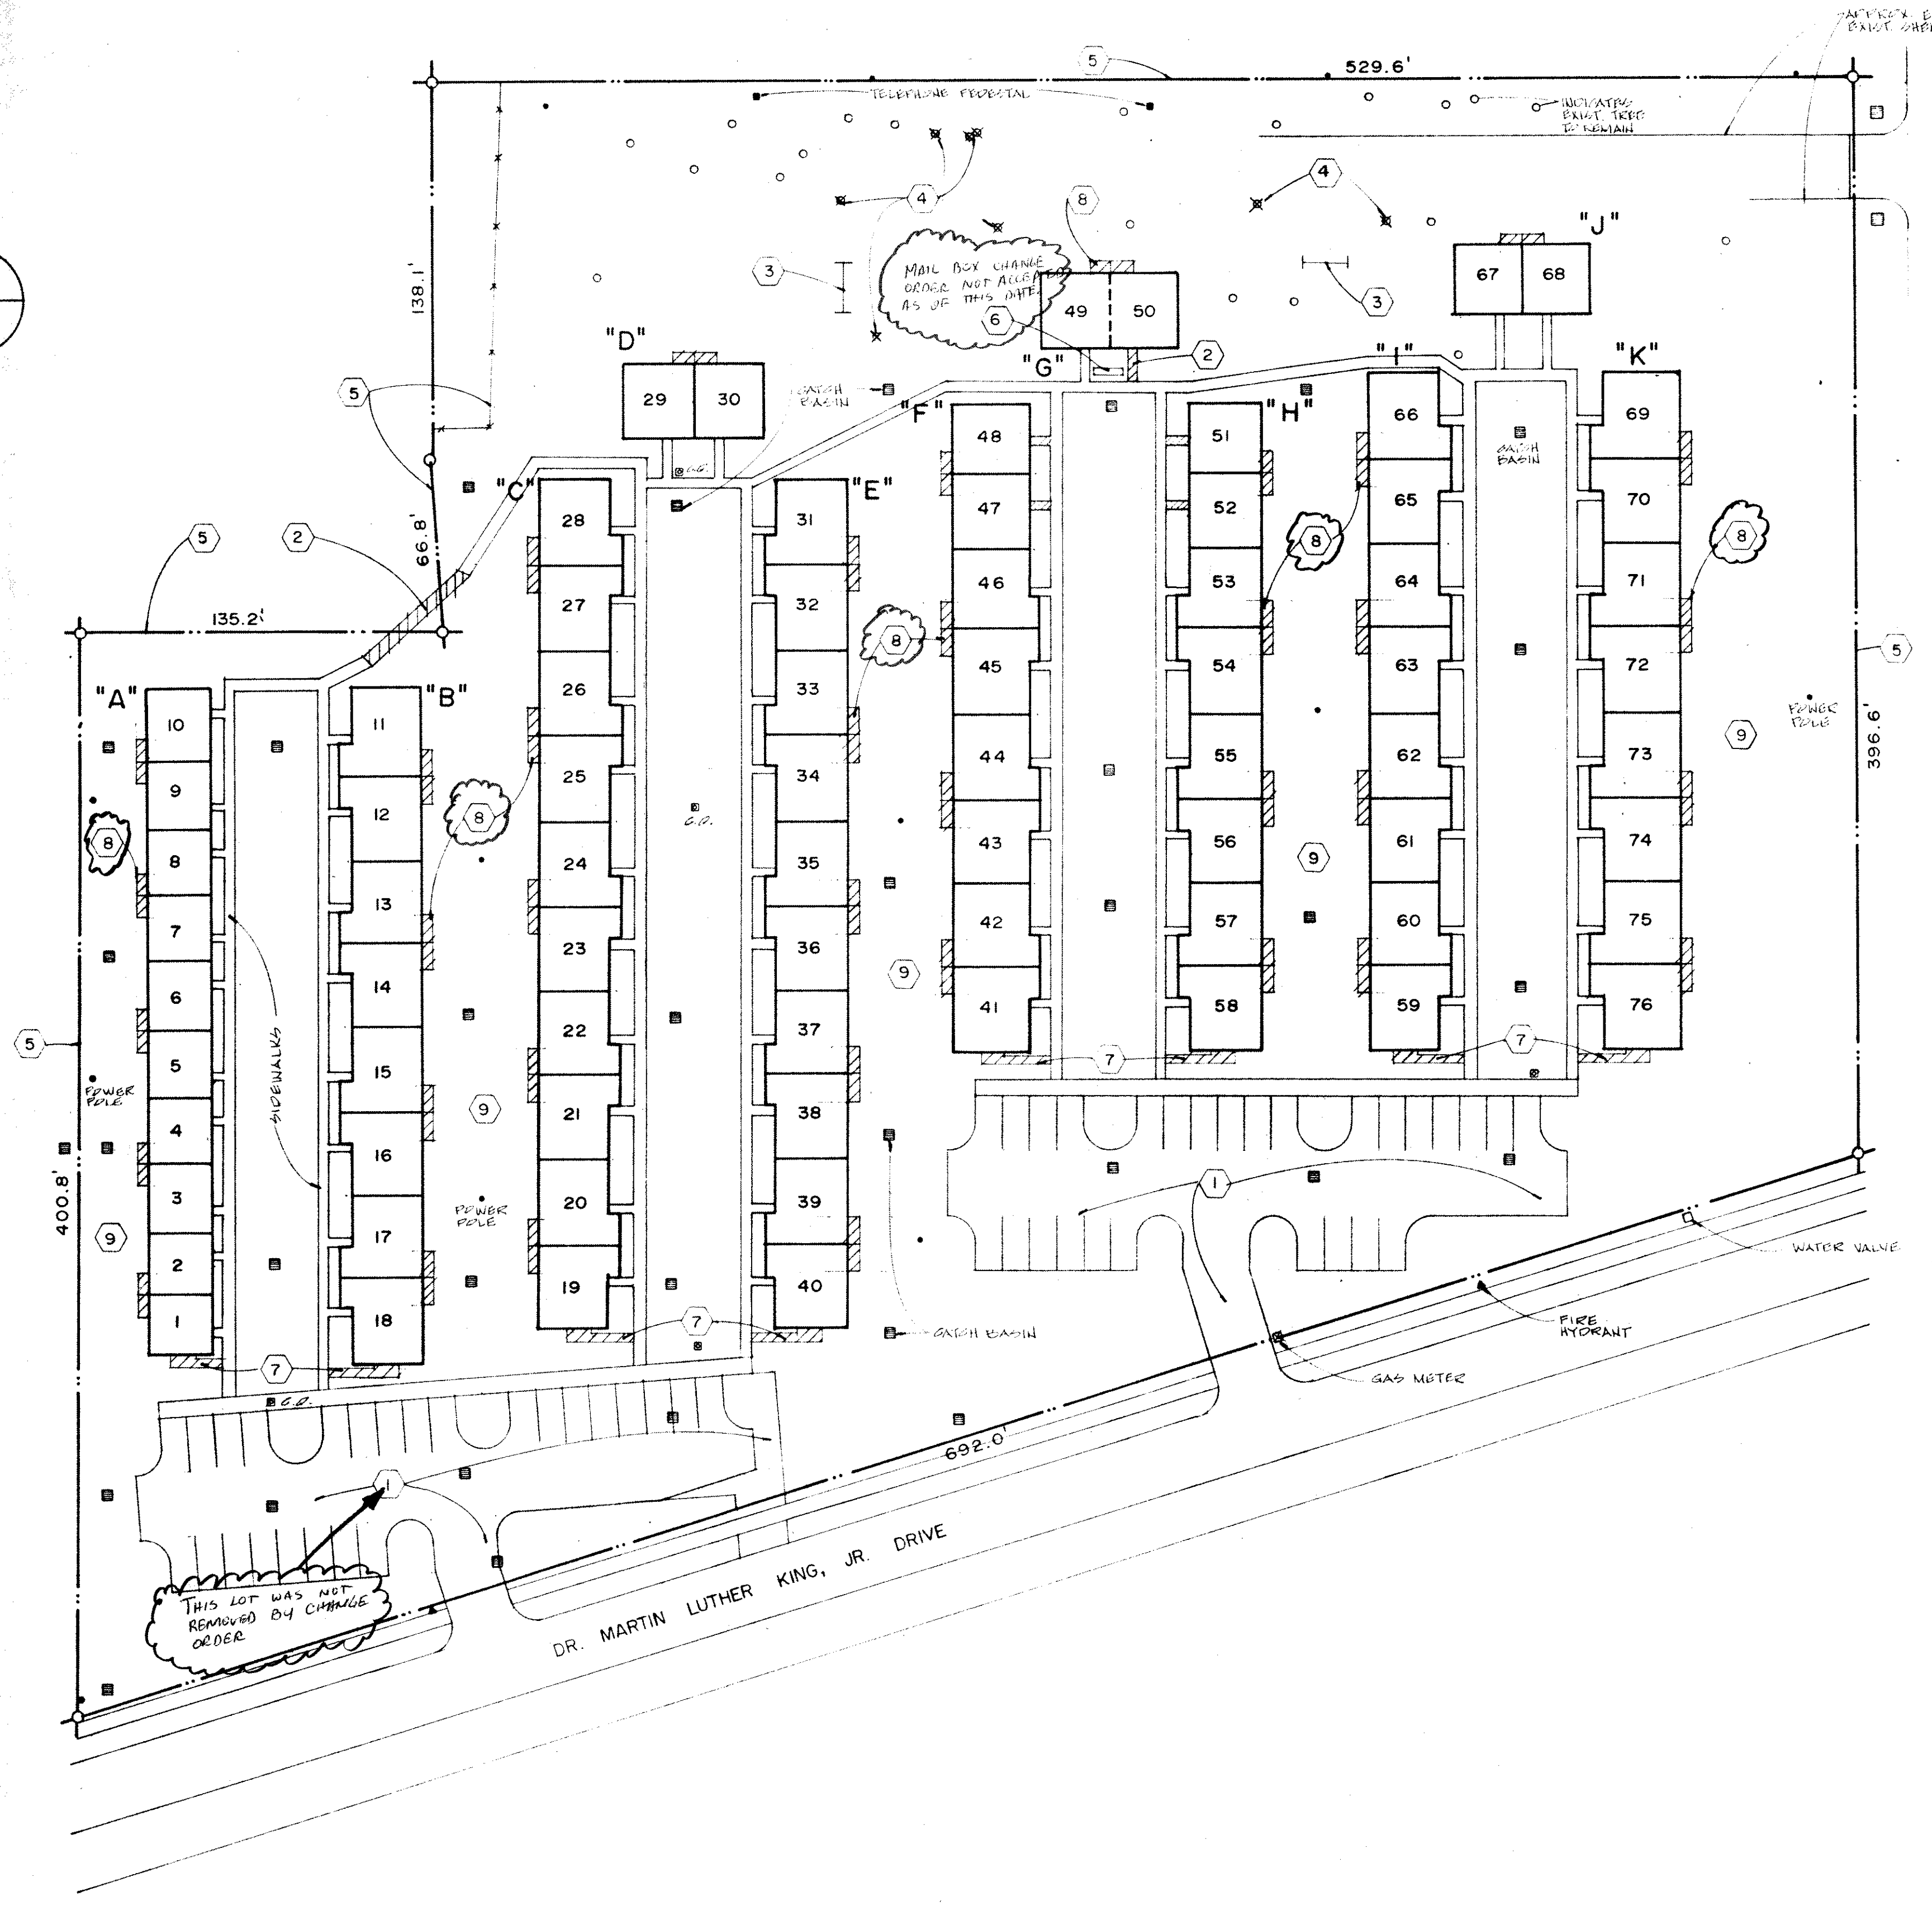

1
 A.3 REMOVAL PLAN

40

CONTRACTOR SHALL BE RESPONSIBLE FOR VERIFYING ALL EXISTING CONDITIONS AND DIMENSIONS BEFORE COMMENCING WORK AND SHALL REPORT ANY DISCREPANCIES TO ARCHITECT.