



**FRANKS ACCURATE BODY SHOP**  
684 E. I-10 SERVICE RD SLIDELL, LA 70461  
PHONE: 985-641-1454 FAX: 985-847-1456  
**FAX SHEET**

**TO:** DAVE


**FAX#:** \_\_\_\_\_ **DATE:** \_\_\_\_\_

**FROM:** FRANK

**COMMENTS:** \_\_\_\_\_

DAVE I CIRCLED THE  
THINGS THAT I CHANGED

FRANK

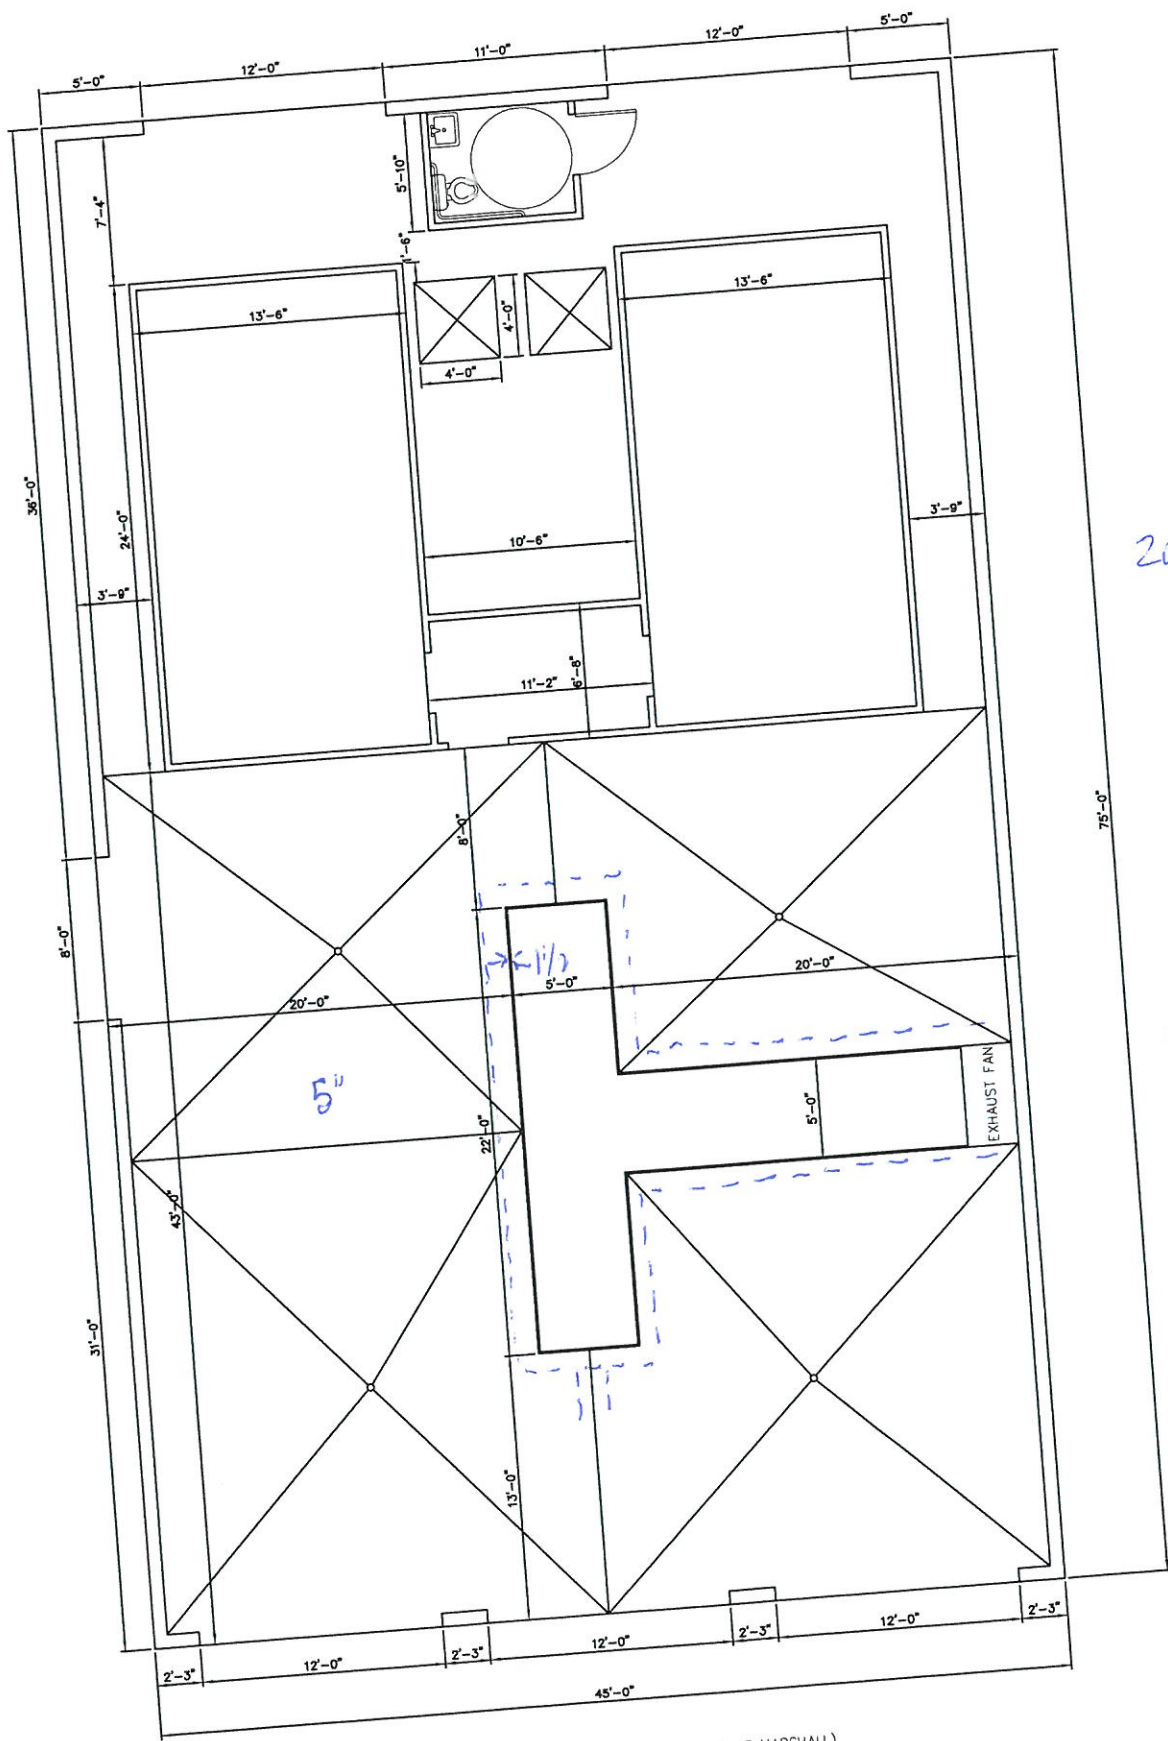

20'

dave@rbbraufman.com

~~rbbraufman.com~~

- LOCATION OF PERSONNEL ACCESS DOOR (FIRE MARCHALL)
- HEIGHT OF BUILDING
- TYPE OF ROOF (GABLE OR SINGLE SLOPE)
- EXTERIOR FINISHES
- LOCATIONS OF ENTRANCE DOORS FOR PAINT BOOTHS
- HEIGHT OF PAINT BOOTH
- SIZE OF EQUIPMENT FOR PAINT BOOTS (PHYSICAL DIMENSIONS)
- LIGHTING & POWER NEEDS
- POWER REQUIREMENTS FOR BOOTHS
- ACCESS AROUND BATHROOM IS TOO TIGHT HOW DO YOU WANT IT RESOLVED?

200 A SVC

64' 4 Skylights on Roof  
(2) 8' Fluor Strips/Bay

