


SITE UTILITIES & ILLUMINATION PLAN
SCALE: 1" = 10'




LEGEND


- - PROPERTY LINE
- - BUILDING SETBACK
- - LANDSCAPING SETBACK MINIMUM AND BUFFER ZONE LIMITS AT REAR
- - NEW BUILDING OUTLINE
- W ----- - NEW WATER LINE
- S ----- - NEW SEWER LINE
- E ----- - NEW POWER LINE
- - SILT FENCING DETAIL
- - NEW DRAIN LINE

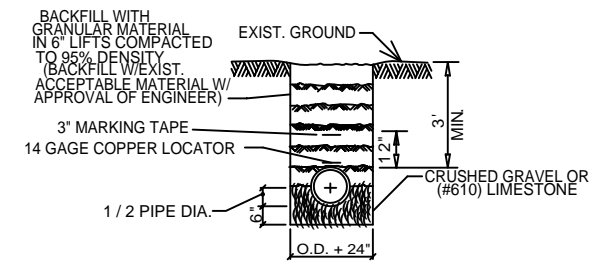

PIPE BEDDING DETAIL FOR SEWER & WATER LINE
N.T.S.

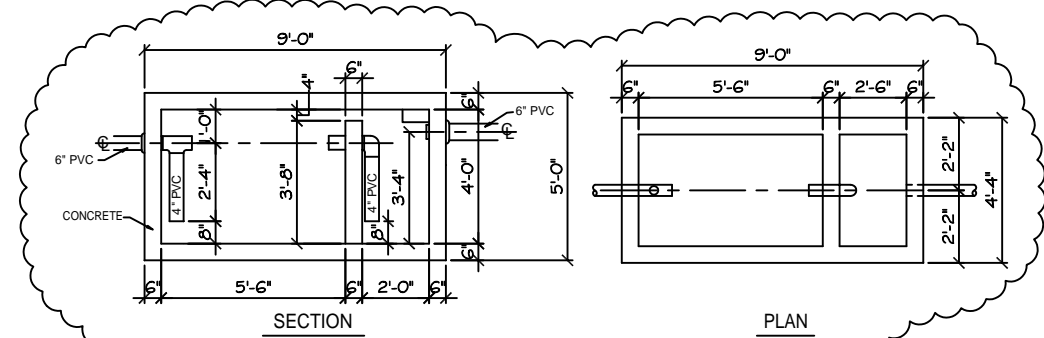

OIL/WATER SEPARATOR
N.T.S.

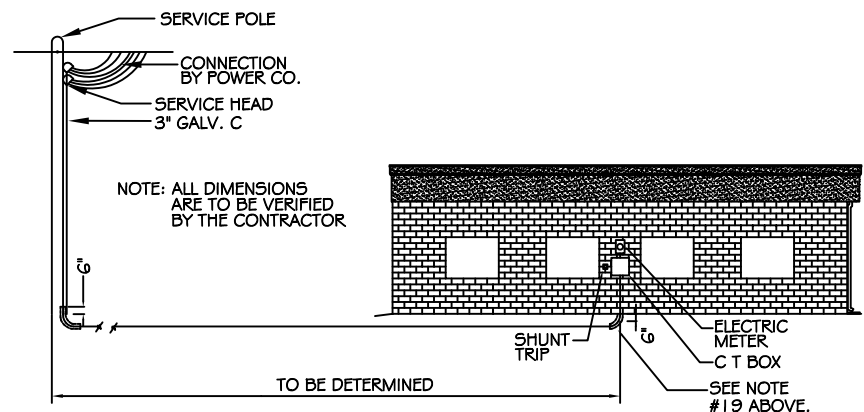

ELECTRICAL SERVICE DETAIL
N.T.S. 208V 3 PHASE

SITE LIGHTING
EXTERIOR LIGHTING SHALL BE SHADED OR INWARDLY DIRECTED IN SUCH A MANNER SO THAT NO DIRECT LIGHTING OR GLARE BE CAST BEYOND THE PROPERTY LINE. THE INTENSITY OF SUCH LIGHTING SHALL NOT EXCEED ONE FOOT CANDLE AS MEASURED AT THE ABUTTING PROPERTY LINE.



DAMMON ENGINEERING, INC.

CHIEF ENGINEER
EMMETT DAMMON, P.E.

CHIEF ARCHITECT
ROBERT WILTSE

1095 FLORIDA AVENUE
SLIDELL, LA. 70458
OFFICE: 985-649-5832
FAX: 985-641-5950

WEBSITE:
WWW.DAMMONENGINEERING.COM

EMAIL:
DAMMONENG@BELLSOUTH.NET

- ARCHITECTURE
- ENGINEERING
- STUDIES
- PLANNING
- INVESTIGATION
- EXPERT WITNESS

CECIL BOYD'S
CAR WASH
LOT 5A
EAST HALL ST.
SLIDELL, LA

SITE
UTILITIES &
ILLUMINATION
PLAN

REV: 09-28-10

SCALE: AS NOTED

JOB#: 2074

DATE: 09-13-10

SHEET 6

C-5

OF 18