

**DAMMON ENGINEERING, INC.**

CHIEF ENGINEER  
EMMETT DAMMON, P.E.

CHIEF ARCHITECT  
ROBERT WILTSE

554 OLD SPANISH TRAIL  
SLIDELL, LA. 70458  
OFFICE: 985-649-5832  
FAX: 985-641-5950

WEBSITE:  
WWW.DAMMONENGINEERING.COM

EMAIL:  
DAMMONENG@BELLSOUTH.NET

ARCHITECTURE  
ENGINEERING  
STUDIES  
PLANNING  
INVESTIGATION  
EXPERT WITNESS

NEW RESIDENTIAL COMMUNITY HOME

STARC WEST  
1705 VIOLA ST.  
MANDEVILLE, LA

BUILDING SECTION

*Robert Wiltse*

REV:

SCALE: AS NOTED


JOB#: 2081

DATE: 04-08-2011

SHEET 6

A-2

OF 17

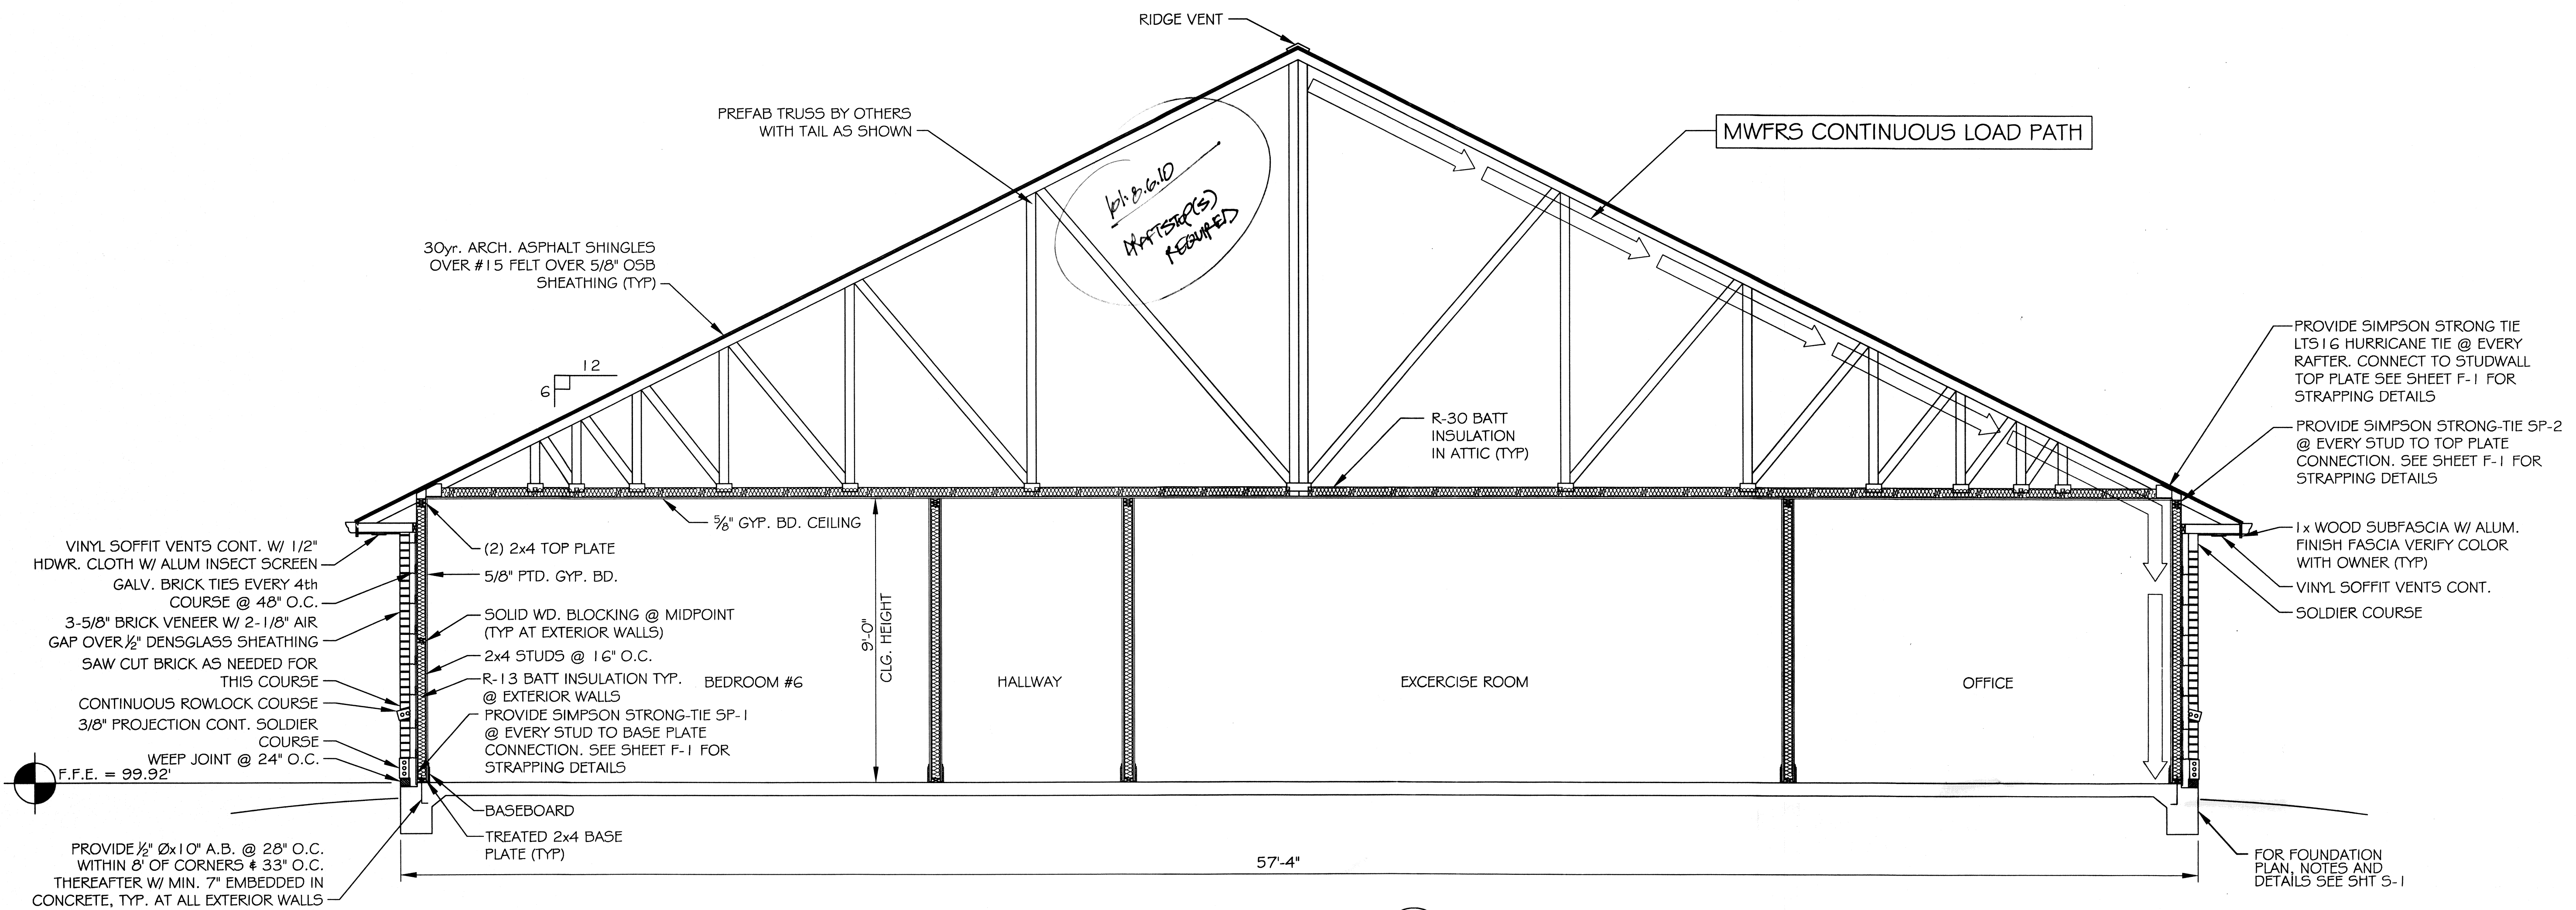

BUILDING SECTION A  
SCALE: 3/8"=1'

**THERMAL COMPONENT CRITERIA (U-FACTOR AND R-VALUE)**

MAX. GLAZING U-FACTOR	MINIMUM INSULATION R-VALUE				
	CEILINGS	WALLS	FLOORS	BASEMENT WALLS	CRAWL SPACE WALLS
.75	R-26	R-13	R-11	R-5	R-5

**MWFRS NOTES**

GENERAL: THE MAIN WIND FORCE RESISTING SYSTEM IS DESIGNED TO TRANSFER THE 33.6 PSF DESIGN WIND FORCE FROM ALL COMPONENTS AND CLADDING OF THE STRUCTURE TO THE FOUNDATION. MWFRS CONSISTS OF A SYSTEM OF APPROPRIATE FASTENERS AND STRAPPING FOR ALL COMPONENTS SUBJECT TO EXTERNAL AND INTERNAL WIND FORCE PRESSURES. SEE SHT. F-1 FOR STRUCTURAL SCHEDULES AND DETAILS.

**WINDBORNE DEBRIS PROTECTION FASTENING SCHEDULE FOR WOOD STRUCTURAL PANELS**

FASTENER TYPE	FASTENER SPACING		
	PANEL SPAN ≤ 4 FOOT	4 FOOT PANEL SPAN ≤ 6 FOOT	6 FOOT PANEL SPAN ≤ 8 FOOT
2-1/2" #6 WOOD SCREWS	16"	12"	9"
2-1/2" #8 WOOD SCREWS	16"	16"	12"

**BRICK LINTEL SCHEDULE**

MAXIMUM CLEAR SPAN	STL. ANGLE SIZE (WxHxD)
≤ 3'-0"	3-1/2" x 3-1/2" x 1/4"
3'-0" <= 4'-0"	3-1/2" x 4" x 1/4"

WINDOWS IN BUILDINGS LOCATED IN WIND BORNE DEBRIS REGIONS SHALL HAVE GLAZED OPENINGS PROTECTED FROM WINDBORNE DEBRIS. WOOD STRUCTURAL PANELS WITH A MIN. THICKNESS OF 7/16" AND A MAX. SPAN OF 8 FEET SHALL BE PERMITTED FOR OPENING PROTECTION IN ONE AND TWO STORY BUILDINGS. PANELS SHALL BE PRECUT TO COVER THE GLAZED OPENINGS WITH ATTACHMENT HARDWARE PROVIDED.

NOTE:  
REQUIRED LENGTH OF BEARING: 6"