


#	DESCRIPTION	DATE

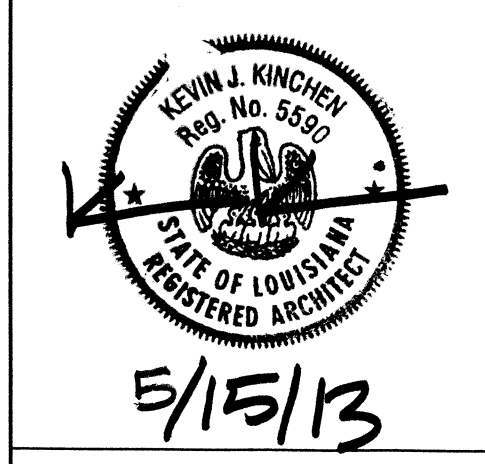

ROOF PLAN

SHEET No: 6 OF 15

A-4

MAY 23 2013
433047
REVIEWED FOR
STATE FIRE MARSHAL
AS PER REVIEW LETTER
BY: JAMAR BARDNER

ROOF PLAN
SCALE: 1/4" = 1'-0"