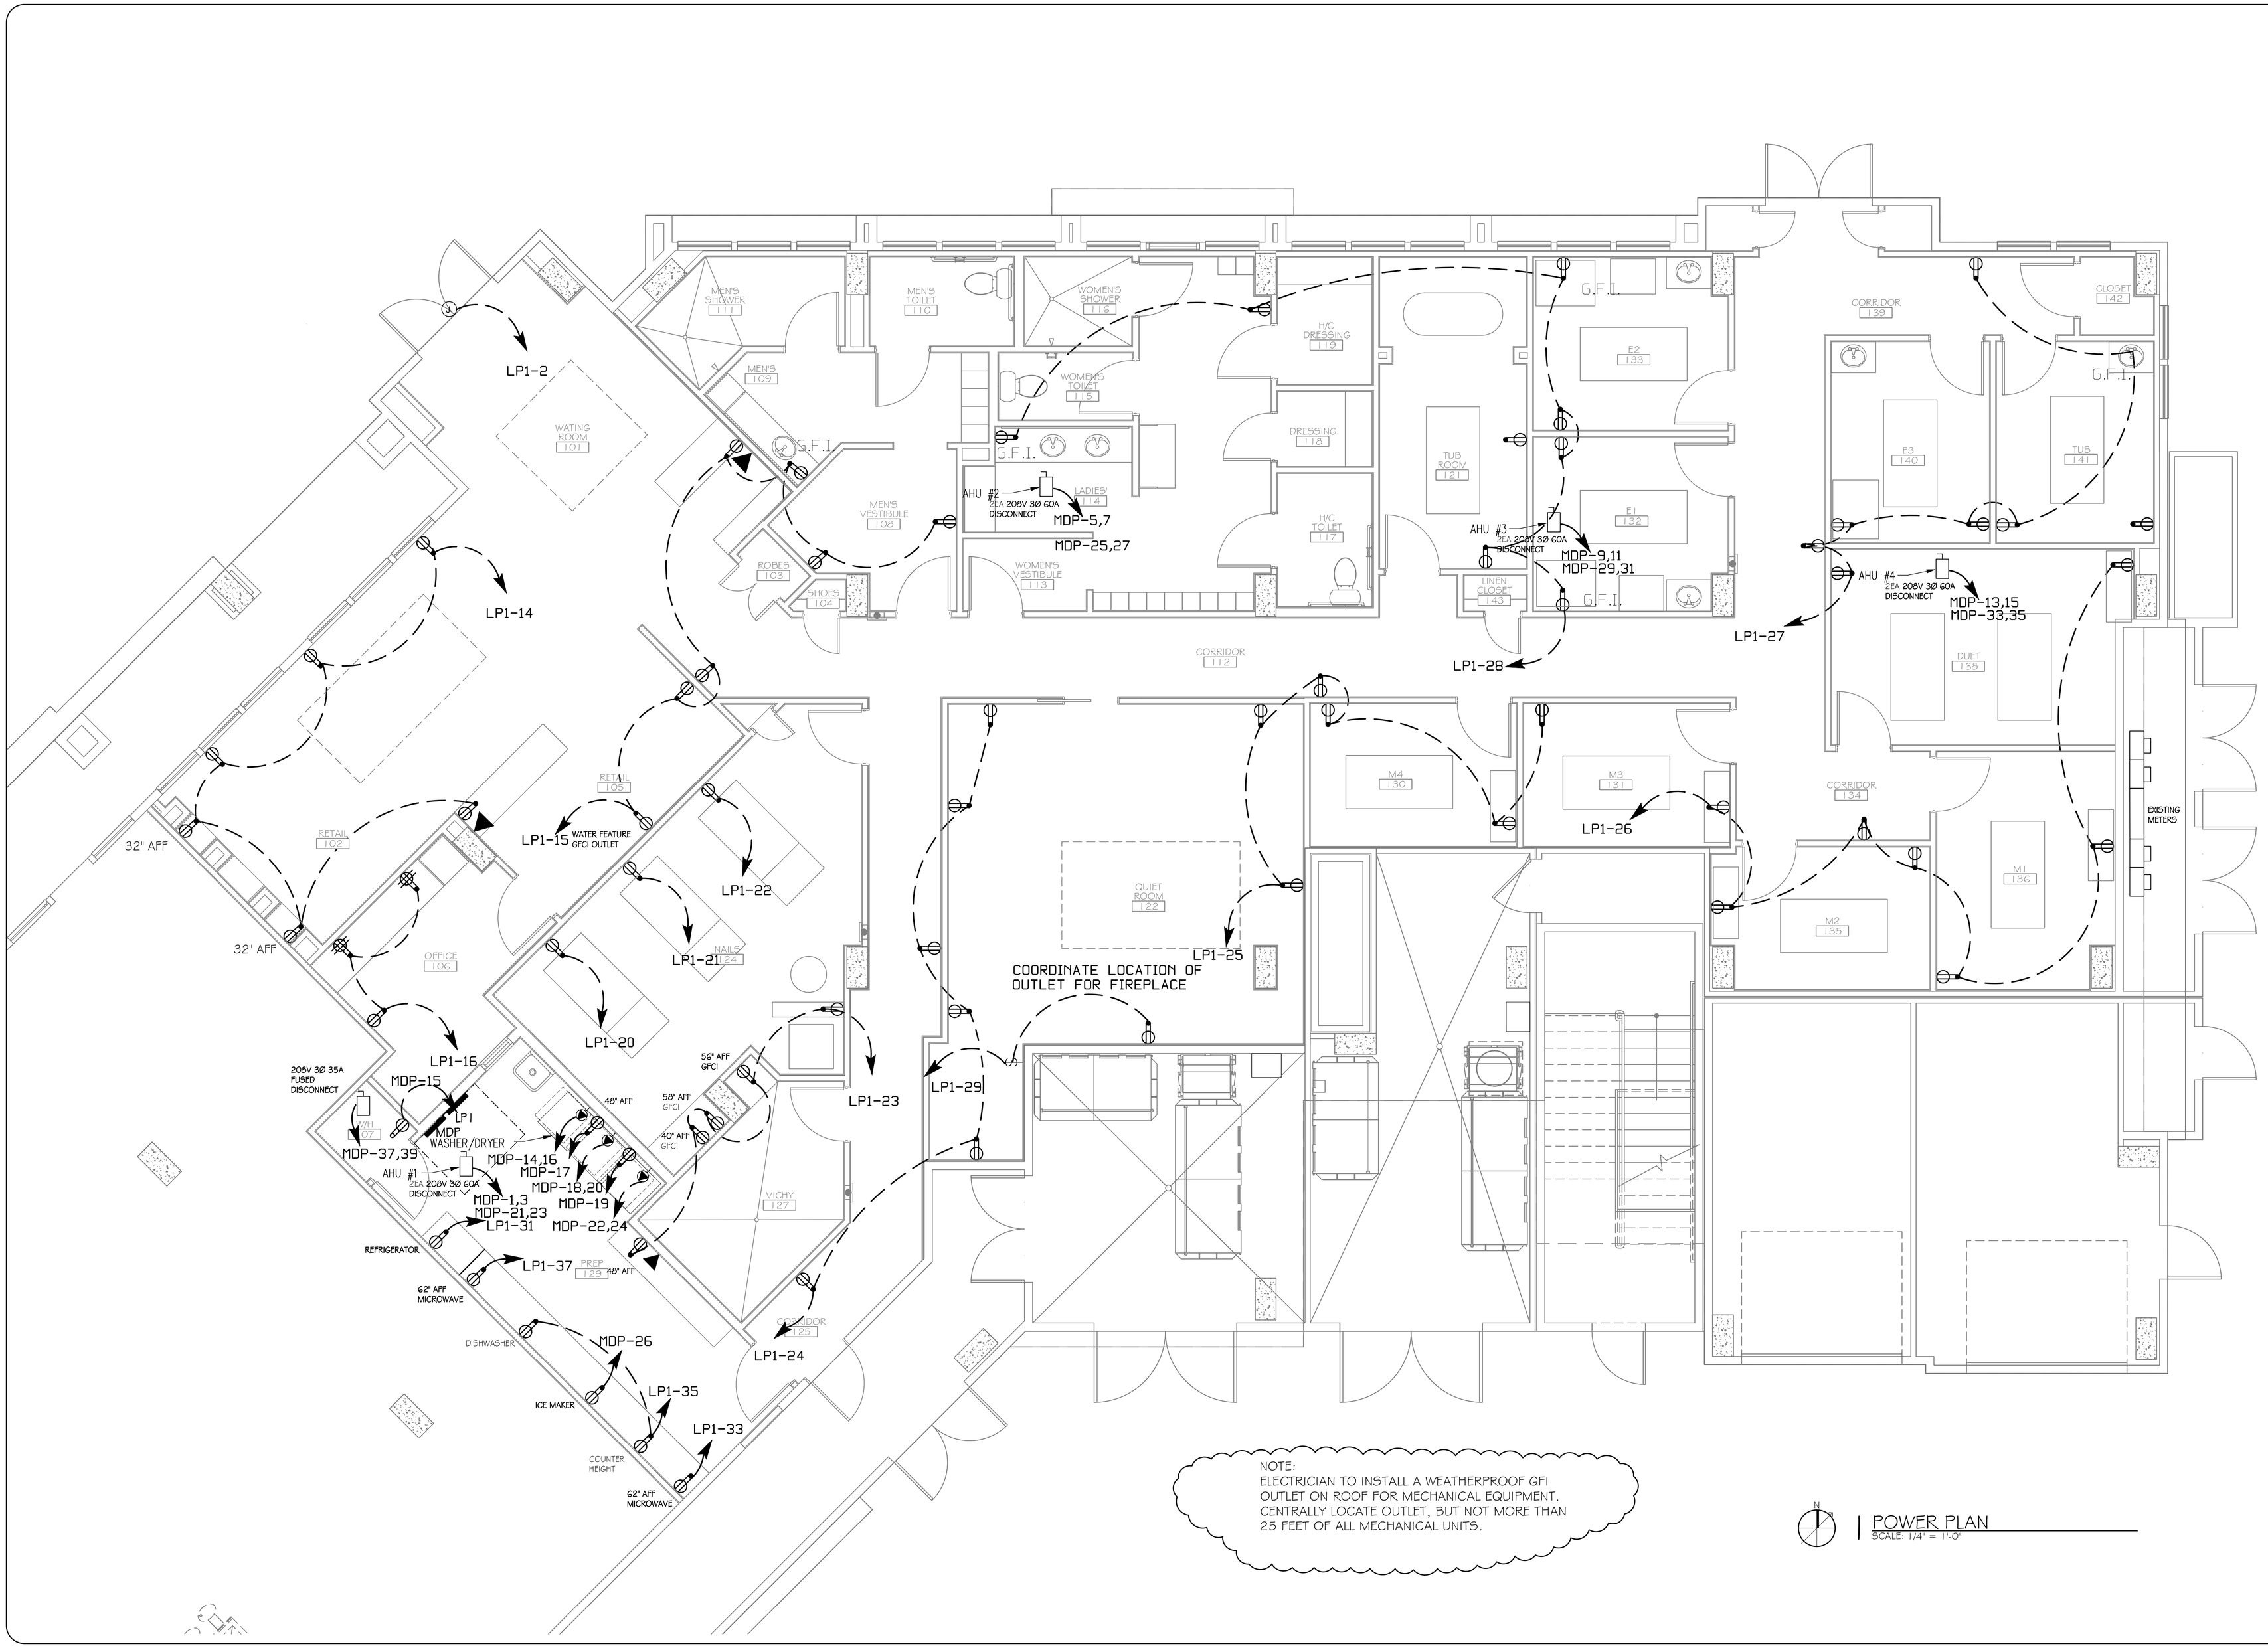

NOTE:
ELECTRICIAN TO INSTALL A WEATHERPROOF GFI OUTLET ON ROOF FOR MECHANICAL EQUIPMENT. CENTRALLY LOCATE OUTLET, BUT NOT MORE THAN 25 FEET OF ALL MECHANICAL UNITS.

1 POWER PLAN
SCALE: 1/4" = 1'-0"

DAMMON ENGINEERING, INC.
Architects & Engineers

CHIEF ENGINEER: EMMETT DAMMON, P.E.
CHIEF ARCHITECT: KEVIN KINCHEN
5544 GOODMAN STREET, SUITE 100
SLIDELL, LA 70458

dammoneng@bellsouth.net
PHONE: 985-649-5832
FAX: 985-641-5950

WOODHOUSE SPA

THE HIGH GROVE APARTMENTS
BATON ROUGE, LA

JOB No:	2163	DATE:	5/14/2013
DRAWN BY:	JCT	CHECKED BY:	KJK

The above drawings and specifications, designs and arrangements represented thereby, are and shall remain the property of the undersigned and shall not be loaned, used or disclosed to others, in whole or in part, for any purpose whatsoever, without the express written consent of the undersigned. The reproduction of these drawings or specifications shall constitute consent and acceptance of these restrictions.

REVISIONS

#	DESCRIPTION	DATE
1	REVISION #1	5/23/2013
2	REVISION #2, ADD HVAC OUTLET	7/29/2013

STATE OF LOUISIANA
EMMETT G. DAMMON, JR.
License No. 8799
PROFESSIONAL ENGINEER
7/29/2013

POWER PLAN

SHEET No: 9 OF 15

E-1